IREDELL COUNTY HEALTH DEPARTMENT

STATESVILLE 704-878-5305 MOORESVILLE 704-664-5281

IMPROVEMENT PERMIT / AUTHORIZATION TO CONSTRUCT / OPERATION PERMIT / EXISTING SYSTEM INSPECTION

PERMIT# 100490 PIN# 4629 71 9059 DATE 6-2-2001

OWNER OR CONTRACTOR PATOKA HOUSING GROUP, LLC PHONE: Business Home (704) 875-0424

ADDRESS 12619 LONGSTOCK CT, HUNTERSVILLE NC 28078

LOCATION US 21S, TR PERTH, TR STATE PARK RD, TL MORRISON FARM RD, TR RED BUD LANE, 1ST LOT ON LEFT

SUBDIVISION ALLENDALE POINT BLOCK / SECTION ____ LOT 39 LOT AREA 0.56 ACRE SITE CLASS PS DESIGN FLOW 360 L.T.A.R. 0.60 GPD/SQ FT

Septic Tank: 1000 Gallons: STB 354 Date 6-9-01

Pump Tank: ____ Gallons: PT ____ Date ____

Pump Make: ____ Model ____ Serial No ____

Nitrification Field: No Fields 1 Square Feet 600 Linear Feet 200

No Lines FOUR Trench Width 36" Max Trench Bottom Depth 36" Gravel Depth 12"

☑ New System ☐ Repair System Type: I. II. III. IV. V. VI

System Description: CONVENTIONAL GRAVITY

Repair System Description: 25% REDUCTION

Maintenance Agreement Required: ☐ Yes ☒ No GRAVITY

☑ House/Mod. Home No. Bedrooms 3

☐ Mobile Home No. Bathrooms 3

☐ Business No. Employees ____

☐ Other ____


☐ Slab ☑ Crawl Space ☐ Basement w/plumbing ☐ Basement wo/plumbing

Water Supply: ☑ Individual ☐ Public ☐ Community WELL


Comments/Conditions: ① CONTACT HEALTH DEPARTMENT AFTER CLEARING & PRIOR TO INSTALLATION TO FLAG DRAINFIELD ② KEEP SYSTEM MINIMUM 100 FEET FROM WELL (.1956(6)(9))

Comments/Conditions: SEPTIC TANK WITH MARKER INSTALLED USING "POLYLOK" FILTER

INITIAL SITE SKETCH

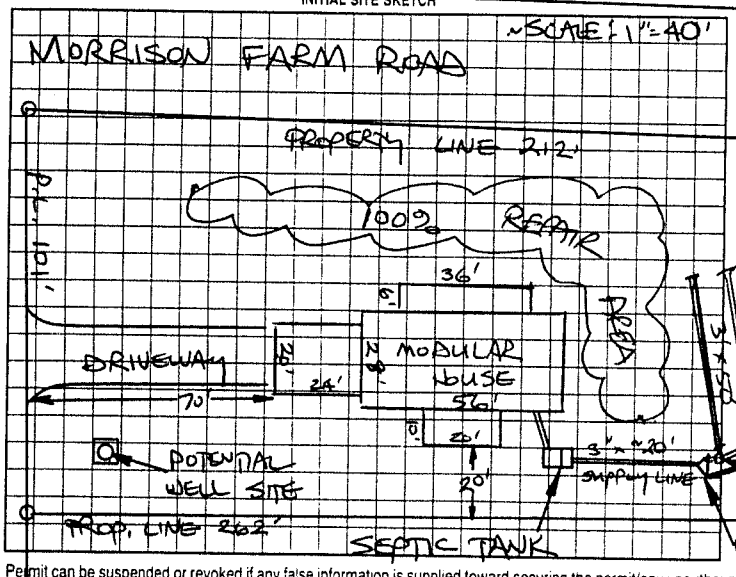

AS BUILT SKETCH

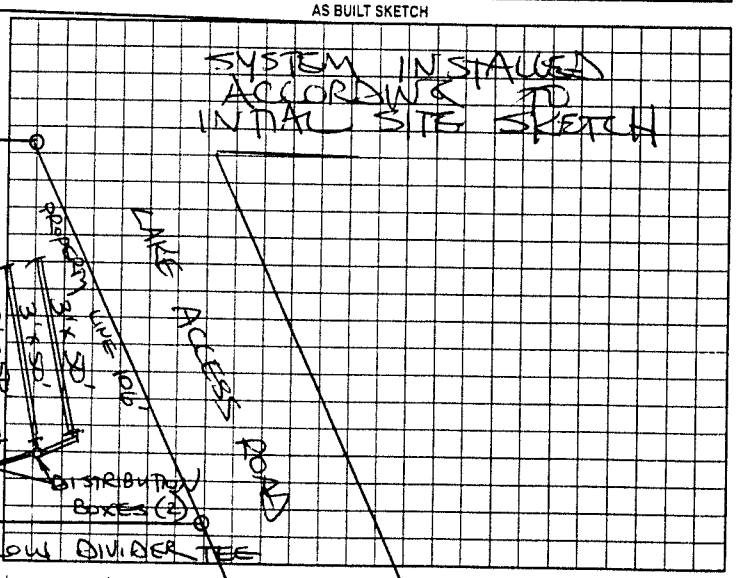

Permit can be suspended or revoked if any false information is supplied toward securing the permit/any unauthorized changes are made to the site/any unauthorized changes are made in the installation of the system. Improvement Permit with plat valid without expiration. Improvement Permit with site plan valid for sixty months. Authorization to Construct is valid for a period equal to that of Improvement Permit – not to exceed sixty months.

Signed: Rhonda Patoka date 6-8-01 Installed by: G & M ENTERPRISES

Improvement Permit by: STEVE HEDRICK date 6-2-2001 Operation Permit by: STEVE HEDRICK date 12-31-01

Authorization to Construct by: STEVE HEDRICK date 6-2-2001 Existing System Inspection by: ____ date ____

HEALTH DEPT. COPY WHITE OWNER COPY (FINAL) YELLOW OWNER COPY (INITIAL) PINK

RED BUD LANE (SR 1406)