IREDELL COUNTY HEALTH DEPARTMENT

STATESVILLE 704-878-5305 MOORESVILLE 704-664-5281

IMPROVEMENT PERMIT / AUTHORIZATION TO CONSTRUCT / OPERATION PERMIT / EXISTING SYSTEM INSPECTION

PERMIT# 15782-8/2018 PIN# Tax map 3C -6- 846 DATE 8-3-99

OWNER OR CONTRACTOR Integrity Homes PHONE: Business 528-3320 Home

ADDRESS Trautman N.C. 28215

LOCATION Morrison Rm on Rt at Jct of Penicillin Pt.

SUBDIVISION Lake Norman BLOCK / SECTION 17 LOT 846 LOT AREA .95 acres SITE CLASS P5 DESIGN FLOW 360 L.T.A.R. .3

Septic Tank: 1000 Gallons; STB 160 Date 6-18-99
Pump Tank: Gallons; PT Date
Pump Make: Model Serial No.
Nitrification Field: No. Fields 1 Square Feet 900 Linear Feet 300
No. Lines 3 Trench Width 36" Max Trench Bottom Depth 36" Gravel Depth N/A

☑ New System ☐ Repair System Type: I, II, III, IV, V, VI
System Description: Gravity 25% Rdn.
Repair System Description: " " "
Maintenance Agreement Required: ☐ Yes ☐ No

☑ House/Mod. Home No. Bedrooms 3
☐ Mobile Home No. Bathrooms 2
☐ Business No. Employees
☐ Other


☐ Slab ☐ Crawl Space ☐ Basement w/plumbing ☑ Basement wo/plumbing

Water Supply: ☑ Individual ☐ Public ☐ Community


Comments/Conditions:
Penicillin Pt

Comments/Conditions
Replace Permit issued 12-17-96
Home location was changed + basement added

INITIAL SITE SKETCH

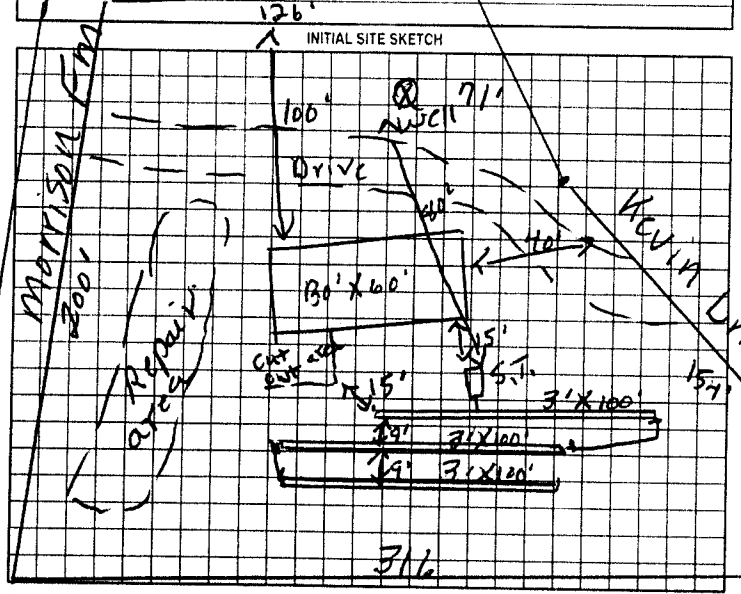

AS BUILT SKETCH

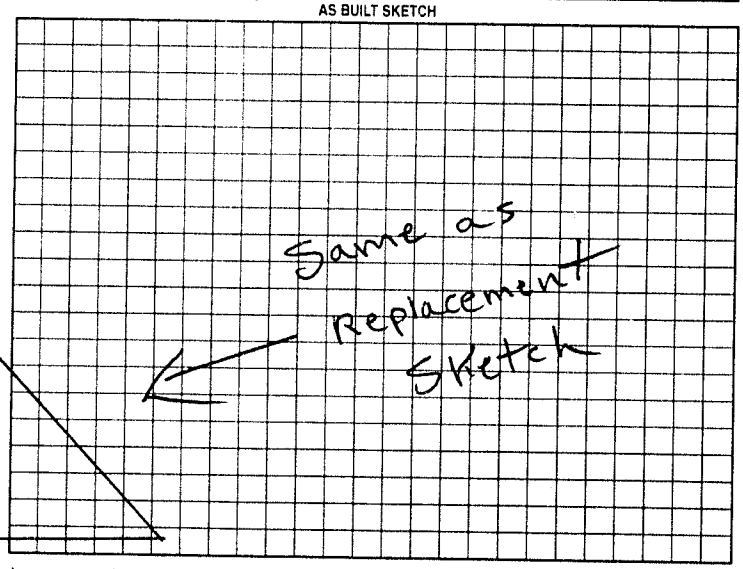

Permit can be suspended or revoked if any false information is supplied toward securing the permit/any unauthorized changes are made to the site/any unauthorized changes are made in the installation of the system. Improvement Permit with plat valid without expiration. Improvement Permit with site plan valid for sixty months. Authorization to Construct is valid for a period equal to that of Improvement Permit, - not to exceed sixty months.

Signed: Mary Wrigley date 8.4.99
Improvement Permit by: R. C. Moore date 8-3-99
Authorization to Construct by: R. C. Moore date 8-3-99

Installed by: Kelly Wark Alex. Co.
Operation Permit by: R. C. Moore date 8-9-99
Existing System Inspection by: date

HEALTH DEPT COPY: WHITE OWNER COPY (FINAL): YELLOW OWNER COPY (INITIAL): PINK