IREDELL COUNTY HEALTH DEPARTMENT

STATESVILLE 704-878-5305 MOORESVILLE 704-664-5281

IMPROVEMENT PERMIT / CERTIFICATE OF COMPLETION / OPERATION PERMIT / EXISTING SYSTEM INSPECTION

PROPERTY DESCRIPTION NO. 25782 DATE 12-17-96 TAX MAP NO. 3C-6-846 Watershed: [x] Yes [ ] No WS IV-CA

OWNER OR CONTRACTOR Crescent Resources PHONE: Business 663 6905 Home 528 3320 Jim

ADDRESS 400 S Tryon St.

LOCATION Morrison Fm Rd on rt at Jct of Penicillin Pt.

SUBDIVISION Lake Norman BLOCK / SECTION 17 LOT 846 LOT AREA .95 acres SITE CLASS ______ DESIGN FLOW ______ L.T.A.R. .3

Septic Tank: 1000 Gallons; STB 160 Date 6-18-99

Pump Tank: ______ Gallons; PT ______ Date ______

Pump Make: ______ Model ______ Serial No. ______

Nitrification Field: No Fields 1 Square Feet 900 Linear Feet 300

No Lines 3 Trench Width 36" Max Trench Bottom Depth 36" Gravel Depth N/A

[x] New System [ ] Repair System Type: I, II, (III), IV, V, VI

System Description: Gravity Chambers

Repair System Description: " "

Maintenance Agreement Required: [ ] Yes [x] No

[x] House/Mod. Home [ ] Mobile Home [ ] Business [ ] Other ______

No. Bedrooms 3 No. Bathrooms 2 No. Employees ______


[x] Slab [ ] Crawl Space [ ] Basement w/plumbing [ ] Basement wo/plumbing

Water Supply: [x] Individual [ ] Community [ ] Public

Comments:

Comments:

INITIAL SITE SKETCH

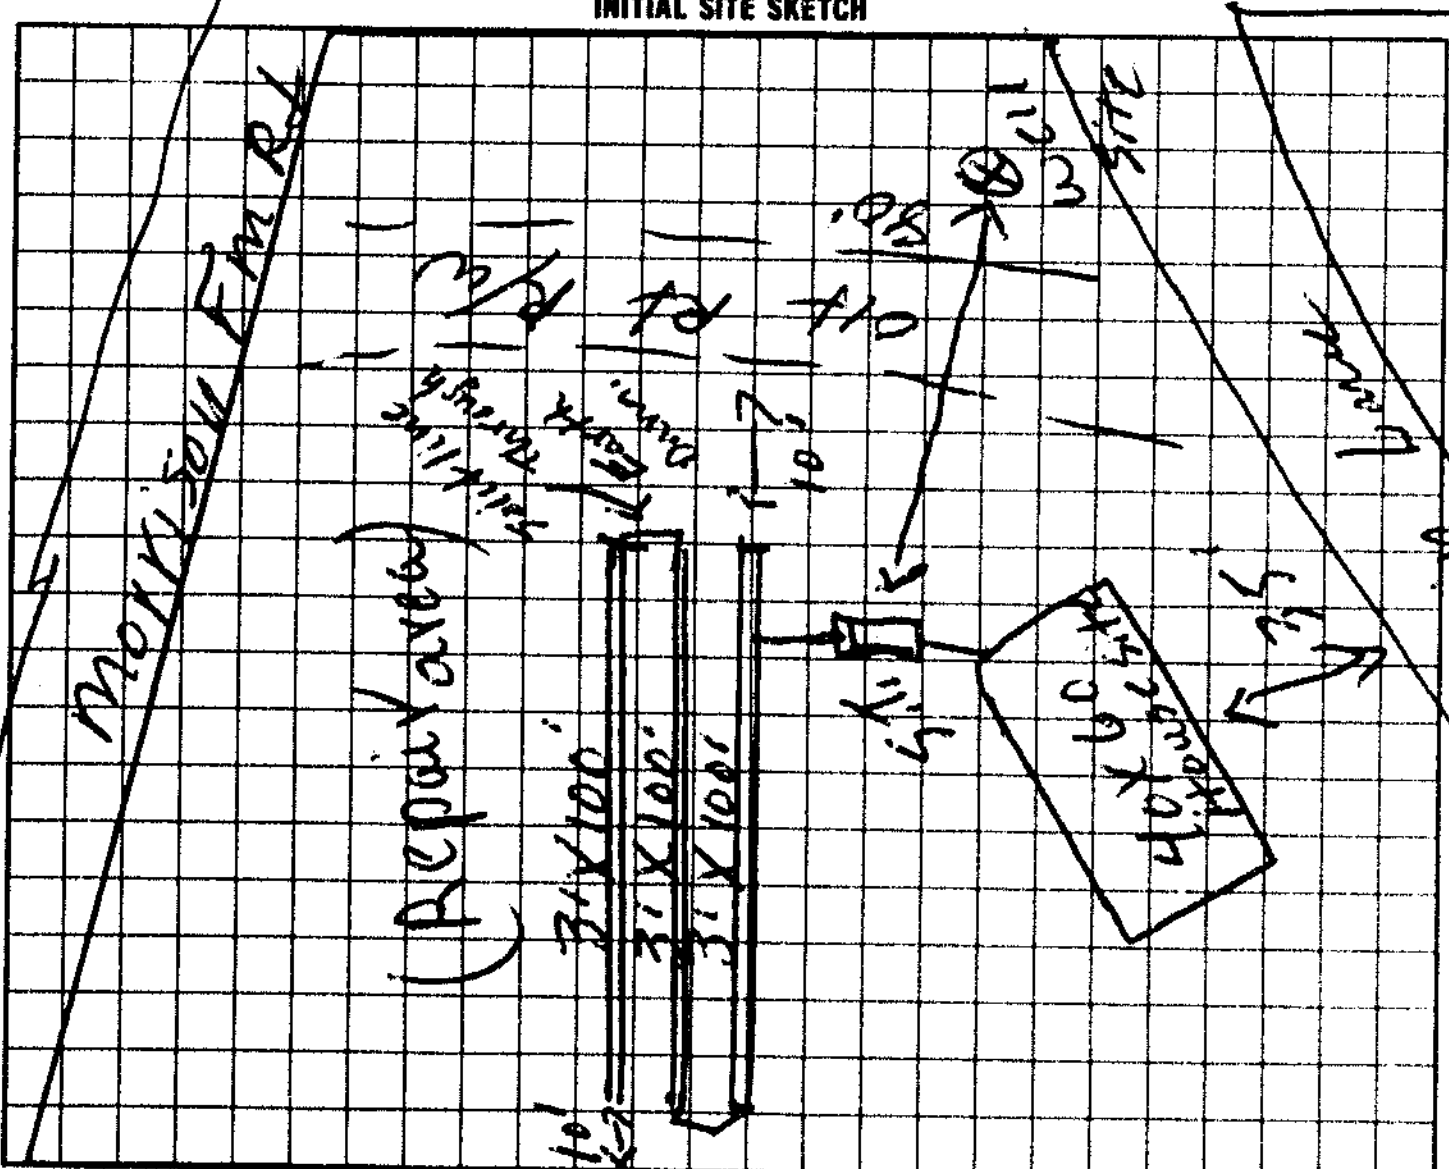

AS BUILT SKETCH

I understand that this permit can be suspended or revoked if any false information is supplied toward securing the permit/any unauthorized changes are made to the site/any unauthorized changes are made in the installation of the system. Improvement Permit is valid for 60 months from date of issuance.

Signed: Tony Cagavis CPSS 12-18-96

Improvement Permit by: L. C. Moore date 12-17-96

Authorization to Constr. by: L. C. Moore date 12-17-96

Installed by: ______

Certificate of Completion by: ______ date ______

Operation Permit by: ______ date ______

HEALTH DEPT. COPY: WHITE INSPECTION COPY (FINAL): GREEN OWNER COPY (FINAL): YELLOW INSPECTION COPY (INITIAL): PINK OWNER COPY (INITIAL): GOLD

Authorization to Const. Expires 60 mos from issue