J+D Remodel

IREDELL COUNTY HEALTH DEPARTMENT

THIS PERMIT VOIDS PREVIOUS ISSUED 202206

STATESVILLE 704-878-5305 MOORESVILLE 704-664-5281

IMPROVEMENT PERMIT / AUTHORIZATION TO CONSTRUCT / OPERATION PERMIT / EXISTING SYSTEM INSPECTION

PERMIT# 0699981 PIN# 4629 72 8987

OWNER OR CONTRACTOR DALLAS LYALLS PHONE: Business Home (336) 924-5753 DATE 4-6-98

ADDRESS 5636 BETHANIA ROAD, PFAFFTOWN, NC

LOCATION US 215, TR NORTH, TR STATE PARK, TL MORRISON FARM, TL WILLOW POINT, TR CROMDALE, 3RD LT ON LEFT

SUBDIVISION CL & T BLOCK / SECTION 17 LOT 32 LOT AREA 0.80 ACRE SITE CLASS. PS DESIGN FLOW 360 L.T.A.R. 0.33 GAD/FT²

Septic Tank: 1000 Gallons; STB 1012 Date 3-3-98

Pump Tank: _____ Gallons; PT _____ Date _____

Pump Make: _____ Model _____ Serial No. _____

Nitrification Field: No. Fields 1 Square Feet 1080 Linear Feet 360

No Lines FOUR Trench Width 36" Max Trench Bottom Depth 36" Gravel Depth 12"

☑ New System ☐ Repair System Type: I, II, III, IV, V, VI

System Description: CONVENTIONAL GRAVITY

Repair System Description: MAX. FEASIBLE/PERIOD

Maintenance Agreement Required: ☐ Yes ☑ No

☑ House/Mod. Home ☐ Mobile Home ☐ Business ☐ Other

No. Bedrooms 3 No. Bathrooms 2 No. Employees _____


☐ Slab ☑ Crawl Space ☐ Basement w/plumbing ☐ Basement wo/plumbing

Water Supply: ☑ Individual ☐ Public ☐ Community WELL

Comments:/Conditions: ① INSTALL SYSTEM AS FLAGGED ON SITE
② KEEP SYSTEM MINIMUM 100' FROM WELL

Comments:/Conditions:

INITIAL SITE SKETCH

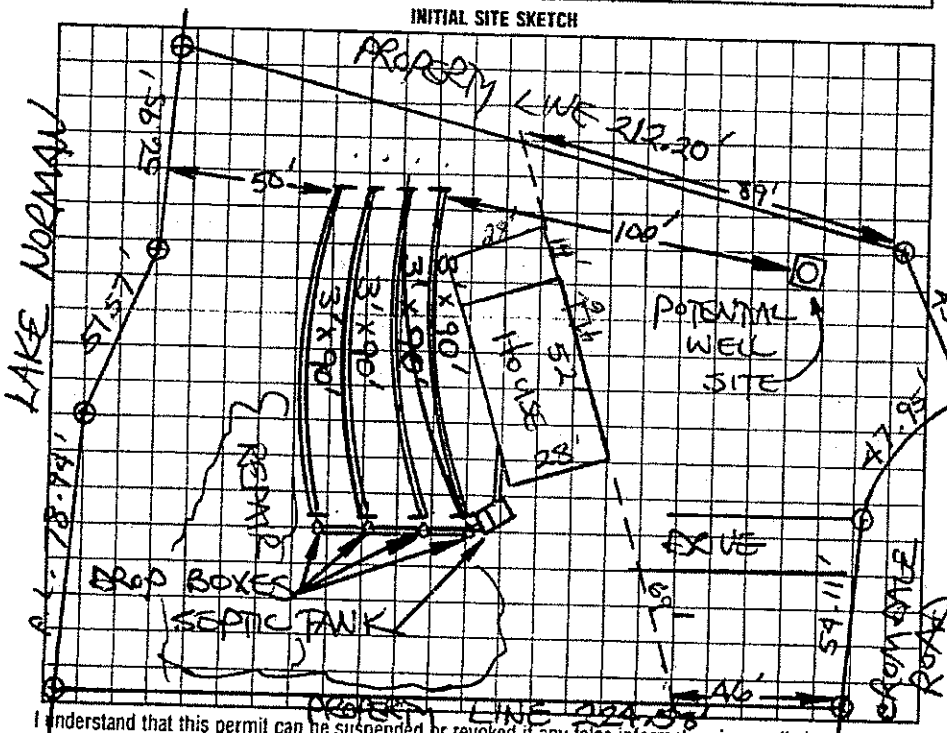

AS BUILT SKETCH

Location of the proposed 14'x28' Living room 4'x6' Deck addition does not appear to impact the existing on-site septic system or well.**NOTE:

David H. Jones REHS Date: 03/18/14

ICHD-Environmental Health Division

I understand that this permit can be suspended or revoked if any false information is supplied toward securing the permit/any unauthorized changes are made to the site/any unauthorized changes are made in the installation of the system. Improvement Permit with plat valid without expiration. Improvement Permit with site plan valid for sixty months. Authorization to Construct is valid for a period equal to that of Improvement Permit – not to exceed sixty months.

Signed: X Dallas Lyalls date 4/6/98

Improvement Permit by: STEVE HEDRICK date 4-6-98

Authorization to Construct by: STEVE HEDRICK date 4-6-98

Installed by: Steve Jordan

Operation Permit by: Mark C. Offord date 5-12-98

Existing System Inspection by: _____ date _____

HEALTH DEPT. COPY: WHITE INSPECTION COPY (FINAL): GREEN OWNER COPY (FINAL): YELLOW INSPECTION COPY (INITIAL): PINK OWNER COPY (INITIAL): GOLD