IREDELL COUNTY HEALTH DEPARTMENT

Statesville Office (704) ~~878-5805~~ Mooresville Office (704) 660-3625 PERMIT # [redacted] ✓ 214917

IMPROVEMENT PERMIT / AUTHORIZATION TO CONSTRUCT / OPERATION PERMIT / EXISTING SYSTEM

PIN # 4629739924

APPLICANT: Livewell Homes APPLICANT ADDRESS: 501 Springcrest Dr.

SITE ADDRESS: 628 Stillwater Rd. PHONE: 704-578-4951 ALT. PHONE: N/A

SITE DIRECTIONS: State Park Rd to Morrison Farm Rd TL Stillwater Rd. Lot on Right

SUBDIVISION: Falls Park SECTION: 3A LOT # 34 LOT AREA: 1.93acres DESIGN FLOW: 600gpd L.T.A.R.: 0.03

Septic Tank 1500 (gal) STB 338 Date 5-2-16
Pump Tank N/A (gal) PT N/A Date N/A
Pump Make N/A Model PA/bll Serial # PL-64
Nitrification Fields 1 # Lines 5 Linear Ft: 500
Trench Width 36" Max. Trench Bottom Depth 36" Gravel Depth N/A

☑ New System ☐ Repair ☐ Expansion System Type: I II ⓘ IV V VI
System Description: 25% Reduction
Repair System Description: Conventional
Maintenance Agreement Required: ☐ YES ☑ NO
☐ GRAVITY ☐ PRESSURE

☑ Residence ☐ Business ☐ Other ☐ Slab ☐ Basement w/plumbing
No. Bedrooms 5 No. Persons 10 No. Employees ☑ Crawl Space

Water Supply: ☐ Private ☑ Public ☐ Community
☐ Basement w/o plumbing

Comments / Conditions: Install trench bottoms @ 36" on high side ✓

INITIAL SITE SKETCH

See attached design by:
Kathleen Saunders, LSS

AS BUILT SKETCH

Installed Quick 4
as drawn

Permit can be suspended or revoked if any false information is supplied toward securing the permit / any unauthorized changes are made to the site / any unauthorized changes are made in the installation of the system. **CONTACT A LOCATOR SERVICE PRIOR TO ANY EXCAVATION**

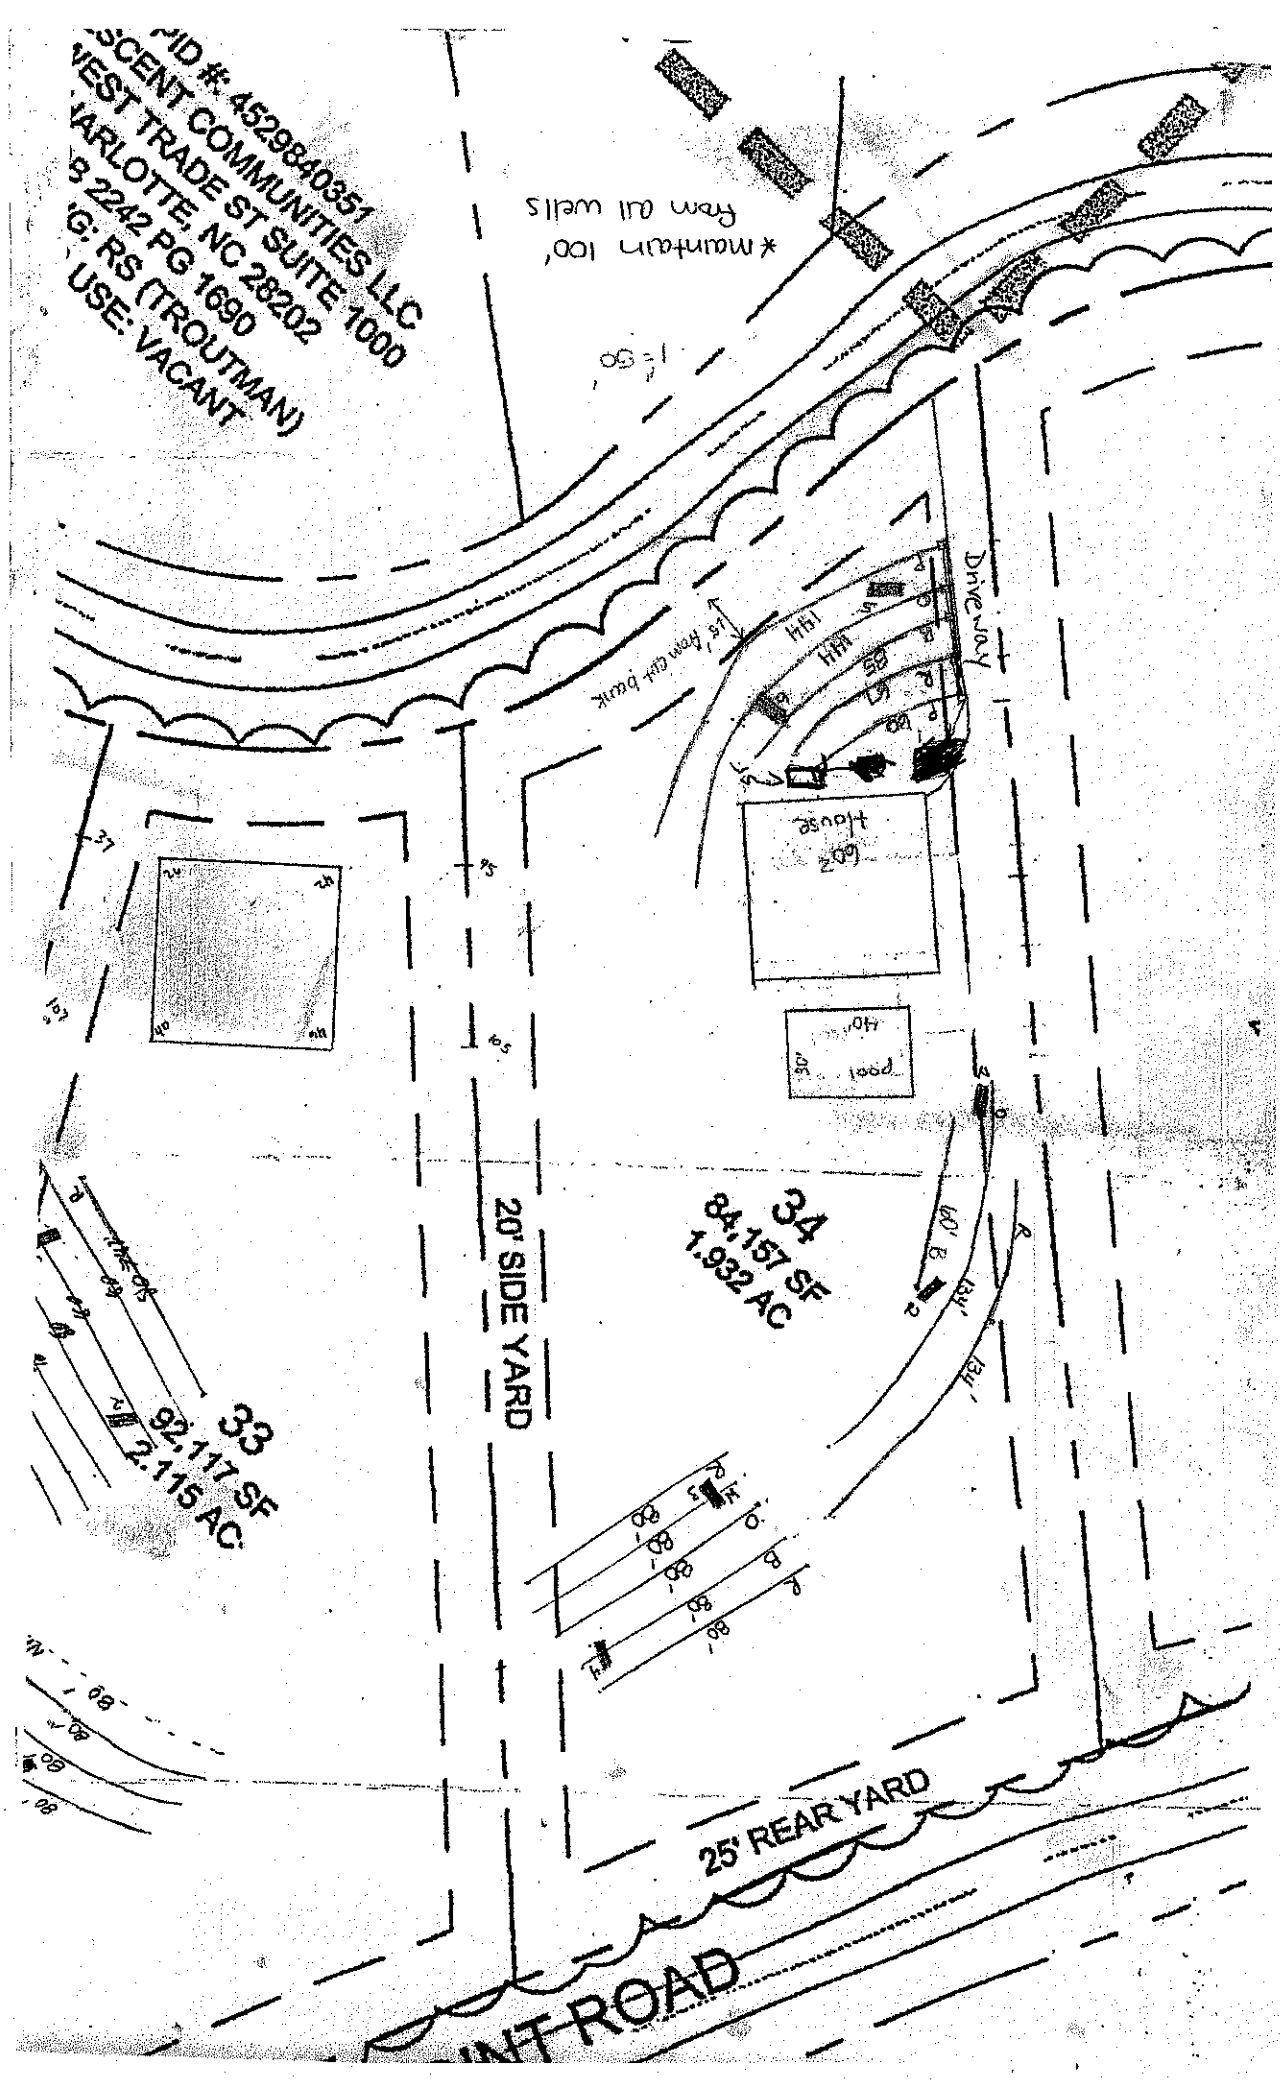
☐ **IMPROVEMENT PERMIT** *with plat valid without expiration.* ☑ **IMPROVEMENT PERMIT** *with site plan valid for 60 mos.* ☐ **AUTHORIZATION TO CONSTRUCT** *valid for period equal to IMPROVEMENT PERMIT--not to exceed 60 mo.*

Owner / Applicant Signature: [signature] Date: 11-5-15 Installed by: Wesson Septic

IMPROVEMENT PERMIT by: Justin Henderson Date: 10-30-15 OPERATION PERMIT by: [signature] Date: 07/01/16

AUTHORIZATION TO CONSTRUCT by: Justin Henderson Date: 10-30-15 Existing System Inspected by: Date:

Health Dept. Copy - WHITE Applicant (Final Approval) - YELLOW Applicant (Conditional Approval) - PINK


PID #: 4529840351
CRESCENT COMMUNITIES LLC
WEST TRADE ST SUITE 1000
CHARLOTTE, NC 28202
DB 2242 PG 1690
ZONING: RS (TROUTMAN)
USE: VACANT
* Maintain 100' from all wells
Drive way
house
pool
20' SIDE YARD
34
84,151 SF
1.932 AC
33
92,117 SF
2.115 AC
25' REAR YARD
NT ROAD