IREDELL COUNTY HEALTH DEPARTMENT

Statesville Office (704) 878-5305 Mooresville Office (704) 660-3625 PERMIT # 219485

IMPROVEMENT PERMIT / AUTHORIZATION TO CONSTRUCT / OPERATION PERMIT / EXISTING SYSTEM

PIN # 4629-74-6073

APPLICANT: FALLS PARK LLC APPLICANT ADDRESS: 501 SPRING CREST DR. FORT MILL

SITE ADDRESS: 115 WILLOW POINT RD. TROUTMAN PHONE: 704-578-4951 ALT. PHONE:

SITE DIRECTIONS: STATE PARK, TL MORRISON FARM, TL WILLOW POINT

SUBDIVISION: FALLS PARK SECTION: 3A LOT # 33 LOT AREA: 2.115 AC DESIGN FLOW: 480 L.T.A.R.: .3

Septic Tank 1000 (gal) STB 338 Date 10-31-16

Pump Tank 1500 (gal) PT Date

Pump Make Model Serial #

Nitrification Fields 1 # Lines 5 Linear Ft: 400'

Trench Width 36" (Max) Trench Bottom Depth 24" Gravel Depth —

☒ New System ☐ Repair ☐ Expansion System Type: I II (III) IV V VI

System Description: 25% REDUCTION

Repair System Description: SAME

Maintenance Agreement Required: ☐ YES ☒ NO

☒ GRAVITY ☐ PRESSURE

☒ Residence ☐ Business ☐ Other ☐ Slab ☐ Basement w/plumbing

No. Bedrooms 4 No. Persons 8 No. Employees

☒ Crawl Space ☐ Basement w/o plumbing

Water Supply: ☐ Private ☐ Public ☒ Community

Comments / Conditions:

INITIAL SITE SKETCH

SEE PLAN FROM THE OAKS GROUP

AS BUILT SKETCH

Used Quick 4
Installed as Drawn

Permit can be suspended or revoked if any false information is supplied toward securing the permit / any unauthorized changes are made to the site / any unauthorized changes are made in the installation of the system. **CONTACT A LOCATOR SERVICE PRIOR TO ANY EXCAVATION**

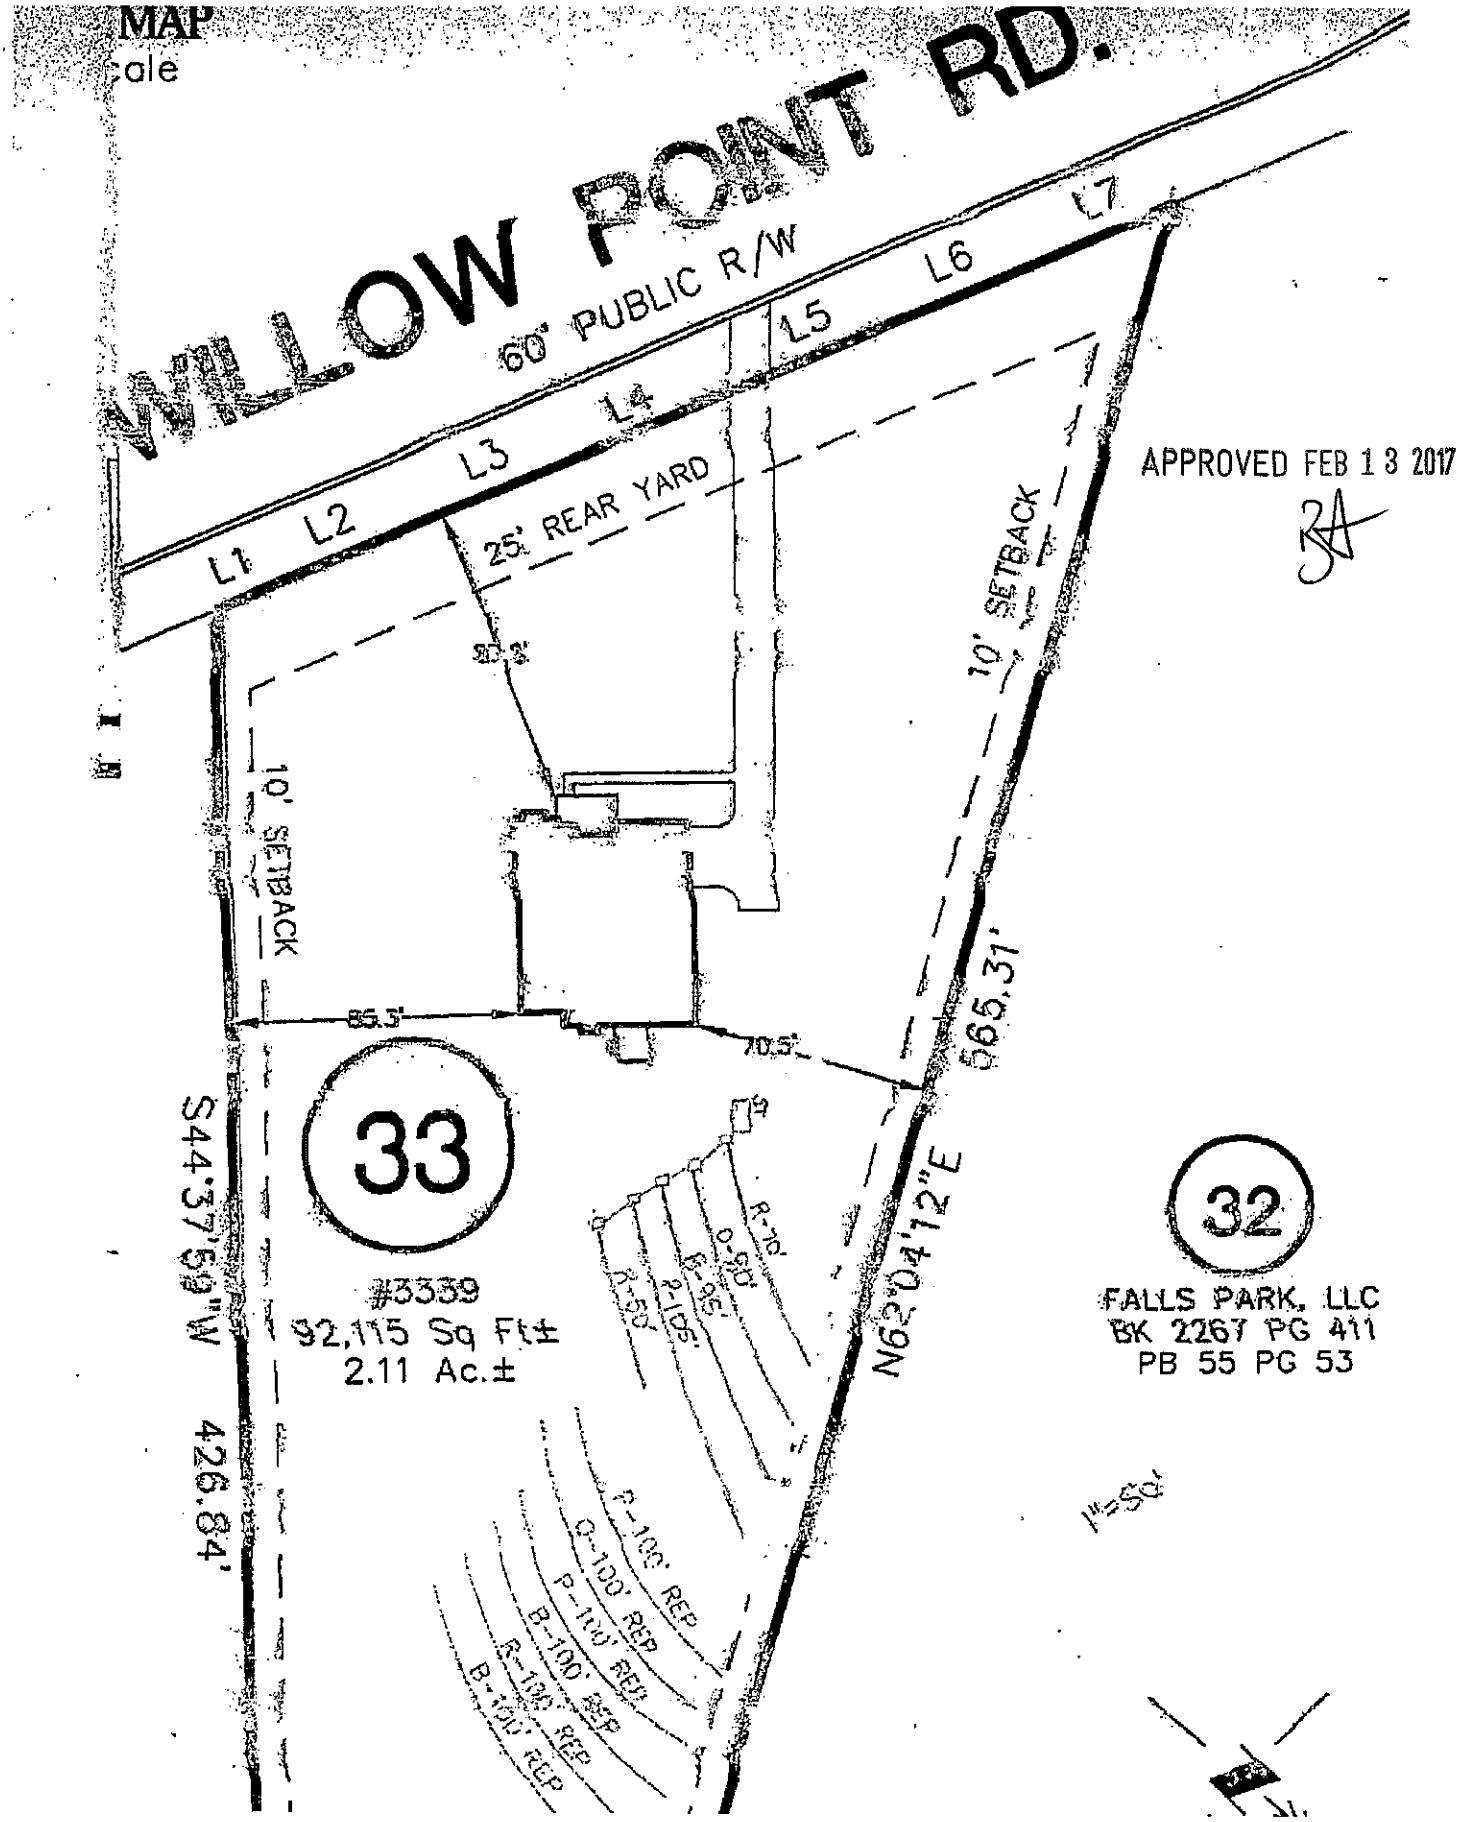
☐ **IMPROVEMENT PERMIT** *with plat valid without expiration.* ☒ **IMPROVEMENT PERMIT** *with site plan valid for 60 mos.* ☐ **AUTHORIZATION TO CONSTRUCT** *valid for period equal to IMPROVEMENT PERMIT--not to exceed 60 mo.*

Owner / Applicant Signature: Kathleen Saunders Date: 3-1-17 Installed by: Wessoa Septic

IMPROVEMENT PERMIT by: Date: 2-13-17 OPERATION PERMIT by: Date: 3/3/17

AUTHORIZATION TO CONSTRUCT by: Date: 3/1/17 Existing System Inspected by: Date:

Health Dept. Copy - WHITE Applicant (Final Approval) - YELLOW Applicant (Conditional Approval) - PINK


MAP
cale
WILLOW POINT RD.
60' PUBLIC R/W
L1
L2
L3
L4
L5
L6
L7
25' REAR YARD
10' SETBACK
10' SETBACK
APPROVED FEB 1 3 2017
33
#3339
92,115 Sq Ft±
2.11 Ac.±
S44°37'59"W 426.84'
N62°04'12"E 565.31'
85.5'
70.5'
R-70'
Q-80'
R-95'
Q-105'
R-50'
R-100' REP
Q-100' REP
R-100' REP
R-100' REP
R-100' REP
32
FALLS PARK, LLC
BK 2267 PG 411
PB 55 PG 53
1"=50'