IREDELL COUNTY HEALTH DEPARTMENT

Statesville Office (704) [redacted] Mooresville Office (704) 660-3625 PERMIT # 217703

IMPROVEMENT PERMIT / AUTHORIZATION TO CONSTRUCT / OPERATION PERMIT / EXISTING SYSTEM

PIN # 4629746105

APPLICANT: Livewell Homes LLC APPLICANT ADDRESS: 501 Springcrest Dr Fort Mill, SC 29715

607 SITE ADDRESS: 614 Stillwater Rd Troutman, NC 28166 PHONE: ALT. PHONE: Kathleen 704 578-4951

SITE DIRECTIONS: Perth Rd S TR State Park Rd TL Morrison Farm TL Dayvault TR Stillwater lot on right

SUBDIVISION: Falls Park SECTION: 3B LOT # 32 LOT AREA: DESIGN FLOW: 600gpd L.T.A.R.: .3

Septic Tank 1500 (gal) STB 338 Date 1-24-17
Pump Tank (gal) PT Date
Pump Make Model Serial #
Nitrification Fields 1 # Lines 5 Linear Ft: 500
Trench Width 36" Max. Trench Bottom Depth 24" Gravel Depth N/A

☒ New System ☐ Repair ☐ Expansion System Type: I II (III) IV V VI
System Description: Gravity - 25% Reduction
Repair System Description: 25% Reduction
Maintenance Agreement Required: ☐ YES ☒ NO
☒ GRAVITY ☐ PRESSURE

☒ Residence No. Bedrooms 5
☐ Business No. Persons 10
☐ Other No. Employees
☐ Slab ☒ Crawl Space
☐ Basement w/plumbing

Water Supply: ☐ Private ☒ Public ☐ Community
☐ Basement w/o plumbing

Comments / Conditions:

ST 12ft off edge of deck
Installed clean outs every 50ft
Last drain line fed from opposite end

INITIAL SITE SKETCH

See attached, approved plan by The Oaks Group (dated 6-9-16)

AS BUILT SKETCH

Permit can be suspended or revoked if any false information is supplied toward securing the permit / any unauthorized changes are made to the site / any unauthorized changes are made in the installation of the system. **CONTACT A LOCATOR SERVICE PRIOR TO ANY EXCAVATION**

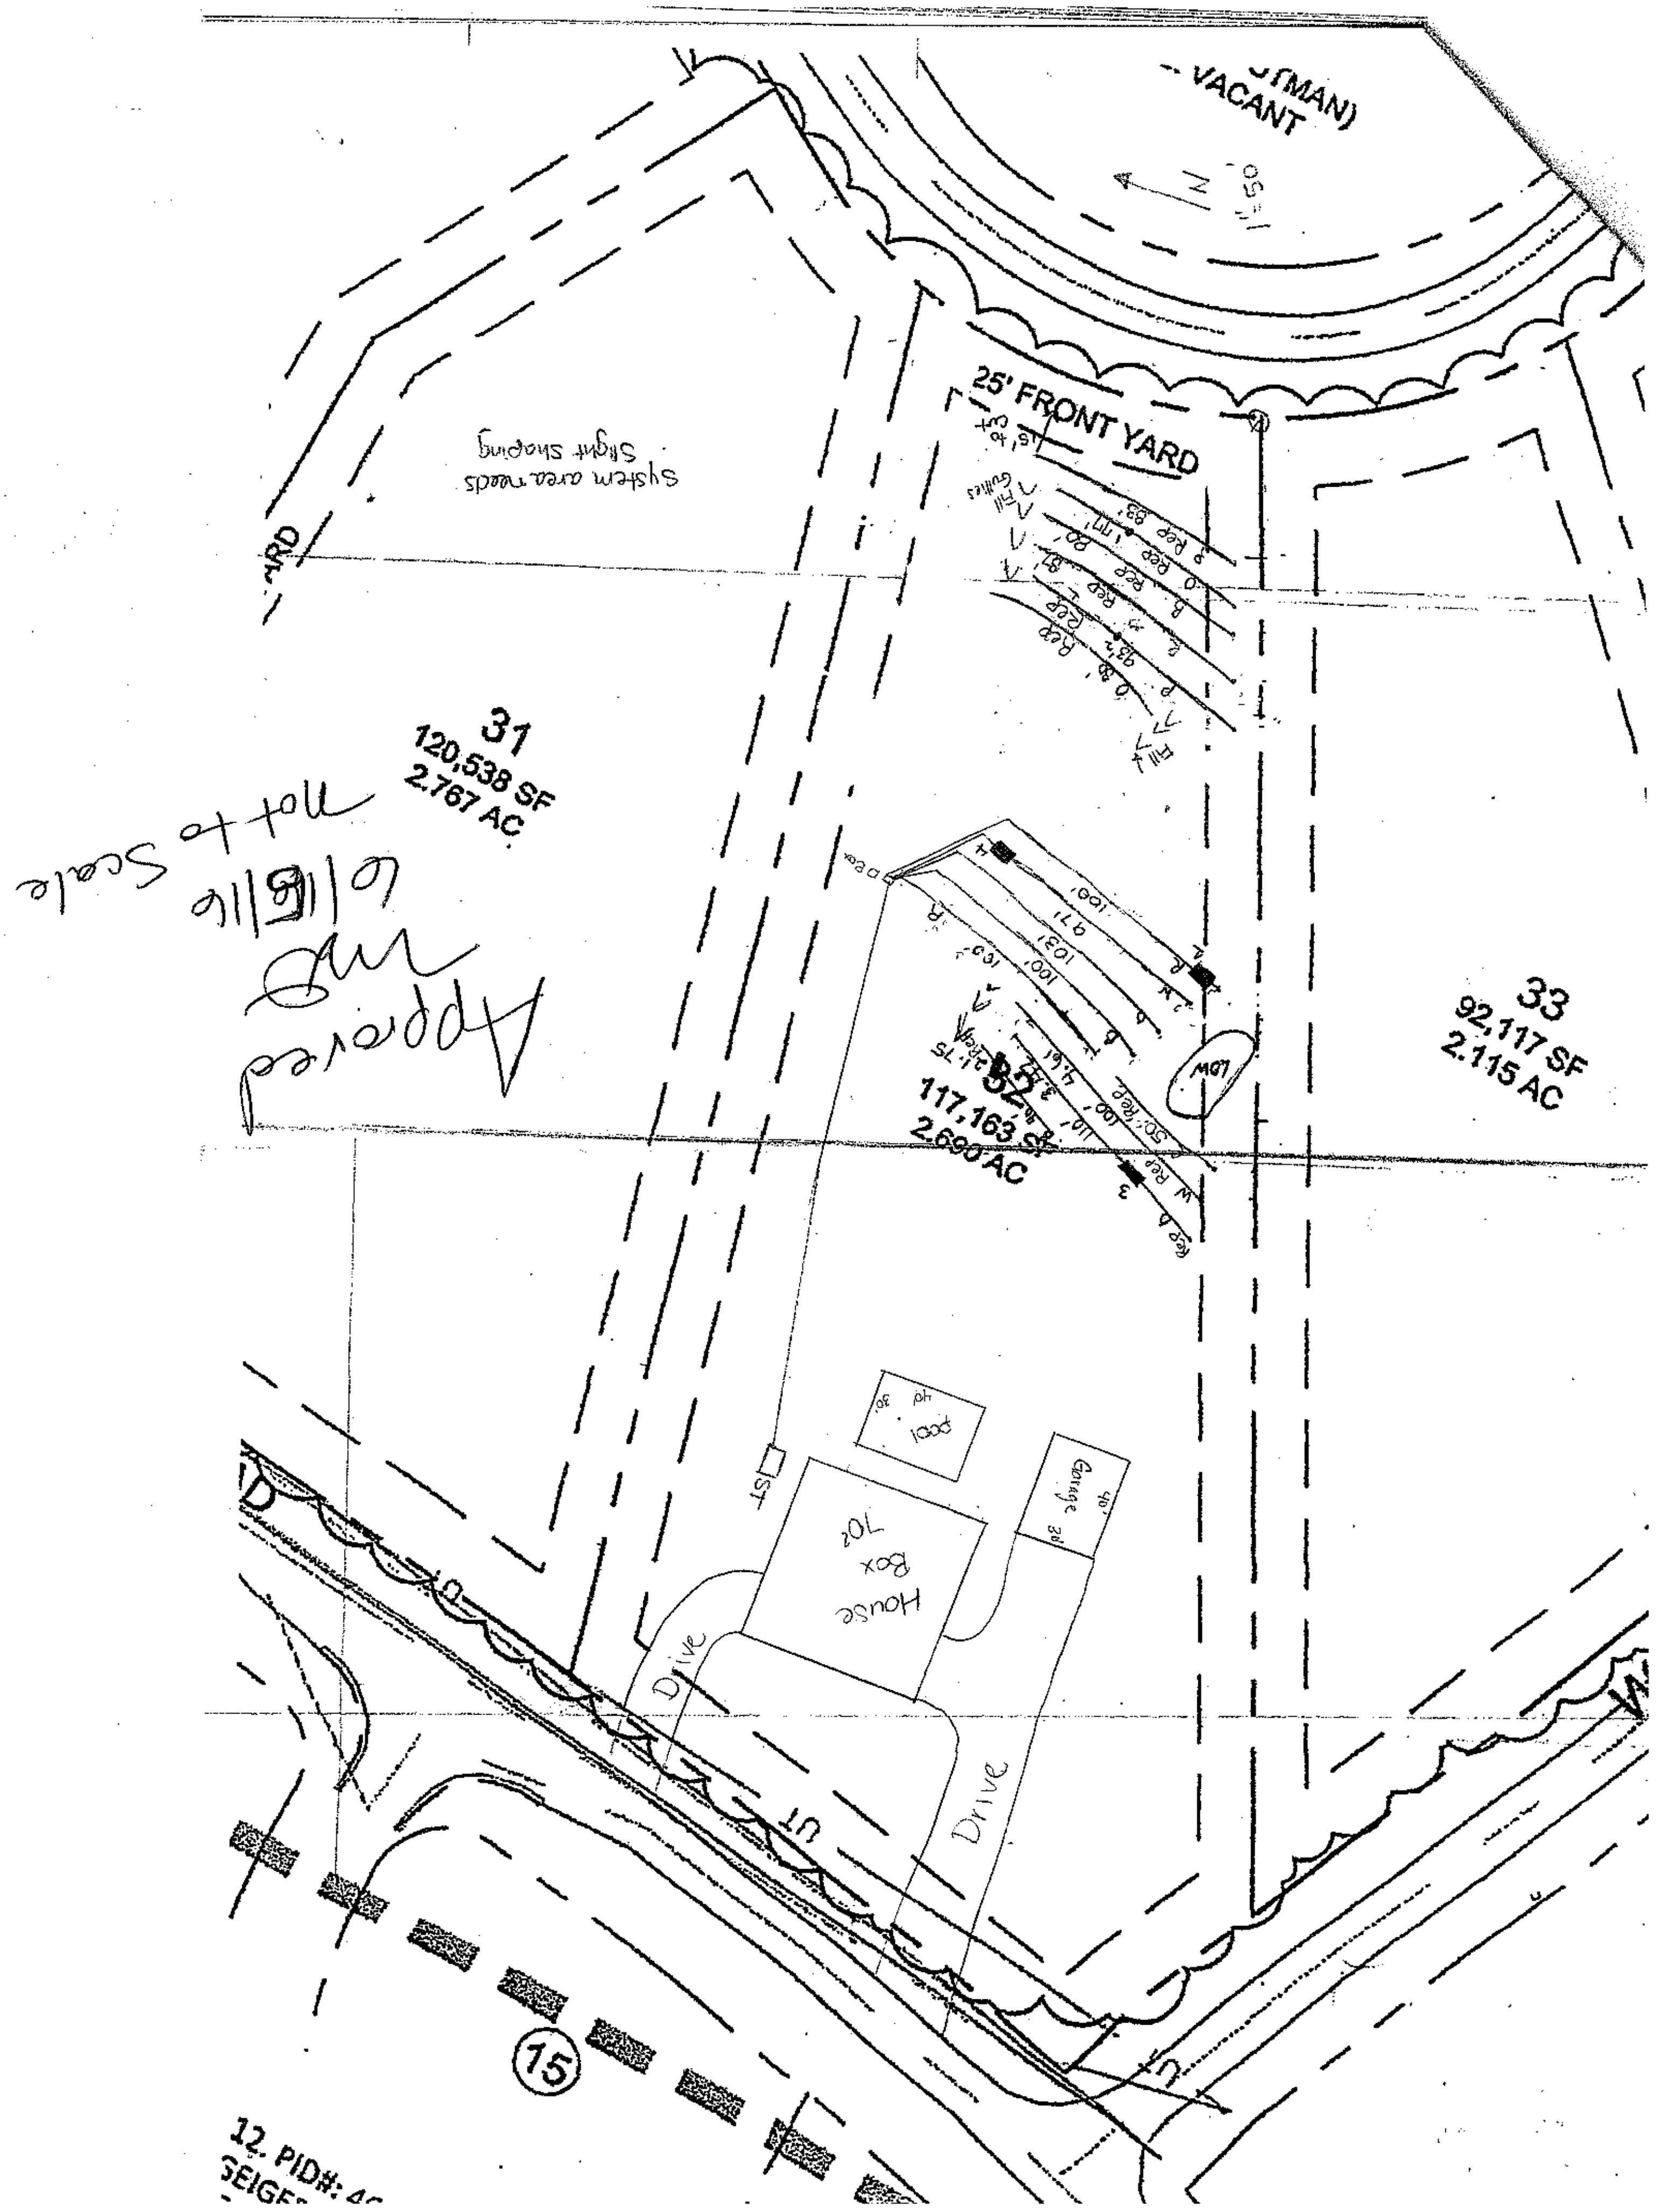
☐ **IMPROVEMENT PERMIT** *with plat valid without expiration.* ☐ **IMPROVEMENT PERMIT** *with site plan valid for 60 mos.* ☒ **AUTHORIZATION TO CONSTRUCT** *valid for period equal to IMPROVEMENT PERMIT--not to exceed 60 mo.*

Owner / Applicant Signature: Date: 6/20/16 Installed by: Wesson Septic

IMPROVEMENT PERMIT by: Maria Dotson RS Date: 6/16/16 OPERATION PERMIT by: Maria Dotson Date: 3/1/17

AUTHORIZATION TO CONSTRUCT by: Maria Dotson RS Date: 6/16/16 Existing System Inspected by: Date:

Health Dept. Copy - WHITE Applicant (Final Approval) - YELLOW Applicant (Conditional Approval) - PINK


VACANT
1"=50'
25' FRONT YARD
system area needs
slight shaping
31
120,538 SF
2.767 AC
Approved
Not to Scale
32
117,163 SF
2.690 AC
33
92,117 SF
2.115 AC
LOW
Pool
House
Box 70'
Garage
Drive
Drive
UT
15