IREDELL COUNTY HEALTH DEPARTMENT

Statesville Office (704) 878-5305 Mooresville Office (704) 660-3625 PERMIT # 21495

IMPROVEMENT PERMIT / AUTHORIZATION TO CONSTRUCT / OPERATION PERMIT / EXISTING SYSTEM

PIN # 4629746598

APPLICANT: Live Well Homes APPLICANT ADDRESS: 561 SpringCrest Dr.

SITE ADDRESS: 600 Stillwater PHONE: 704-578-4951 ALT. PHONE: N/A

SITE DIRECTIONS: Perth Rd to State Park Rd to Morrison Farm Rd to Stillwater Rd.

SUBDIVISION: Falls Park SECTION: 3B LOT # 30 LOT AREA: 2.389 acres DESIGN FLOW: 480gpd L.T.A.R.: 0.275

Septic Tank 1000 (gal) STB 794 Date 1-22-16

Pump Tank N/A (gal) PT N/A Date N/A

Pump Make N/A Model Poly/low Serial # PL-65

Nitrification Fields 1 # Lines 5 Linear Ft: 445

Trench Width 36" Max. Trench Bottom Depth 33" Gravel Depth N/A

☑ New System ☐ Repair ☐ Expansion System Type: I II III IV V VI

System Description: 25% Reduction

Repair System Description: 25% Reduction - Pump

Maintenance Agreement Required: ☐ YES ☑ NO

☑ GRAVITY ☐ PRESSURE

☑ Residence ☐ Business ☐ Other ☐ Slab ☑ Crawl Space ☐ Basement w/plumbing ☐ Basement w/o plumbing

No. Bedrooms 4 No. Persons 8 No. Employees

Water Supply: ☐ Private ☑ Public ☐ Community

Comments / Conditions:

INITIAL SITE SKETCH

See attached Plan By:

Kathleen Saunders, LSS

AS BUILT SKETCH

Installed Quick 4

as drawn

Permit can be suspended or revoked if any false information is supplied toward securing the permit / any unauthorized changes are made to the site / any unauthorized changes are made in the installation of the system. **CONTACT A LOCATOR SERVICE PRIOR TO ANY EXCAVATION**

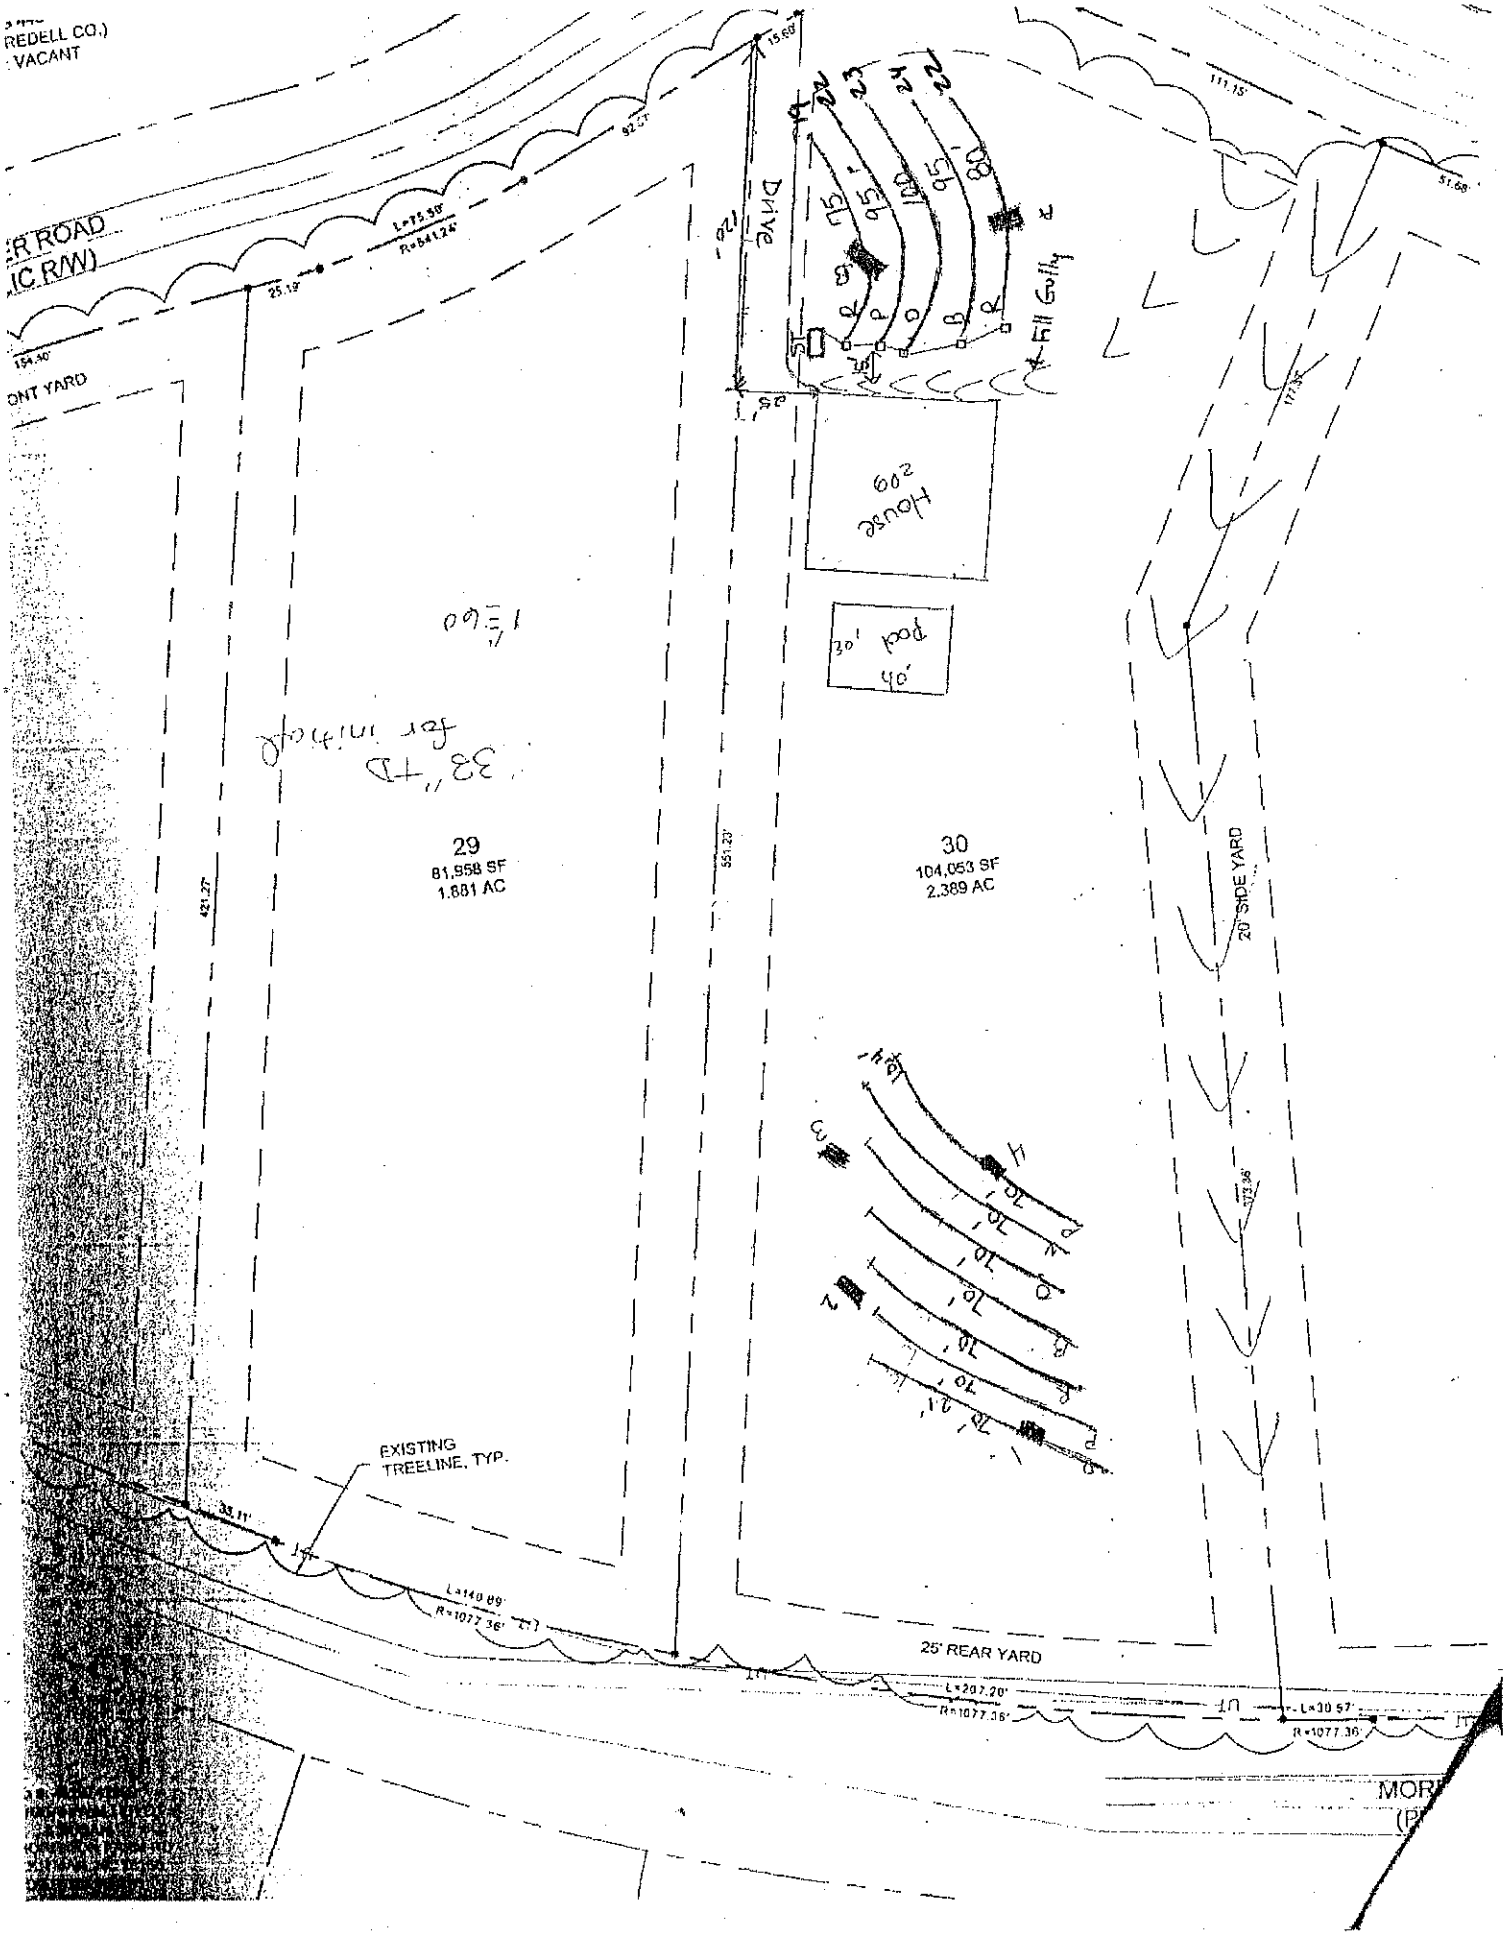
☐ **IMPROVEMENT PERMIT** *with plat valid without expiration.* ☑ **IMPROVEMENT PERMIT** *with site plan valid for 60 mos.* ☑ **AUTHORIZATION TO CONSTRUCT** *valid for period equal to IMPROVEMENT PERMIT--not to exceed 60 mo.*

Owner / Applicant Signature: Date: Installed by: Chris Dobbins (Wesson Septic)

IMPROVEMENT PERMIT by: Justin Henderson Date: 8-25-15 OPERATION PERMIT by: Justin Henderson Date: 03/07/16

AUTHORIZATION TO CONSTRUCT by: Justin Henderson Date: 8-25-15 Existing System Inspected by: Date:

Health Dept. Copy - WHITE Applicant (Final Approval) - YELLOW Applicant (Conditional Approval) - PINK


REDELL CO.)
VACANT
R ROAD
IC R/W)
ONT YARD
DRIVE
Fill Gully
House
60²
30' pool
40'
29
81,958 SF
1.881 AC
30
104,053 SF
2.389 AC
20' SIDE YARD
EXISTING
TREELINE, TYP.
25' REAR YARD
MOR