IREDELL COUNTY HEALTH DEPARTMENT

STATESVILLE 704-878-5305 MOORESVILLE 704-664-5281

IMPROVEMENT PERMIT / AUTHORIZATION TO CONSTRUCT / OPERATION PERMIT / EXISTING SYSTEM INSPECTION

PERMIT# 13126 PIN# 4629-75-3686 DATE 12-2-05

OWNER OR CONTRACTOR FEATHER HOMES PHONE: Business 704.241.8363 Home

ADDRESS 1203 TUFTIN PLACE CONCORD NC 28027

LOCATION MORRISON FARM ROAD TO ROUNDSTONE ROAD, 1ST DRIVE ON RIGHT

SUBDIVISION DUKE BLOCK / SECTION 17 LOT 177 LOT AREA ~~0.736~~ ACRE SITE CLASS. PS DESIGN FLOW 240 L.T.A.R. EXISTING

C & D

Septic Tank: EXISTING Gallons; STB Date

Pump Tank: Gallons; PT Date

Pump Make: Model Serial No.

Nitrification Field: No Fields 1 Square Feet Linear Feet EXISTING

No Lines 1 BED Trench Width Max Trench Bottom Depth Gravel Depth

☐ New System ☐ Repair System Type: I, II, III, IV, V, VI

System Description: CONVENTIONAL, GRAVITY

Repair System Description:

Maintenance Agreement Required: ☐ Yes ☒ No

☐ House/Mod. Home ☒ Mobile Home ☐ Business ☐ Other

No. Bedrooms 2 No. Bathrooms No. Employees

☐ Slab ☒ Crawl Space ☐ Basement w/plumbing ☐ Basement wo/plumbing


Water Supply: ☒ Individual ☐ Public ☐ Community WELL

Comments:/Conditions:

Comments:/Conditions: ① SYSTEM UNDERSIZED ACCORDING TO TODAY'S STANDARDS ② S/W MH TO BE REMOVED UPON OCCUPANCY OF S/W MH

INITIAL SITE SKETCH

AS BUILT SKETCH

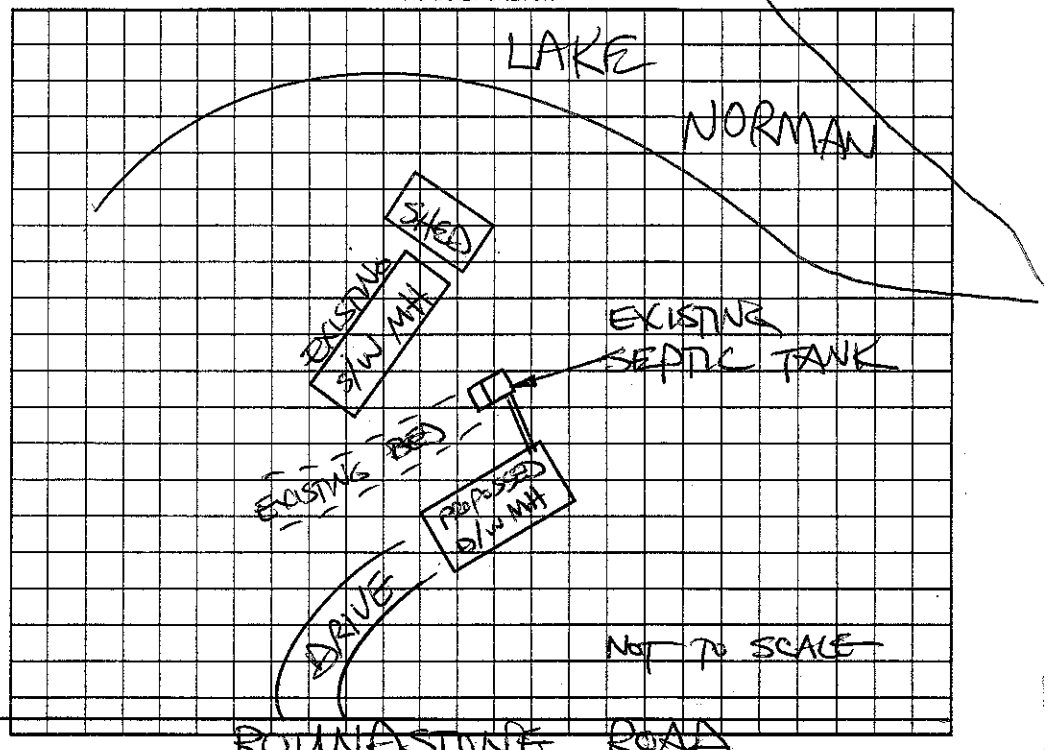

Permit can be suspended or revoked if any false information is supplied toward securing the permit/any unauthorized changes are made to the site/any unauthorized changes are made in the installation of the system. Improvement Permit with plat valid without expiration. Improvement Permit with site plan valid for sixty months. Authorization to Construct is valid for a period equal to that of Improvement Permit – not to exceed sixty months.

Signed: date

Improvement Permit by: date

Authorization to Construct by: date

Installed by:

Operation Permit by: date

Existing System Inspection by: STEVE HENDRICK date 12-2-05

HEALTH DEPT. COPY: WHITE OWNER COPY (FINAL): YELLOW OWNER COPY (INITIAL): PINK