Pd. # 55219

IREDELL COUNTY HEALTH DEPARTMENT

STATESVILLE 704-878-5305 MOORESVILLE 704-664-5281

IMPROVEMENT PERMIT / CERTIFICATE OF COMPLETION / OPERATION PERMIT / EXISTING SYSTEM INSPECTION

PROPERTY DESCRIPTION NO. 24398 DATE 8-5-96 TAX MAP NO. 3C-11-A-174 Watershed: ☑ Yes ☐ No W3IV CA

OWNER OR CONTRACTOR Bobby G. Sizemore PHONE: Business _____ Home 663-1981

ADDRESS _____

LOCATION Perth Rd Turn State PK Rd Turn Morrison Fm Rd TR Abbington 2nd lot 1-st

SUBDIVISION Lake Norman BLOCK / SECTION 18 LOT 817 LOT AREA 3/4 acre SITE CLASS. PS DESIGN FLOW 360 L.T.A.R. .3

Septic Tank: 1000 Gallons; STB 1012 Date 8-29-98

Pump Tank: _____ Gallons; PT _____ Date _____

Pump Make: _____ Model _____ Serial No. _____

Nitrification Field: No Fields 1 Square Feet 420 Linear Feet 210

No Lines 3 Trench Width 24" Max Trench Bottom Depth 36" Gravel Depth N/A

☑ New System ☐ Repair System Type: I, II, (III) IV, V, VI

System Description: Gravity Pops Block Panel

Repair System Description: Pump To Panel Block

Maintenance Agreement Required: ☐ Yes ☐ No

☑ House/Mod. Home No. Bedrooms 3

☐ Mobile Home No. Bathrooms 2

☐ Business No. Employees ____

☐ Other _____


☐ Slab ☐ Crawl Space ☑ Basement w/plumbing ☐ Basement wo/plumbing

Water Supply: ☑ Individual ☐ Community ☐ Public

Comments:

Comments:

INITIAL SITE SKETCH

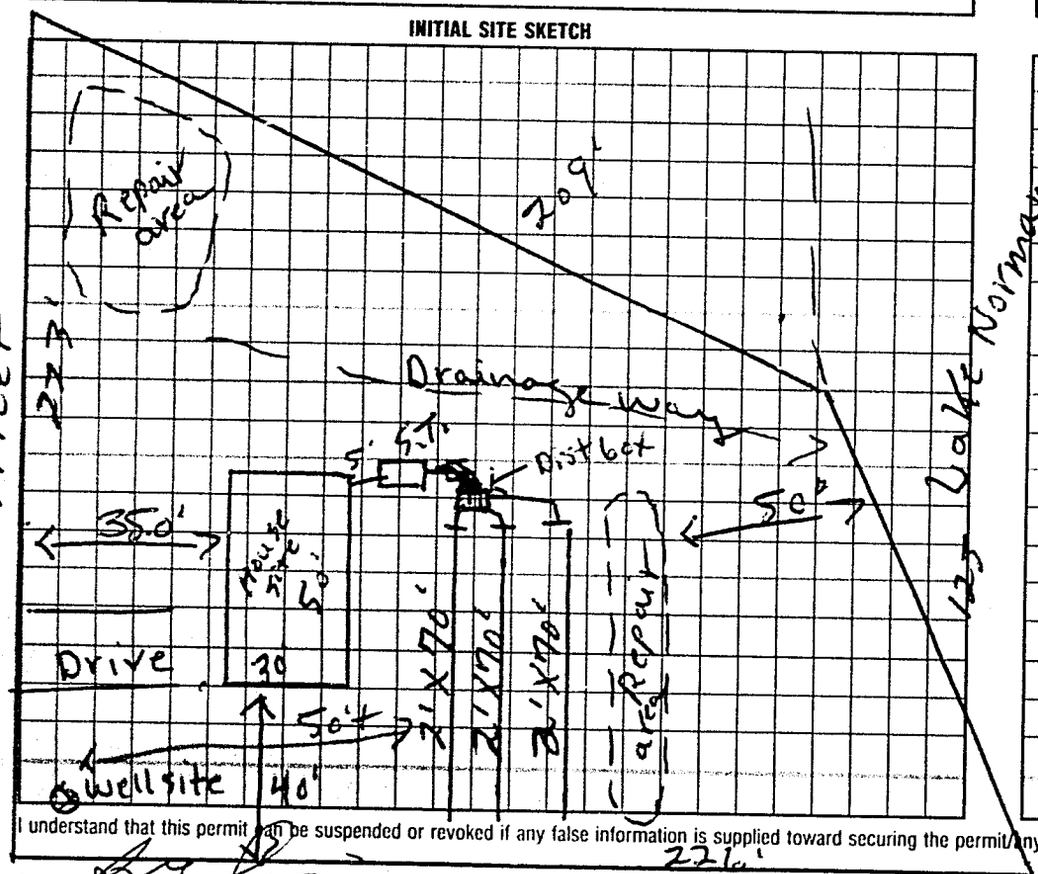

AS BUILT SKETCH

SYSTEM INSTALLED ACCORDING TO INITAL SITE SKETCH

I understand that this permit can be suspended or revoked if any false information is supplied toward securing the permit/any unauthorized changes are made to the site/any unauthorized changes are made in the installation of the system.

Signed: _____

Improvement Permit by: F. C. Moore date 8-5-96

Authorization Existing System Inspection by: F. C. Moore date 8-5-96

Installed by: A-1 BACKHOE

Certificate of Completion by: STEVE HEDRICK date 10-27-98

Operation Permit by: _____ date _____

to const.

HEALTH DEPT. COPY: WHITE INSPECTION COPY (FINAL): GREEN OWNER COPY (FINAL): YELLOW INSPECTION COPY (INITIAL): PINK OWNER COPY (INITIAL): GOLD

Authorization to const. Expires 6 mos from issue