60267 11:00 Foothills Grad

IREDELL COUNTY HEALTH DEPARTMENT

STATESVILLE 704-878-5305 MOORESVILLE 704-664-5281

IMPROVEMENT PERMIT / CERTIFICATE OF COMPLETION / OPERATION PERMIT / EXISTING SYSTEM INSPECTION

PROPERTY DESCRIPTION NO. 23442 DATE 4-13-96 TAX MAP NO. 3C-11-A-175 Watershed: ☐ Yes ☐ No

OWNER OR CONTRACTOR MICHAEL L. SACOSKY SR PHONE: Business Home 664-9672

ADDRESS 2562 KERR AVE, MOORESVILLE, NC 28115

LOCATION US 21 S, TR PERTH, TR STATE PARK, R, MORRISON FARM, TR ABINGTON PLACE, 1ST LOT ON LEFT

SUBDIVISION SECTION 17 BLOCK / SECTION 17 LOT 318 LOT AREA 3.62 ACRE SITE CLASS RS DESIGN FLOW 360 L.T.A.R. 0.30 GPD/FT²

Septic Tank: 1000 Gallons; STB STP-786 Date 3/26/96

Pump Tank: ____ Gallons; PT (Stroud / Burleson) Date ____

Pump Make: ____ Model ____ Serial No. ____

Nitrification Field: No Fields 1 Square Feet 1200 Linear Feet 400

No Lines 4 Trench Width 36" Max Trench Bottom Depth 18-30" Gravel Depth 12"

☑ New System ☐ Repair System Type: I (II) III. IV. V. VI

System Description: CONVENTIONAL GRAVITY

Repair System Description: CONVENTIONAL PUMP

Maintenance Agreement Required: ☐ Yes ☑ No

☐ House/Mod. Home ☑ Mobile Home ☐ Business ☐ Other

No. Bedrooms 3 No. Bathrooms 2 No. Employees ____


☐ Slab ☑ Crawl Space ☐ Basement w/plumbing ☐ Basement wo/plumbing

Water Supply: ☑ Individual ☐ Community ☐ Public WELL


Comments: ① KEEP SYSTEM MINIMUM 50' FROM 760' CONTOUR LINE, 100' FROM WELL, 5' FROM BUILDING FOUNDATION 10' FROM PROPERTY LINE ② INSTALL ~~SUBSURFACE~~ INTERCEPT DITCH AS SHOWN BEGINNING 42" DEEP AND FALLING OUT TO DAYLIGHT.

Comments: Keep well 100' from septic area
Divert all water possible from area of septic

INITIAL SITE SKETCH

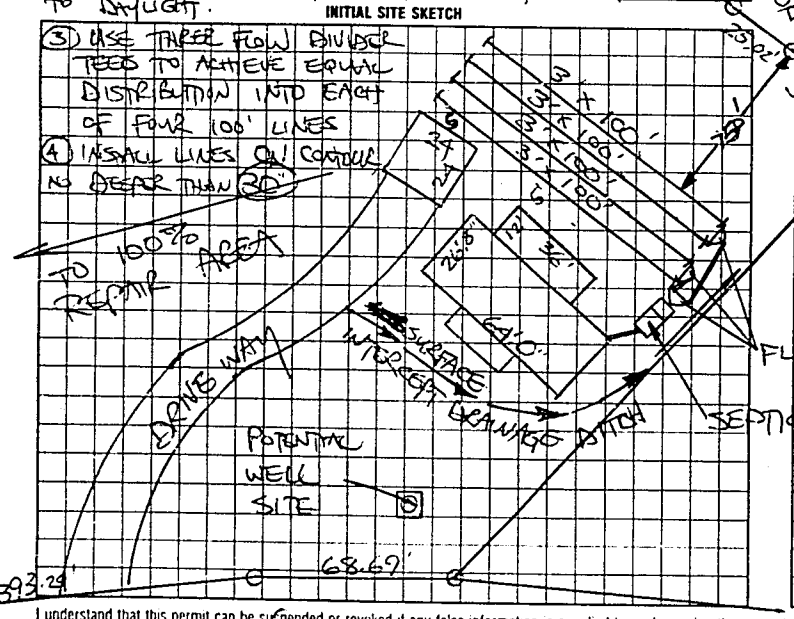

AS BUILT SKETCH

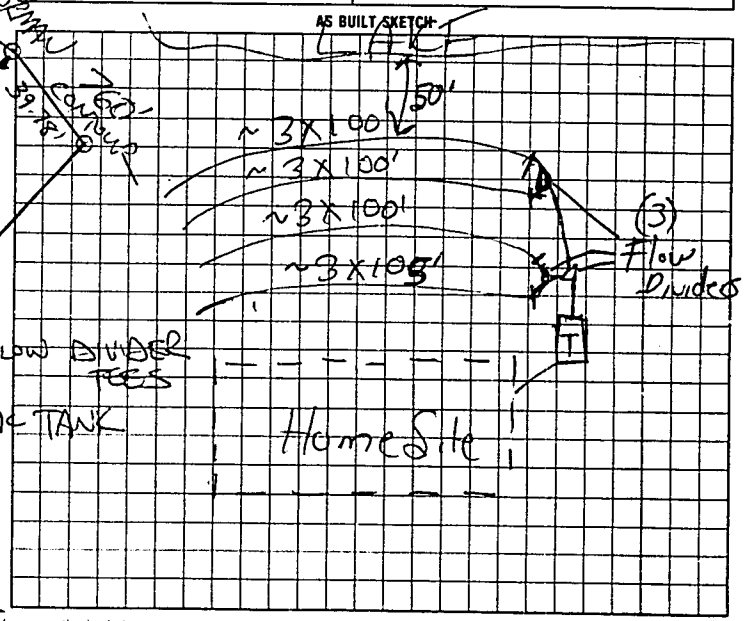

I understand that this permit can be suspended or revoked if any false information is supplied toward securing the permit/any unauthorized changes are made to the site/any unauthorized changes are made in the installation of the system.

Authorization to Construct is valid five (5) years from date of issuance. Improvement Permit has no expiration date.

Signed: [signature]

Improvement Permit by: STEVE HENDRICK date 4-13-96

Existing System Inspection by: STEVE HENDRICK date 4-13-96

AUTHORIZATION TO CONSTRUCT:

Installed by: Foothills Plumbing

Certificate of Completion by: ____ date ____

Operation Permit by: [signature] date 7/1/96

HEALTH DEPT COPY WHITE | INSPECTION COPY (FINAL) GREEN | OWNER COPY (FINAL) YELLOW | INSPECTION COPY (INITIAL) PINK | OWNER COPY (INITIAL) GOLD

00211