IREDELL COUNTY HEALTH DEPARTMENT

Statesville Office (704) 878-5305 Mooresville Office (704) 660-3625 PERMIT # 200060

IMPROVEMENT PERMIT / AUTHORIZATION TO CONSTRUCT / OPERATION PERMIT / EXISTING SYSTEM

PIN # ~~4629779465~~ 4629.76.7664

APPLICANT: Regan Smith APPLICANT ADDRESS: 150 Hermance Ln.

SITE ADDRESS: 462 Morrison Farm Rd. PHONE: 704-663-1515 ALT. PHONE: 704-363-8888

SITE DIRECTIONS: Hwy 215 TR Perth Rd. TR State Park Rd TL Morrison Farm Rd.

SUBDIVISION: Morrison Pointe North SECTION: N/A LOT # TR 3428-05 LOT AREA: 47.84 acres DESIGN FLOW: 600gpd L.T.A.R.: 0.3

Septic Tank 1500 (gal) STB 338-1500 Date 5-4-15
Pump Tank (gal) PT Date
Pump Make Model Serial #
Nitrification Fields 1 # Lines 5 Linear Ft: 500
Trench Width 36" Max. Trench Bottom Depth 36" Gravel Depth


☑ New System ☐ Repair ☐ Expansion System Type: I II III IV V VI
System Description: 25% Reduction
Repair System Description: 25% Reduction
Maintenance Agreement Required: ☐ YES ☑ NO
☑ GRAVITY ☐ PRESSURE

☑ Residence No. Bedrooms 5
☐ Business No. Persons
☐ Other No. Employees
☐ Slab ☐ Crawl Space
☑ Basement w/plumbing ☐ Basement w/o plumbing


Water Supply: ☐ Private ☑ Public ☐ Community

Comments / Conditions: Install a 25% Reduction system on contour with serial distribution.

INITIAL SITE SKETCH

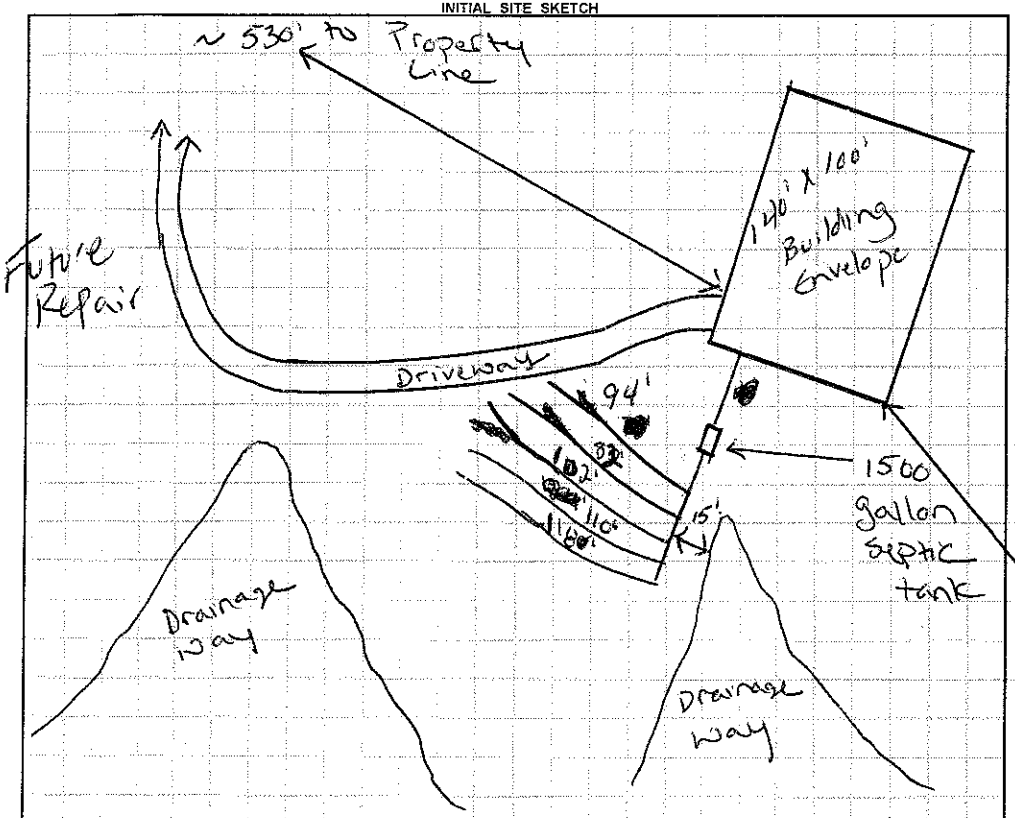

AS BUILT SKETCH

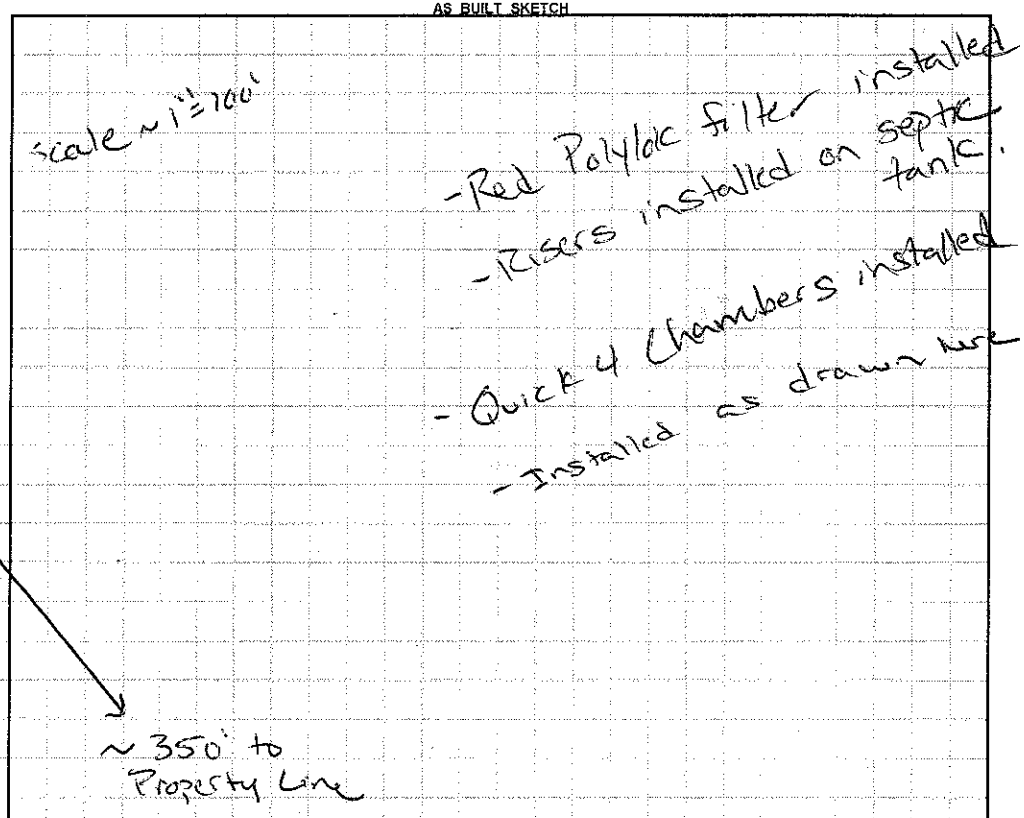

Permit can be suspended or revoked if any false information is supplied toward securing the permit / any unauthorized changes are made to the site / any unauthorized changes are made in the installation of the system. **CONTACT A LOCATOR SERVICE PRIOR TO ANY EXCAVATION**

☐ **IMPROVEMENT PERMIT** *with plat valid without expiration* ☑ **IMPROVEMENT PERMIT** *with site plan valid for 60 mos.* ☑ **AUTHORIZATION TO CONSTRUCT** *valid for period equal to IMPROVEMENT PERMIT--not to exceed 60 mo.*

Owner / Applicant Signature: Regan Smith Date: 12-6-13 Installed by: Richard Abernathy Grading & Septic

IMPROVEMENT PERMIT by: Justin Henderson Date: 12-4-13 OPERATION PERMIT by: Justin Henderson Date: 11-19-15

AUTHORIZATION TO CONSTRUCT by: Justin Henderson Date: 12-4-13 Existing System Inspected by: Date:

Health Dept. Copy - WHITE Applicant (Final Approval) - YELLOW Applicant (Conditional Approval) - PINK