IREDELL COUNTY HEALTH DEPARTMENT

STATESVILLE 704-878-5305 CI MOORESVILLE 704-664-5281

IMPROVEMENT PERMIT / AUTHORIZATION TO CONSTRUCT / OPERATION PERMIT / EXISTING SYSTEM INSPECTION

PERMIT# 132046 PIN# 4629780533 DATE 1-19-06

OWNER OR CONTRACTOR Jaquelyn Hendrix PHONE: Business 704 660 6659 Home

ADDRESS 386 Willife Rd.

LOCATION 115/215 (R) on Perth, (R) on State Park, (L) on Willife lot

SUBDIVISION n/a BLOCK / SECTION n/a LOT n/a LOT AREA .798 SITE CLASS PS DESIGN FLOW 480 L.T.A.R. -4

Septic Tank: 1000 Gallons; STB 1012 Date 11-1-06
Pump Tank: 1000 Gallons; PT 1000 Date 11-13-06
Pump Make: Covid Model WED512HHV Serial No. B0733818
Nitrification Field: No Fields 1 Square Feet 1200 Linear Feet 200
No Lines 3 Trench Width 2 Max Trench Bottom Depth 42" Gravel Depth n/a

☒ New System ☐ Repair System Type: I, II, III, (IV), V, VI
System Description: LF 50% reduction
Repair System Description: LP 50% reduction
Maintenance Agreement Required: ☐ Yes ☐ No

☒ House/Mod. Home No. Bedrooms 4
☐ Mobile Home No. Bathrooms
☐ Business No. Employees
☐ Other


☐ Slab ☒ Crawl Space ☐ Basement w/plumbing ☐ Basement wo/plumbing

Water Supply: ☒ Individual ☐ Public ☐ Community

Comments:/Conditions: wells need to be abandoned before construction authorization can be issued. foundation drain to be installed <1' deep on high tank side of house

Comments:/Conditions: Yellow Filter

INITIAL SITE SKETCH

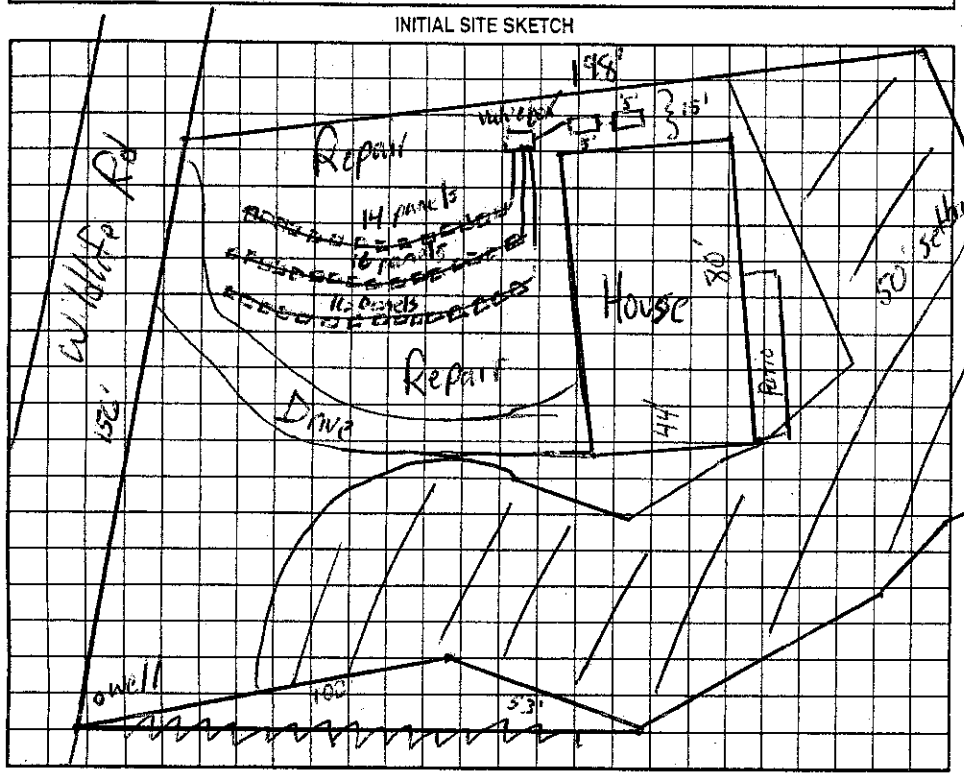

AS BUILT SKETCH

No Foundation Drain within 15' of tanks

Permit can be suspended or revoked if any false information is supplied toward securing the permit/any unauthorized changes are made to the site/any unauthorized changes are made in the installation of the system. Improvement Permit with plat valid without expiration. Improvement Permit with site plan valid for sixty months. Authorization to Construct is valid for a period equal to that of Improvement Permit – not to exceed sixty months.

Signed: Jaquelyn Hendrix date 8-16-06 Installed by: Steve Jordan

Improvement Permit by: James Stevens date 1-19-06 Operation Permit by: James Stevens date 4-9-07

Authorization to Construct by: James Stevens date 8-10-06 Existing System Inspection by: date

HEALTH DEPT. COPY: WHITE OWNER COPY (FINAL): YELLOW OWNER COPY (INITIAL): PINK