IREDELL COUNTY HEALTH DEPARTMENT

STATESVILLE 704-878-5305 MOORESVILLE 704-664-5281

IMPROVEMENT PERMIT / AUTHORIZATION TO CONSTRUCT / OPERATION PERMIT / EXISTING SYSTEM INSPECTION

PERMIT# 10263 PIN# 4629782055 DATE 11-16-2001

OWNER OR CONTRACTOR Harry Sloan PHONE: Business Home 664-3322

ADDRESS 809 White Oak Ln. Mooresville, NC 28115

LOCATION State Park Rd To Morrison Farm go ~ 1 mile TR Seekirk (162 Seekirk)

SUBDIVISION Clay T BLOCK / SECTION LOT 94 LOT AREA .9 Acre SITE CLASS PS DESIGN FLOW 360 gpd L.T.A.R. .3

Septic Tank: Exist. 1000 Gallons: STB Date

Pump Tank: Gallons: PT Date

Pump Make: Model Serial No

Nitrification Field: No Fields 1 Square Feet 300' Linear Feet 100'

No Lines 2 @ 50' Trench Width 36" Max Trench Bottom Depth 36"+ Gravel Depth N/A

X New System ☐ Repair System Type: I II III IV V VI

System Description: X Addition Gravity - 25% Red. of Trench Impeed - Innovative

Repair System Description:

Maintenance Agreement Required: ☐ Yes X No

X House/Mod. Home No. Bedrooms 3

☐ Mobile Home No. Bathrooms 3

☐ Business No. Employees

☐ Other

☐ Slab X Crawl Space ☐ Basement w/plumbing ☐ Basement wo/plumbing


Water Supply: X Individual Exist. ☐ Public ☐ Community

Add'g


Comments/Conditions: Upgrading Existing Septic System from 2 Bedrooms to 3 Bedrooms. Adding 2-50' 25% Reduction drainlines

Comments/Conditions All drainlines must be at least 50' From existing well. Existing drainlines Closer than 50' must be cut off at 50' from well

INITIAL SITE SKETCH *Not to Scale

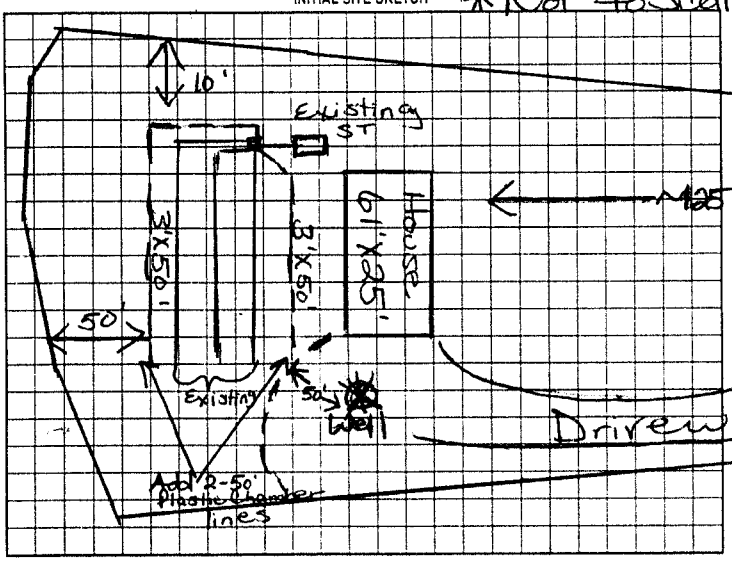

AS BUILT SKETCH

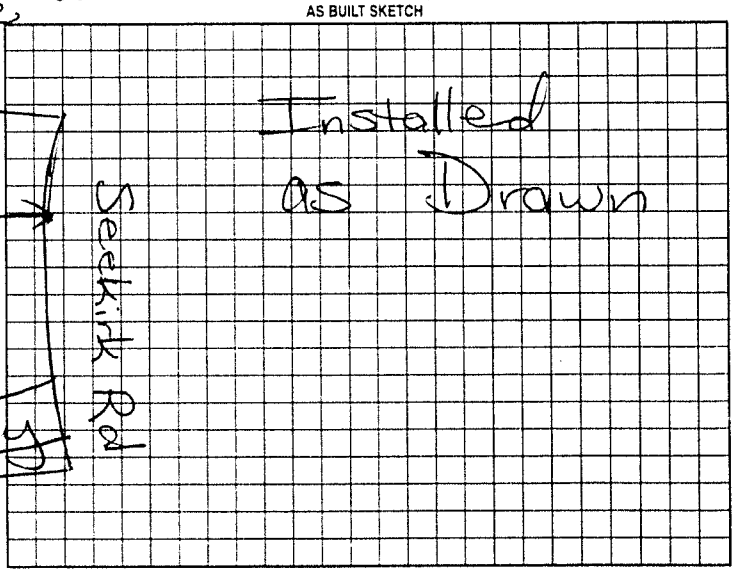

Lake Norman

Permit can be suspended or revoked if any false information is supplied toward securing the permit/any unauthorized changes are made to the site any unauthorized changes are made in the installation of the system. Improvement Permit with plat valid without expiration. Improvement Permit with site plan valid for sixty months. Authorization to Construct is valid for a period equal to that of Improvement Permit - not to exceed sixty months.

Signed: X date 11/16/01 Installed by: F.J. Eakin RS date

Improvement Permit by: Maria H. Dotson RS date 11/16/2001 Operation Permit by: Maria H. Dotson RS date

Authorization to Construct by: Maria H. Dotson RS date 11/16/2001 Existing System Inspection by: date

HEALTH DEPT. COPY WHITE OWNER COPY (FINAL) YELLOW OWNER COPY (INITIAL) PINK