IREDELL COUNTY HEALTH DEPARTMENT

STATESVILLE 704-878-5305 MOORESVILLE 704-

IMPROVEMENT PERMIT / AUTHORIZATION TO CONSTRUCT / OPERATION PERMIT / EXISTING SYSTEM INSPECTION

PERMIT# 117704 PIN# 4629-78-2986 ROGER WAY, JR DATE 2-12-04

OWNER OR CONTRACTOR WARREN GREENLEE PHONE: Business TERRY 704-507-3873 Home 704-576-4800

ADDRESS 19300 STATESVILLE RD CORNELIUS NC 28031

LOCATION 21 SOUTH (R) PERTH (R) STATE PARK (L) WILDLIFE ON RIGHT BY LAST CURVE BY END

SUBDIVISION CRESCENT LANDING BLOCK / SECTION ____ LOT 801 LOT AREA .81AC SITE CLASS. IV DESIGN FLOW 360 L.T.A.R. .3

Septic Tank: 1000 Gallons: STB 194 Date 7-20-04

Pump Tank: 1000 Gallons: PT 31 Date 7-19-04

Pump Make: ZOELLER Model OSE 5002-104 Serial No. 718401

Nitrification Field: No Fields 1 Square Feet EW-120 Linear Feet 200'

No Lines 2 Trench Width 24" Max Trench Bottom Depth 36" Gravel Depth N/A

☒ New System ☐ Repair System Type: I, II, III, (IV), V, VI

System Description: LP PANEL

Repair System Description: LP PANEL

Maintenance Agreement Required: ☒ Yes ☐ No

☒ House/Mod. Home ☐ Mobile Home ☐ Business ☐ Other

No. Bedrooms 3 No. Bathrooms 3½ No. Employees ____


☐ Slab ☐ Crawl Space ☒ Basement w/plumbing ☐ Basement wo/plumbing

Water Supply: ☒ Individual ☐ Public ☐ Community

Comments:/Conditions: (1) SYSTEM & HOUSE ARE ENTIRELY ELEVATED OUT ON LOT (2) DRIVEWAY MUST NOT BE CUT. IT MUST REMAIN AT NATURAL GRADE OR THE REPAIR WILL NOT BE VALID. (3) SUPPLY LINE CROSSING UNDER THE DRIVE MUST


Comments:/Conditions: BE DONE IN ACCORDANCE OF RULE 1950(C)(E). (4) DO NOT CUT LOT FOR POSITIVE DRAINAGE REQMTS. KEEP HOUSE OUT OF THE GROUND & BACK FILL FOR POS. DRAINAGE. THIS CHANGES THE CUTSETBACK OF 35' TO 15" FOR FILLING IT

INITIAL SITE SKETCH 1" = 50'

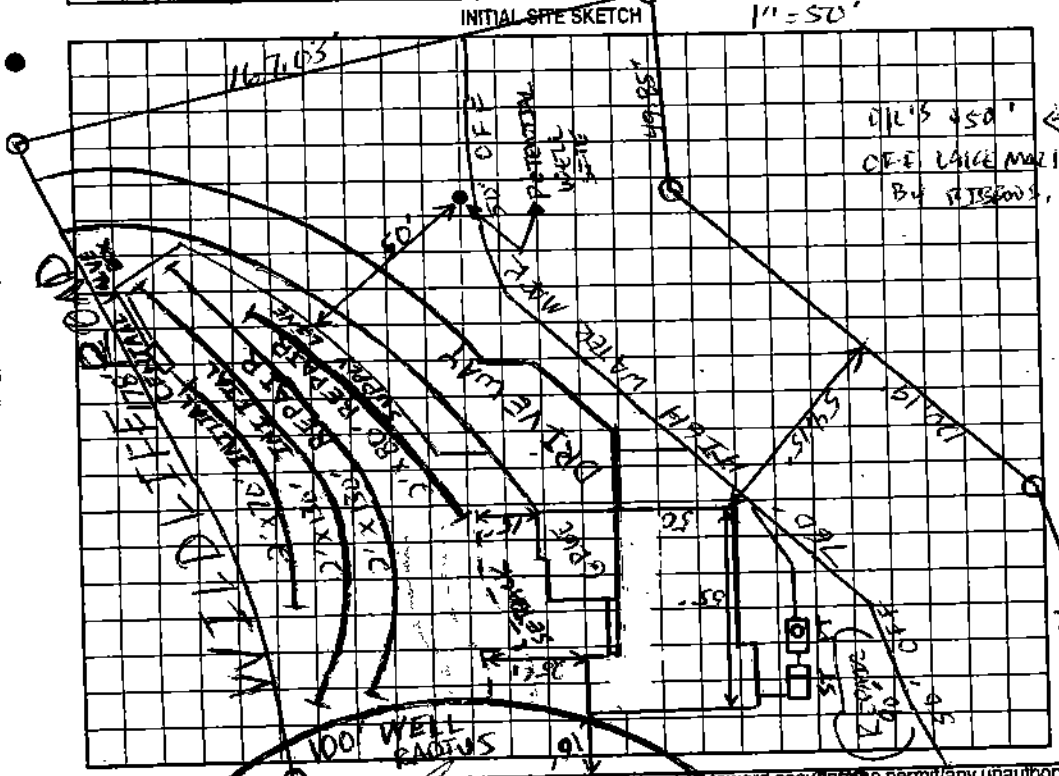

AS BUILT SKETCH



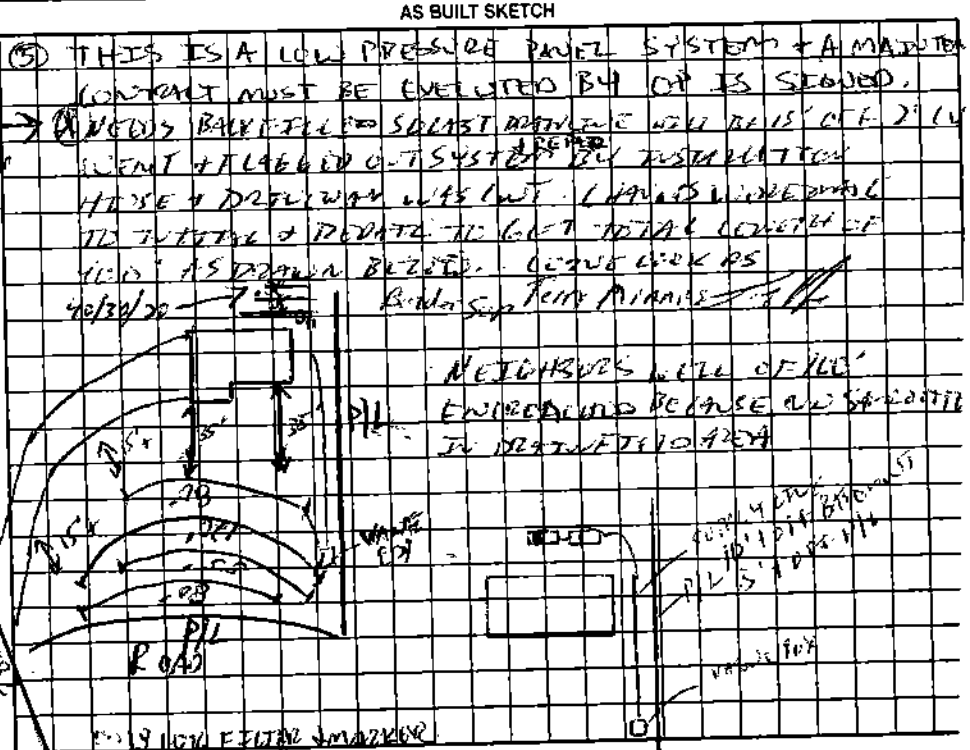

Permit can be suspended or revoked if any false information is supplied toward securing the permit/any unauthorized changes are made to the site/any unauthorized changes are made in the installation of the system. Improveme

Permit with plat valid without expiration. Improvement Permit with site plan valid for sixty months. Authorization to Construct is valid for a period equal to that of Improvement Permit – not to exceed sixty months.

Signed ____ date 2-13-04 Installed by: STAN'S SEPTIC

Improvement Permit by: ____ date 2-12-04 Operation Permit by: ____ date 10-1-04

Authorization to Construct by: ____ date 2-13-04 Existing System Inspection by: ____ date ____

HEALTH DEPT. COPY: WHITE OWNER COPY (FINAL): YELLOW OWNER COPY (INITIAL): PINK