IREDELL COUNTY HEALTH DEPARTMENT

STATESVILLE 704-878-5305 MOORESVILLE 704-664-5281

IMPROVEMENT PERMIT / AUTHORIZATION TO CONSTRUCT / OPERATION PERMIT / EXISTING SYSTEM INSPECTION

PERMIT # 158788 PIN # 4629-78-3173 DATE 11-17-09

OWNER or APPLICANT Clay & Vickie Poindexter PHONE: Business 782-309-6619 Home: 336-918-3107

OWNER or APPLICANT ADDRESS 15044 marble Arch RD Winston Salem

LOCATION / DIRECTIONS 70 State Park RD (70) Morrison Farm (R) Seakirk 158 Sea Kirk

SUBDIVISION CLET BLOCK / SECTION LOT # 18 LOT AREA 1.86 DESIGN FLOW 360 L.T.A.R.

Septic Tank 1000 Gallons: STB 794 Date 10-3097

Pump Tank Gallons: P T Date

Pump Make Model Serial #

Nitrification Field No Fields 1 No Lines Linear Feet 300

Trench Width 36" Max. Trench Bottom Depth 36" Gravel Depth 6" stone

☑ New System ☐ Repair ☐ Expansion System Type I II (III) IV V VI

System Description: 25% Expand

Repair System Description: 50% Expand Less Pond

Maintenance Agreement Required ☐ YES ☑ NO

☐ GRAVITY ☑ PRESSURE

☑ Residence No. Bedrooms 3

☐ Business No. Persons

☐ Other No. Employees

☐ Slab ☐ Crawl Space

☑ Basement w/plumbing ☐ Basement w/o plumbing

Water Supply: ☑ Private ☐ Public ☐ Community

Comments / Conditions


There are 50 Chambers in 4 lines each line has inspection port

Comments / Conditions


INITIAL SITE SKETCH

(1) Daylight Basement 10' off Septic System

(2) Route Basement drains and Gutters away from system and repair

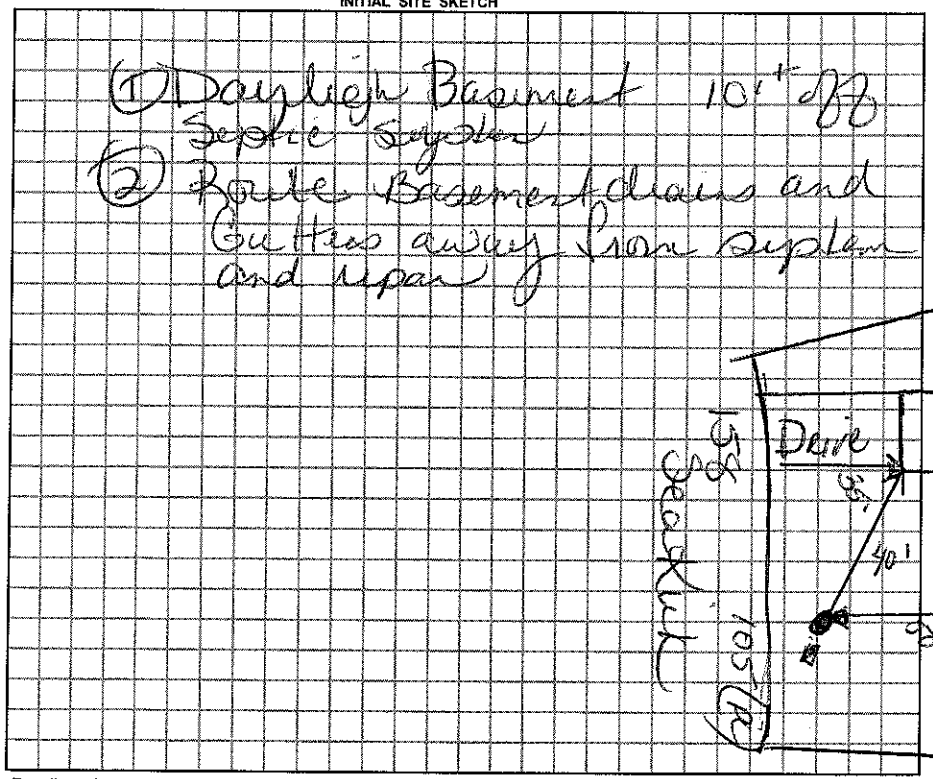

AS BUILT SKETCH

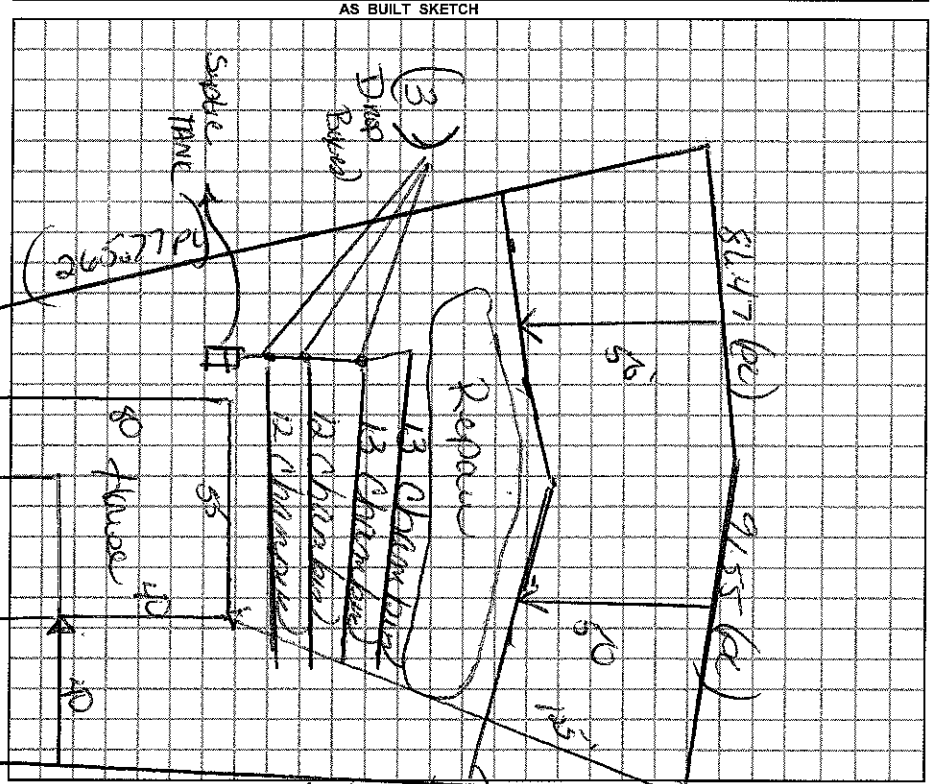

Permit can be suspended or revoked if any false information is supplied toward securing the permit / any unauthorized changes are made to the site / any unauthorized changes are made in the installation of the system.

☐ *IMPROVEMENT PERMIT w / plat valid without expiration.* ☑ *IMPROVEMENT PERMIT w / site plan valid for 60 mos.* ☐ *AUTHORIZATION TO CONSTRUCT valid for period equal to IMPROVEMENT PERMIT-not to exceed 60 mo.*

Owner / Applicant Signature: [signature] Date 11/17/09

Improvement Permit by: Date

Authorization to Construct by: Date

YOU SHOULD CONTACT A LOCATOR SERVICE PRIOR TO ANY EXCAVATION.

Installed by: Tim Ammons 3-3-98

Operation Permit by: Date:

Existing System Inspected by: Kurt Cox Date: 11-17-09

WHITE COPY Environmental Health YELLOW COPY (Final) Owner / Applicant PINK COPY (Initial) Owner / Applicant