IREDELL COUNTY HEALTH DEPARTMENT

permit # 43310 ??

STATESVILLE 704-878-5305 MOORESVILLE 704-664-5281

IMPROVEMENT PERMIT / CERTIFICATE OF COMPLETION / OPERATION PERMIT / EXISTING SYSTEM INSPECTION

PROPERTY DESCRIPTION NO. 19339 DATE 2-26-96 TAX MAP NO 3C-11-A-98 Watershed: Yes (No)

OWNER OR CONTRACTOR Ray Athan PHONE: Business Home

ADDRESS 2001 Martha Ellen Rd Yadkinville Rd

LOCATION Morrison Fm Rd JR Sea Kirk 1st Dr. NE WS IV-4

SUBDIVISION Lake Norman BLOCK / SECTION 18 LOT 98 LOT AREA 1.65 acres SITE CLASS PS DESIGN FLOW 240 L.T.A.R. .135

Septic Tank: 1000 Gallons: STB 238 Date 11-28-95

Pump Tank: ____ Gallons: PT ____ Date ____

Pump Make: ____ Model ____ Serial No. ____

Nitrification Field: No Fields 1 Square Feet 690 Linear Feet ~~230~~ 230

No Lines 3 Trench Width 36" Max Trench Bottom Depth 24" Gravel Depth 12"

✓ New System Repair System Type: I II III IV V VI

System Description: Shallow Conv. Gravity

Repair System Description: Pump to Gravelless Cham.

Maintenance Agreement Required Yes ✓ No

✓ House/Mod. Home No. Bedrooms 2

Mobile Home No. Bathrooms 1

Business No. Employees ____

Other ____


Slab ✓ Crawl Space Basement w/plumbing Basement wo/plumbing

Water Supply: ✓ Individual ☐ Community ☐ Public well next door


Comments: Run lines on contour + shallow Not over 24" Deep.

Comments: Building was not started at time of this inspection. Place building according to lay-out + sketch

INITIAL SITE SKETCH

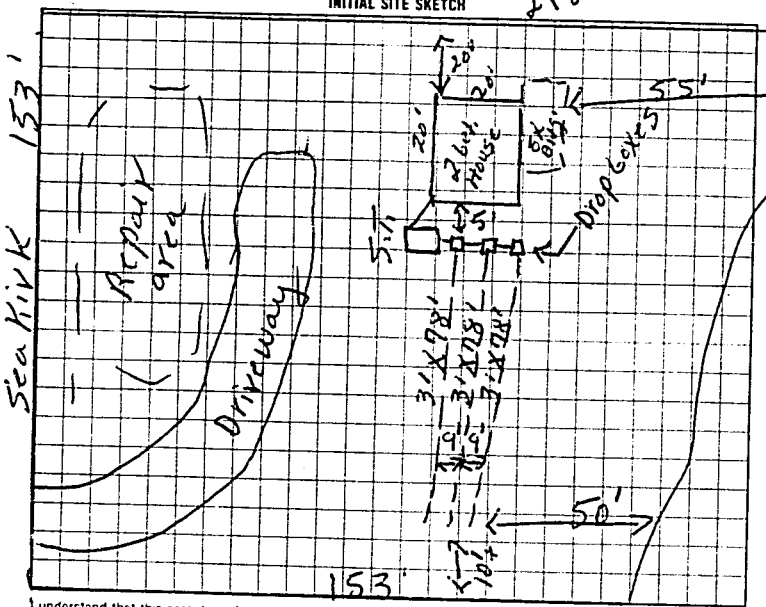

AS BUILT SKETCH

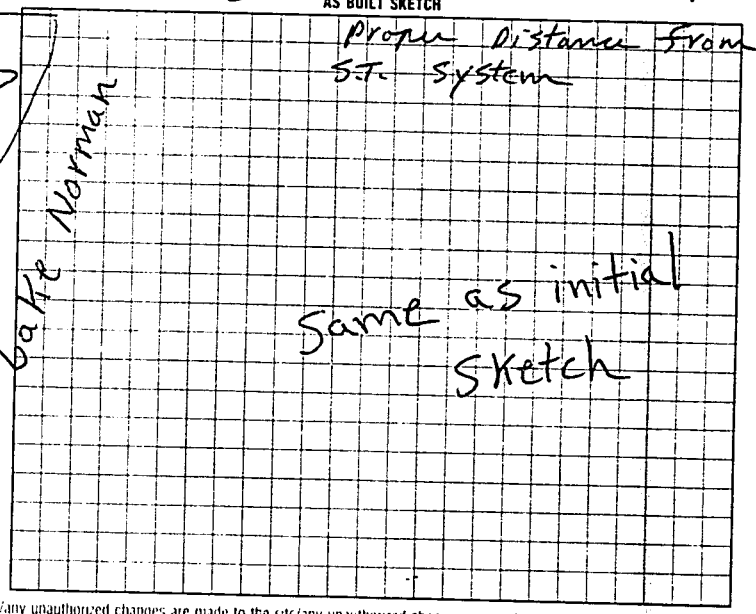

I understand that this permit can be suspended or revoked if any false information is supplied toward securing the permit/any unauthorized changes are made to the site/any unauthorized changes are made in the installation of the system

Signed X Ray E. Athan

Improvement Permit by R. C. Moore date 2-26-96 Installed by H.B. Salmon

Authorization Existing System Inspection by R. C. Moore date 2-26-96 Certificate of Completion by ____ date ____

to const HEALTH DEPT COPY WHITE INSPECTION COPY (FINAL) GREEN OWNER COPY (FINAL) YELLOW Operation Permit by R. C. Moore date 3-14-96

INSPECTION COPY (INITIAL) PINK OWNER COPY (INITIAL)

Authorization to const Expires 60 mos from issue