IREDELL COUNTY HEALTH DEPARTMENT

2-24-06 TANK V

STATESVILLE 704-878-5305 CI MOORESVILLE 704-664-5281

IMPROVEMENT PERMIT / AUTHORIZATION TO CONSTRUCT / OPERATION PERMIT / EXISTING SYSTEM INSPECTION

PERMIT# 124887 PIN# 4629-79-2210 DATE 2-13-06

OWNER OR CONTRACTOR ODELL STANLEY JR PHONE: Business 704-528-1919 Home

ADDRESS 199 WADDELL RD MOORESVILLE NC 28115

LOCATION PERTH RD SOUTH (R) State Park (L) Wildlife LOT ON RT BY LAST SHARP CURVE

SUBDIVISION CL+T BLOCK / SECTION LOT 802 LOT AREA 1.24 AC SITE CLASS PS DESIGN FLOW 360 L.T.A.R. .3

Septic Tank: 1000 Gallons; STB 825 Date ~~12-20-05~~ 12-20-06 ☒ New System ☐ Repair System Type: I, II, III, IV, V, VI

Pump Tank: Gallons; PT Date

Pump Make: Model Serial No.

Nitrification Field: No Fields 1 Square Feet EG=1200' Linear Feet 200'

No Lines 4x50 Trench Width 24" Max Trench Bottom Depth 36" Gravel Depth N/A

System Description: 60% 50% REDUCTION

Repair System Description: LP 50% REDUCTION

Maintenance Agreement Required: ☐ Yes ☒ No

☒ House/Mod. Home No. Bedrooms 3

☐ Mobile Home No. Bathrooms 2

☐ Business No. Employees

☐ Other

☐ Slab ☐ Crawl Space ☐ Basement w/plumbing ☒ Basement wo/plumbing


Water Supply: ☒ Individual ☐ Public ☐ Community

Comments/Conditions: (1) FILL & PACK OPEN FILL HOLE BY OR CAN BE SEEDED (2) NO VEHICULAR TRAFFIC OVER SEPTIC & RESERVE AREA. (3) SYSTEM IS completely flagged out & HOUSE IS BUILT 11-2003


"NOT TO SCALE"

Comments/Conditions: (4) INSTALL LINES ON CONTOURS & MAINTAIN SETBACKS (5) KEEP WELL 100' AWAY FROM SYSTEM DOES TO SAPROLITE,

INITIAL SITE SKETCH

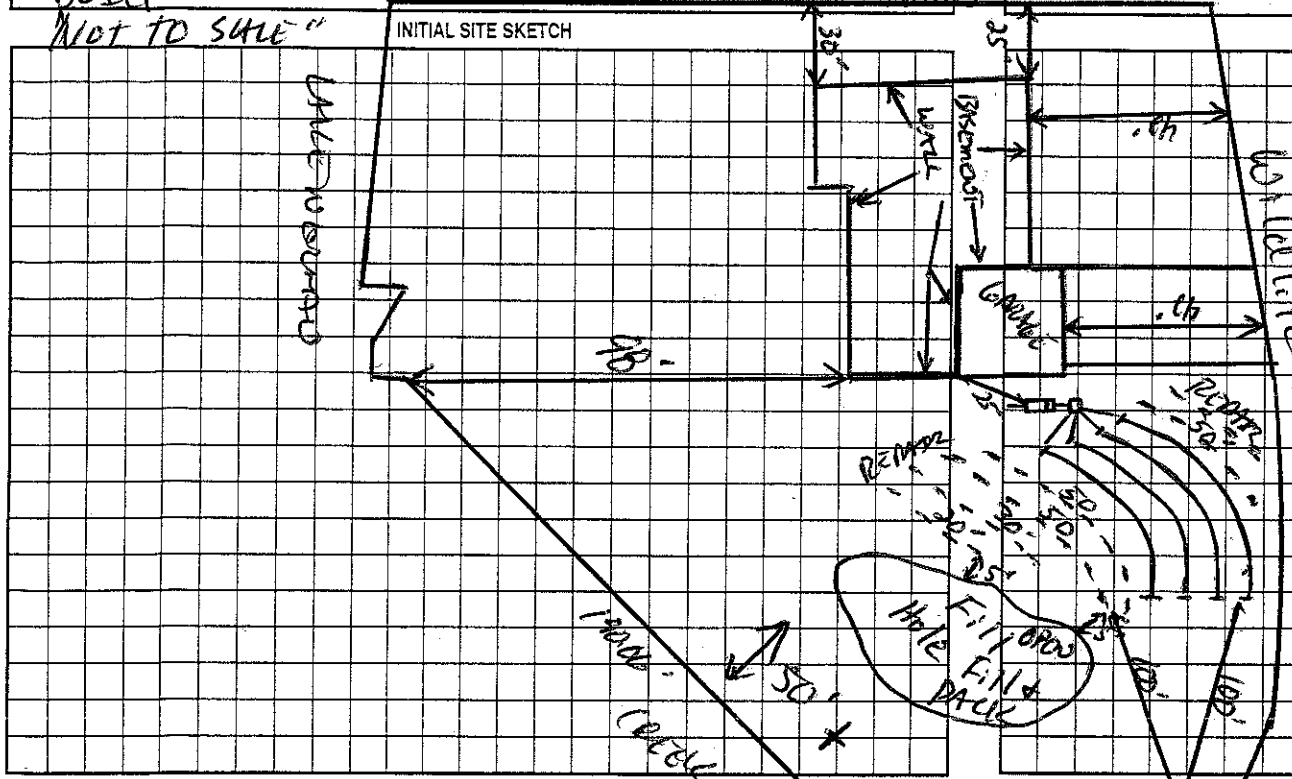

AS BUILT SKETCH

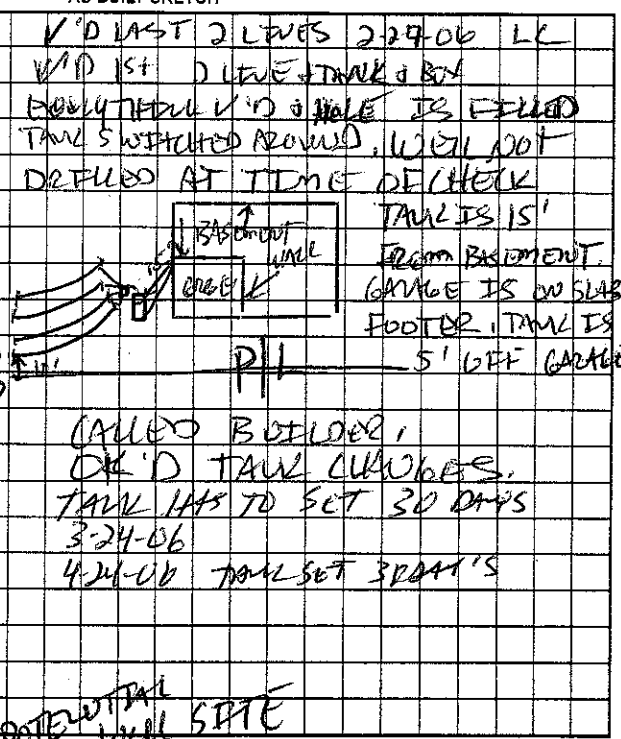

V'D LAST 2 LINES 2-24-06 LC

W/D 1ST 2 LINE & TANK & BOX

EQUALIZER LINE W/D & HOLE IS FILLED

TANK SWITCHED AROUND. WELL NOT DRILLED AT TIME OF CHECK

TANK IS 15' FROM BASEMENT. GARAGE IS ON SLAB & FOOTER. TANK IS 5' OFF GARAGE.

CALLED BUILDER, OK'D TANK CURVES. TANK HAS TO SET 30 DAYS

3-24-06

4-24-06 TANK SET 30 DAY'S

POTENTIAL WELL SITE

Permit can be suspended or revoked if any false information is supplied toward securing the permit/any unauthorized changes are made to the site/any unauthorized changes are made in the installation of the system. Improvement Permit with plat valid without expiration. Improvement Permit with site plan valid for sixty months. Authorization to Construct is valid for a period equal to that of Improvement Permit – not to exceed sixty months.

Signed: Jerry Weaver date

Improvement Permit by: date 2-13-06

Authorization to Construct by: date 2-13-06

Installed by: JOE THOMPSON

Operation Permit by: date ~~4-24-06~~ 4-24-06

Existing System Inspection by: date

HEALTH DEPT. COPY: WHITE OWNER COPY (FINAL): YELLOW OWNER COPY (INITIAL): PINK