*THIS PERMIT VOIDS PREVIOUS PERMIT, ISSUED 5-1-03.

IREDELL COUNTY HEALTH DEPARTMENT

STATESVILLE 704-878-5305 MOORESVILLE 704-664-5281

IMPROVEMENT PERMIT / AUTHORIZATION TO CONSTRUCT / OPERATION PERMIT / EXISTING SYSTEM INSPECTION

PERMIT# 083736 PIN# 4629-~~79-3294~~ 68-6908 DATE 05/06/03

OWNER OR CONTRACTOR ANTHAN J. MIFSUD PHONE: Business 704-576-6208 Home 704-453-1693

ADDRESS 12731 VANTAGE PT. LN. HUNTERSVILLE, NC 28078

LOCATION PERTH RD., (R) STATE PARK, (L) WILDLIFE RD., @ END OF WILDLIFE RD., ON RIGHT OF CUL-DE-SAC.

SUBDIVISION — BLOCK / SECTION — LOT — LOT AREA 1.73 ACRES SITE CLASS. PS DESIGN FLOW 360 GPD L.T.A.R. 0.30 GPD/FT²

Septic Tank: 1,000 Gallons; STB 350 Date 1-22-04
Pump Tank: 1,000 Gallons; PT 318 Date 7-15-03
Pump Make: ZOETHLOE Model N-137 Serial No. —
Nitrification Field: No Fields 1 Square Feet EQ to 1,200 Linear Feet 300
No Lines 5 @ 60' Trench Width 36" Max Trench Bottom Depth 36" Gravel Depth N/A

[X] New System [ ] Repair System Type: I, II, (III), IV, V, VI
System Description: PUMP, 25% REDUCTION
Repair System Description: LOW PRESSURE, 50% RED
Maintenance Agreement Required: [ ] Yes [X] No


[X] House/Mod. Home No. Bedrooms 3
[ ] Mobile Home No. Bathrooms 4½
[ ] Business No. Employees —
[ ] Other —
[ ] Slab [ ] Crawl Space [X] Basement w/plumbing [ ] Basement wo/plumbing

Water Supply: [X] Individual [ ] Public [ ] Community WELL


Comments:/Conditions: (1) CALL PRIOR TO INSTALLATION AFTER CLEARING FOR LINES TO BE REFLAGGED & FOR PUMP/PRESSURE MANIFOLD INFO., IF NEEDED.

Comments:/Conditions: V'D ST ON 3-4-04 V'D PT ON 3-5-04 LC
V'D LINES 3-8-04 V'D MANIFOLD TO LINES 3-9-04
V'D PRESSURE 3-11-04 NEEDS ELECTRICAL ✓ ELECTRICAL
EVERYTHING OK

INITIAL SITE SKETCH

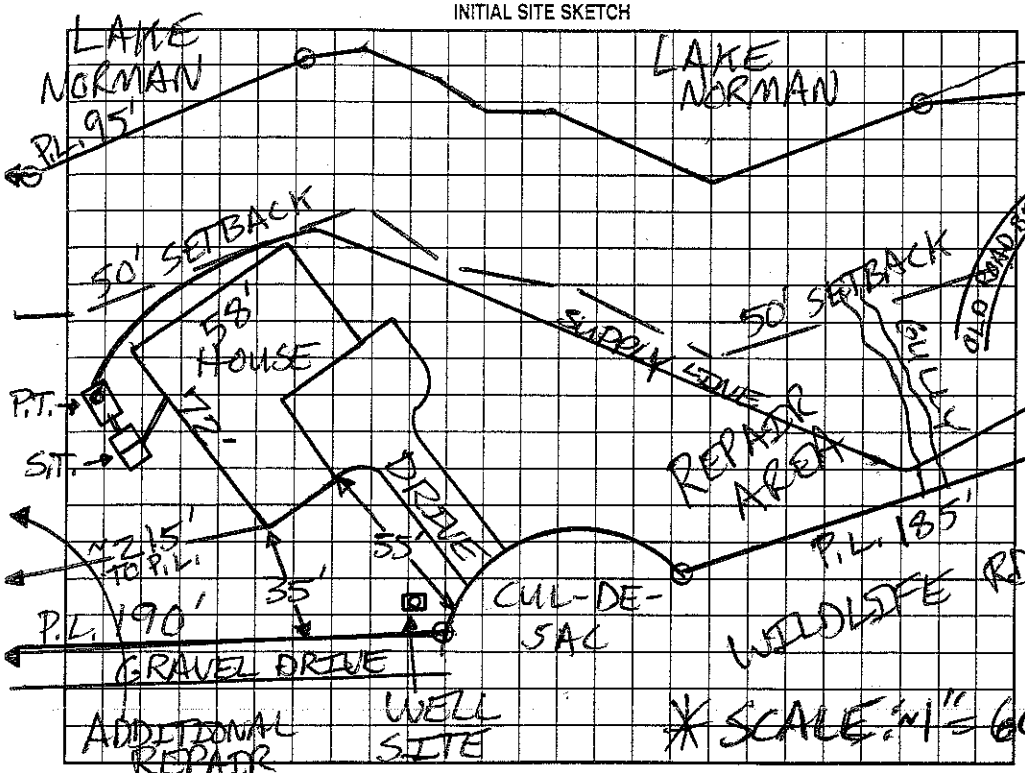

AS BUILT SKETCH

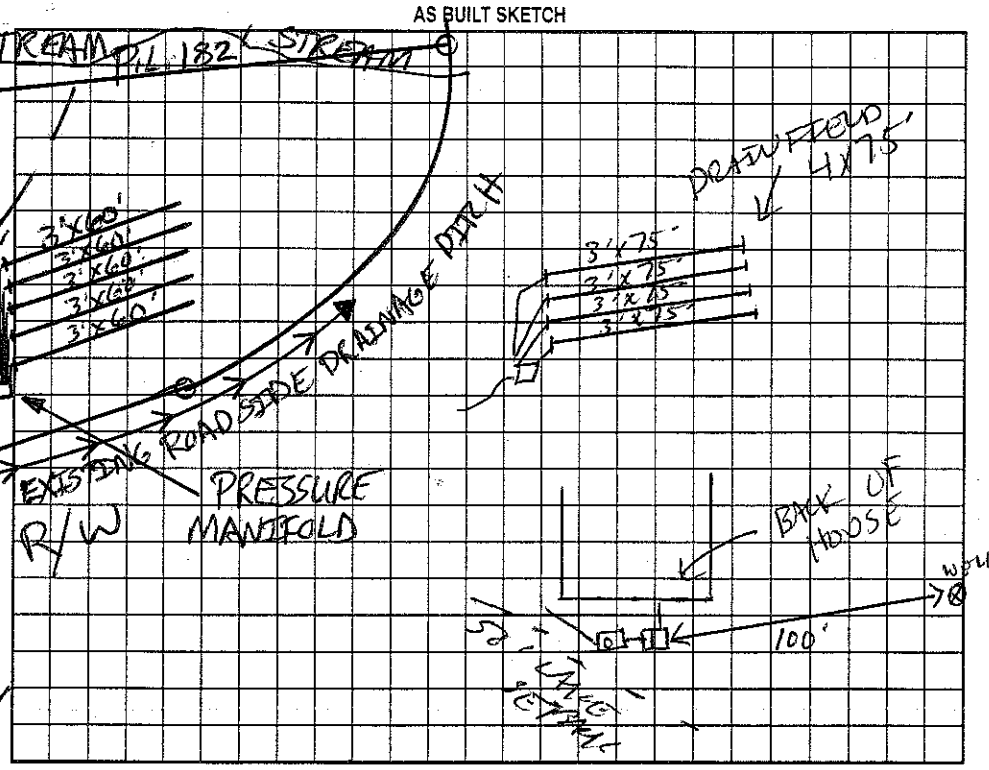

Permit can be suspended or revoked if any false information is supplied toward securing the permit/any unauthorized changes are made to the site/any unauthorized changes are made in the installation of the system. Improvement Permit with plat valid without expiration. Improvement Permit with site plan valid for sixty months. Authorization to Construct is valid for a period equal to that of Improvement Permit – not to exceed sixty months.

Signed: _____ date 5/6/03 Installed by: PIEDMONT SEPTIC

Improvement Permit by: _____ date 05/06/03 Operation Permit by: _____ date 3-22-04

Authorization to Construct by: _____ date 05/06/03 Existing System Inspection by: _____ date _____

HEALTH DEPT. COPY: WHITE OWNER COPY (FINAL): YELLOW OWNER COPY (INITIAL): PINK