IREDELL COUNTY HEALTH DEPARTMENT

STATESVILLE 704-878-5305 MOORESVILLE 704-664-5281

IMPROVEMENT PERMIT / AUTHORIZATION TO CONSTRUCT / OPERATION PERMIT / EXISTING SYSTEM INSPECTION

PERMIT# 72678 PIN# 4629802620 DATE 2-10-99

OWNER OR CONTRACTOR J. Douglas Webber PHONE: Business 3367968965 Home

ADDRESS 7031 Stanclift ct, Clemmons, N.C.

LOCATION State Pk Rd Turn Morrison Fm at Forks 1st lot Rt 898 Morrison Fm Rd

SUBDIVISION Morrison Pt BLOCK / SECTION LOT 8 LOT AREA 1/2 acre SITE CLASS PS DESIGN FLOW 360 L.T.A.R. 1.3

Septic Tank: 1000 Gallons; STB 794 Date 1-22-98
Pump Tank: 1000 Gallons; PT 794 Date 1-22-98
Pump Make: Hydromatic Model SH 50 Serial No. 1491
Nitrification Field: No. Fields 1 Square Feet 900 Linear Feet 300
No. Lines 3 Trench Width 36" Max Trench Bottom Depth 36" Gravel Depth N/A

New System ☐ Repair System Type: I ☐ II ☐ III ☑ IV ☐ V ☐ VI
System Description: Pump To Chambers
Repair System Description: Pump To Panels
Maintenance Agreement Required: ☐ Yes ☑ No


☑ House/Mod. Home No. Bedrooms 3
☐ Mobile Home No. Bathrooms 2
☐ Business No. Employees
☐ Other
☐ Slab ☐ Crawl Space ☑ Basement w/plumbing ☐ Basement wo/plumbing

Water Supply: ☑ Individual ☐ Public ☐ Community

Comments/Conditions: Plumbing Stub out was Too Deep To Get Gravity Flow This Permit Replaces Permit issued 6-23-98

Comments/Conditions: See Attached Sheets for P.T. P.M. + Cleanout Sheets

INITIAL SITE SKETCH

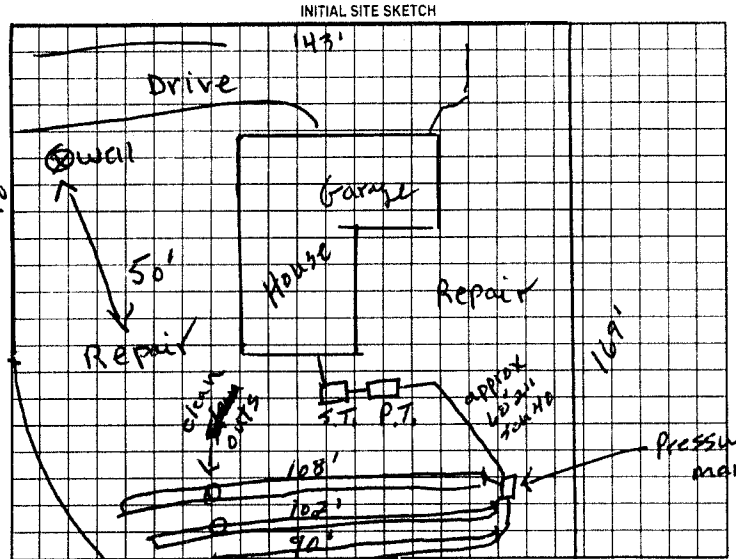

AS BUILT SKETCH

Inspected S.T. P.T. + PM
Dit Draw Down Test
2-23-99 JCM

Permit can be suspended or revoked if any false information is supplied toward securing the permit/any unauthorized changes are made to the site/any unauthorized changes are made in the installation of the system. Improvement Permit with plat valid without expiration. Improvement Permit with site plan valid for sixty months. Authorization to Construct is valid for a period equal to that of Improvement Permit – not to exceed sixty months.

Signed: David D. Bo date 2/15/99 Installed by: Rusty Orbison / Cayne Orbison

Improvement Permit by: P.C. Moore date 2-10-99 Operation Permit by: Mary C Ott RS date 3-8-99

Authorization to Construct by: P.C. Moore date 2-10-99 Existing System Inspection by: date

HEALTH DEPT COPY WHITE OWNER COPY (FINAL) YELLOW OWNER COPY (INITIAL) PINK