# IREDELL COUNTY HEALTH DEPARTMENT

STATESVILLE 704-878-5305 MOORESVILLE 704-664-5281 (1)

## IMPROVEMENT PERMIT / AUTHORIZATION TO CONSTRUCT / OPERATION PERMIT / EXISTING SYSTEM INSPECTION

PERMIT# 114467 PIN# 4629-80-4747 DATE 8-11-03

OWNER OR CONTRACTOR LINDA MOORE PHONE: Business Home 704-528-1073

ADDRESS 107 ADMIRAL LANE, TROUTMAN, NC 28166

LOCATION US 21 S TR PERTH, TR STATE PARK RD, TL MORRISON FARM RD, TL ADMIRAL LANE, 1ST HOUSE ON LEFT

SUBDIVISION MORRISON POINT BLOCK / SECTION LOT 3 & 4 LOT AREA 1.11 ACRES SITE CLASS. PS DESIGN FLOW 360 L.T.A.R. EXISTING

Septic Tank: EXISTING 1000 Gallons; STB Date

Pump Tank: Gallons; PT Date

Pump Make: Model Serial No.

Nitrification Field: No Fields 1 Square Feet 630 Linear Feet 84'

No Lines 1 BED Trench Width 7½' Max Trench Bottom Depth DEEP Gravel Depth

☐ New System ☐ Repair System Type: I (II) III, IV, V, VI

System Description: CONVENTIONAL, GRAVITY

Repair System Description:

Maintenance Agreement Required: ☐ Yes ☒ No

☒ House/Mod. Home No. Bedrooms 3

☐ Mobile Home No. Bathrooms 2½

☐ Business No. Employees

☐ Other

☒ Slab ☐ Crawl Space ☒ Basement w/plumbing ☐ Basement wo/plumbing


Water Supply: ☒ Individual ☐ Public ☐ Community WELL

Comments:/Conditions:

INITIAL SITE SKETCH

Comments:/Conditions:

AS BUILT SKETCH

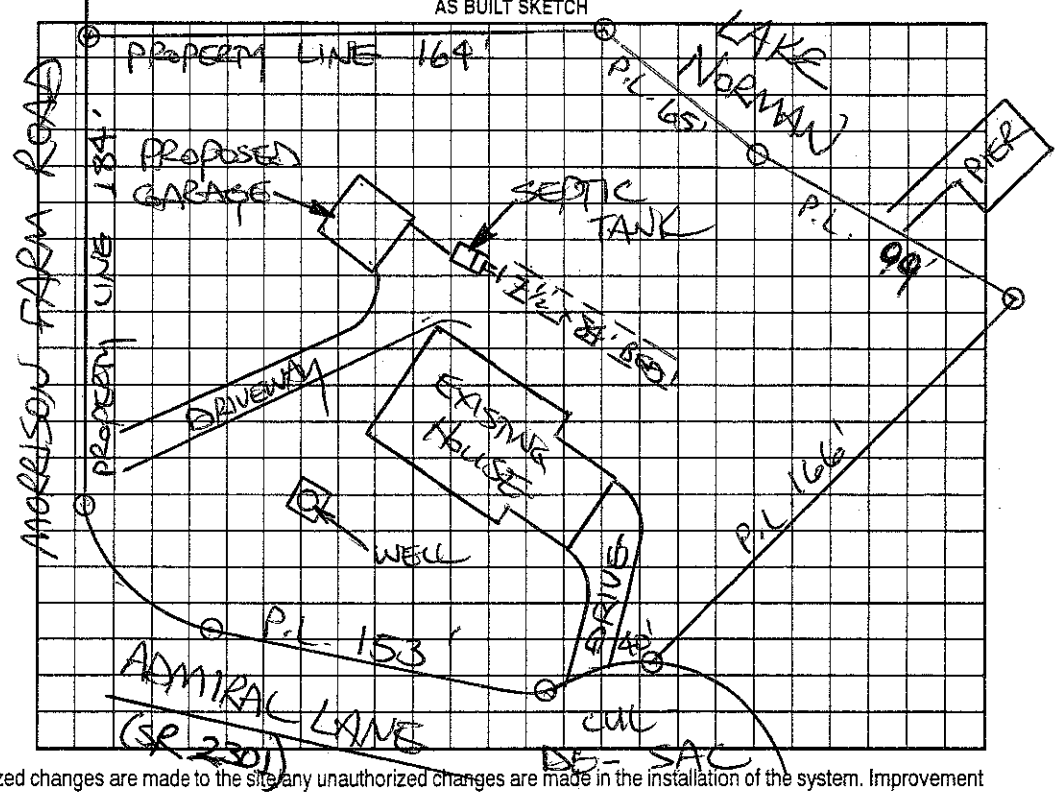


Permit can be suspended or revoked if any false information is supplied toward securing the permit/any unauthorized changes are made to the site/any unauthorized changes are made in the installation of the system. Improvement Permit with plat valid without expiration. Improvement Permit with site plan valid for sixty months. Authorization to Construct is valid for a period equal to that of Improvement Permit – not to exceed sixty months.

Signed: date Installed by:

Improvement Permit by: date Operation Permit by: date

Authorization to Construct by: date Existing System Inspection by: STEVE HERRICK date 8-11-03

HEALTH DEPT. COPY: WHITE OWNER COPY (FINAL): YELLOW OWNER COPY (INITIAL): PINK