IREDELL COUNTY HEALTH DEPARTMENT

Statesville Phone TR 3-7271 — Mooresville Phone NO 3-1271

PERMIT TO INSTALL SEPTIC TANK

Permit No. 173 — Permit Date 28 May 1970

Owner David Harmon — Address

Installed By Lackey Bros. — Address Stony Point, N.C.


Location of Property State Park Road #1321 to Morrison Point on Left.

Tank		Capacity		Length of Lines		Fixtures	
Block	( )	1000	(✓)	225'	(✓)	No. of Baths	(2)
Precast	(✓)	1250	( )	250'	( )	Dishwasher	( )
		1500	( )	Other		Garbage Grdr.	( )
		Other				Other	

NOTIFY HEALTH DEPARTMENT AT LEAST EIGHT HOURS BEFORE TANK IS TO BE INSPECTED.

Final Inspection 28 May 1970 — Approved (✓) Disapproved ( )

Remarks

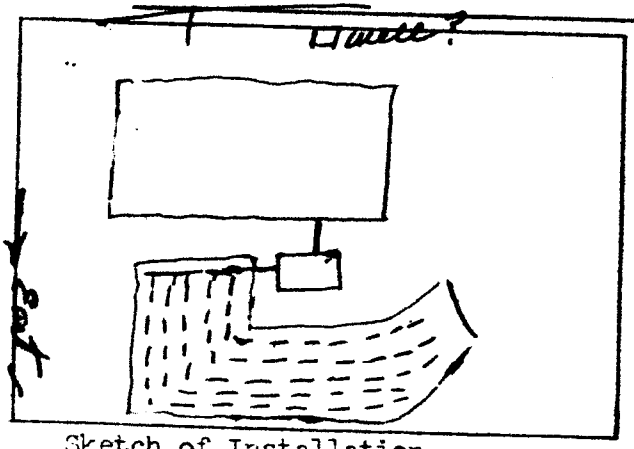

Sketch of Installation

Sanitarian