IREDELL COUNTY HEALTH DEPARTMENT - *ENVIRONMENTAL HEALTH* ☒ STATESVILLE OFFICE 704-878-5305 ☐ MOORESVILLE OFFICE 704-664-5281

IMPROVEMENT PERMIT / AUTHORIZATION TO CONSTRUCT / OPERATION PERMIT / EXISTING SYSTEM INSPECTION

PERMIT # 165247 PIN # 4629 81 1288 DATE March 3, 2011

OWNER Barry + Anna Gordon APPLICANT: Augusta Homes PHONE: Home/Cell # Business # 704 892 7795

SITE ADDRESS 763 Morrison Farm Rd. OWNER / APPLICANT ADDRESS

SITE DIRECTIONS Perth Rd Turn on State Park Rd. TL Morrison Farm Rd on left past 1st Allendale

SUBDIVISION Crescent L+T BLOCK / SECTION 17 LOT # 2 LOT AREA 0.8 Ac DESIGN FLOW 360 gpd L.T.A.R. .25 initial / .3 Repair

Septic Tank Ex 1000 Gallons: STB Date

Pump Tank Gallons: P T Date

Pump Make Model Serial #

No. Nitrification Fields: 1 No. Lines 1 Ex Linear Feet 60'

Trench Width 24" Max. Trench Bottom Depth 36" Gravel Depth NA

☐ New System ☐ Repair ☒ Expansion System Type I II (III) IV V VI

System Description: Gravity PPBPS

Repair System Description: Gravity PPBPS

Maintenance Agreement Required ☐ YES ☒ NO

☒ GRAVITY ☐ PRESSURE

☒ Residence No. Bedrooms 3

☐ Business No. Persons

☐ Other No. Employees

☐ Slab ☐ Crawl Space


☒ Basement w/plumbing ☐ Basement w/o plumbing

Water Supply: ☒ Private ☐ Public ☐ Community

Comments / Conditions Check existing septic tank for condition after pumping. Replace as needed. Set Drop Box between tank and existing bed and lead a gravity PPBPS trench 30' in each direction. Overflow to go back into existing bed. This permit is to upgrade septic system capacity from 2 bedroom to 3 bedrooms.

Polylok Filter

INITIAL SITE SKETCH

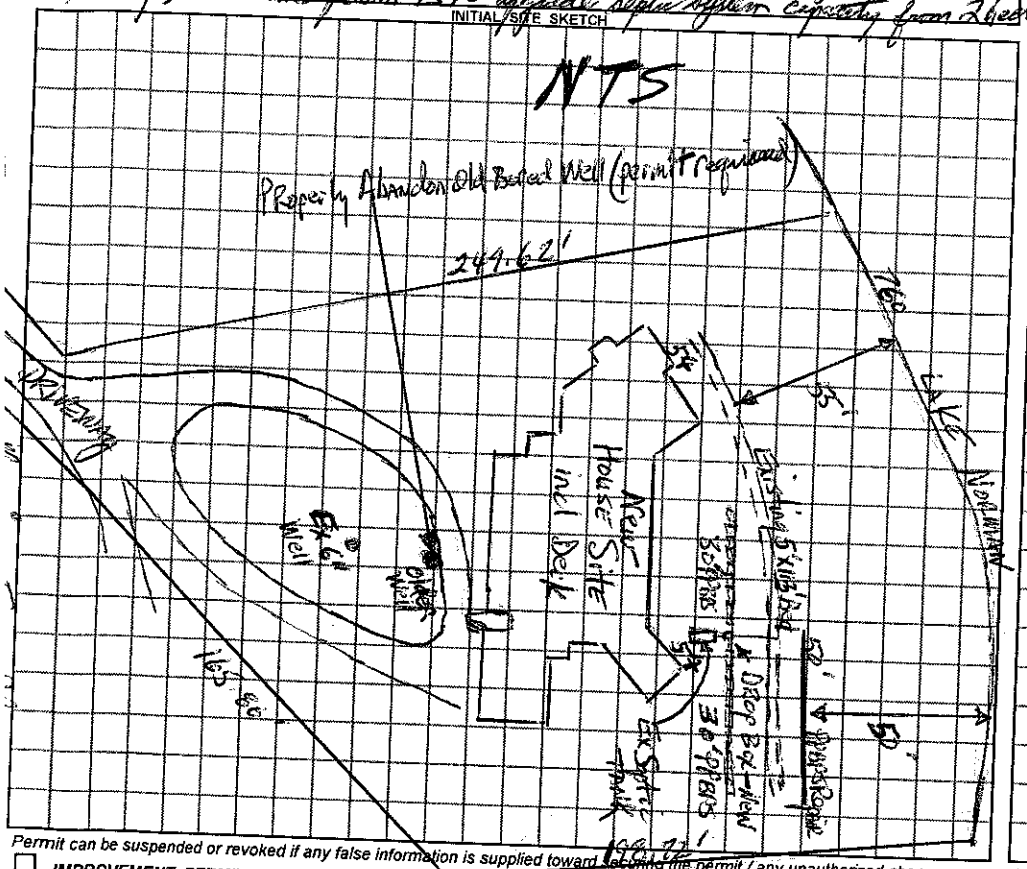

AS BUILT SKETCH

Installed as drawn on initial Site sketch.

Old bored well is 25' From House

Permit can be suspended or revoked if any false information is supplied toward securing the permit / any unauthorized changes are made to the site / any unauthorized changes are made in the installation of the system.

☐ ***IMPROVEMENT PERMIT*** with plat valid without expiration. ☒ ***IMPROVEMENT PERMIT*** with ~~plat valid without expiration~~ Site Plan valid 60 mos.

☒ ***AUTHORIZATION TO CONSTRUCT*** valid for period equal to IMPROVEMENT PERMIT--not to exceed 60 mo.

Owner / Applicant Signature: Barry Gordon Date 3/7/11

IMPROVEMENT PERMIT by: REHS Date 3-3-11

AUTHORIZATION TO CONSTRUCT by: REHS Date 3-7-11

YOU SHOULD CONTACT A LOCATOR SERVICE PRIOR TO ANY EXCAVATION

Installed by: R + H

OPERATION PERMIT by: REHS Date 14 Nov 11

Existing System Inspected by: REHS Date

White Copy -- Environmental Health YELLOW COPY (Final) Owner / Applicant PINK COPY (Initial) Owner / Applicant