IREDELL COUNTY HEALTH DEPARTMENT

Statesville Phone TR 3-7271 Mooresville Phone NO 3-1271

PERMIT TO INSTALL SEPTIC TANK

Permit NO. _____ Permit Date April 29 19 69

Owner Ken Lippard Bldr. Address City

Installed By _____ Address _____


Location of Property out old Patch Ch. Rd - Right onto 1321 hold thru end of hard top - left on dirt # [redacted] 1415 go ½ mile on R.

Tank		Capacity		Length of Lines		Fixtures	
Block	( )	1000	(L)	225'	(L)	No. of Baths	( )
Precast	(L)	1250	( )	250'	( )	Dishwasher	( )
Lock ☐		1500	( )	Other _____		Garbage Grdr.	( )
		Other _____				Other Cabin.	

NOTIFY HEALTH DEPARTMENT AT LEAST EIGHT HOURS BEFORE TANK IS TO BE INSPECTED.

Final Inspection _____ 19__ Approved ( ) Disapproved ( )

Remarks No well down this lot.

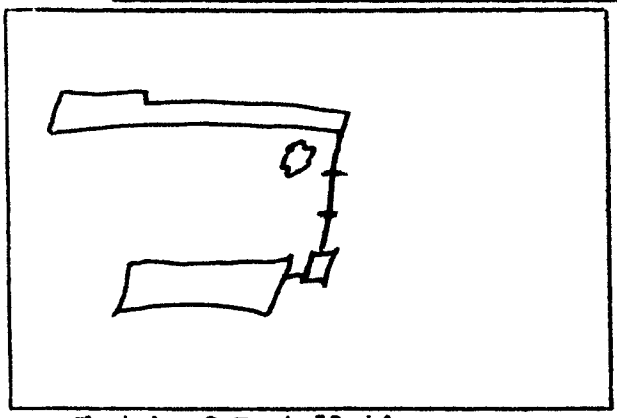

Sketch of Installation

Sanitarian