IREDELL COUNTY HEALTH DEPARTMENT

Statesville Phone TR 3-7271 Mcoresville Phone NO 3-1271

PERMIT TO INSTALL SEPTIC TANK

Permit No. _____ Permit Date July 3 19 69

Owner James Wilson Address City

Installed By C Hoke & Sons Address ?


Location of Property Lake Norman Sec 17-Lot 20
Past Bunnells - then end of hard top - left state
dirt - on left. Across from Paul Parlier

Tank		Capacity		Length of Lines		Fixtures	
Block	( )	1000	( )	225'	( )	No. of Baths	(2)
Precast	(✓)	1250	( )	250'	( )	Dishwasher	( )
		1500	( )	Other _____		Garbage Grdr.	( )
		Other _____				Other _____	

NOTIFY HEALTH DEPARTMENT AT LEAST EIGHT HOURS BEFORE TANK IS TO BE INSPECTED.

Final Inspection _____ 19___ Approved (✓) Disapproved ( )

Remarks Very deep - due to lay of land. to get off so. water & well - forced into deep ground. 5.5ft on low end of tank 8ft at tank & lines come up to about 5'. Not liable any thing due to grade land scape work

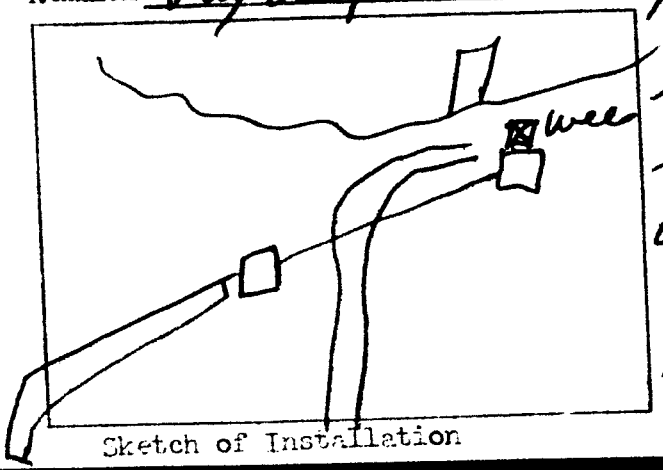

Sketch of Installation