IREDELL COUNTY HEALTH DEPARTMENT

Statesville Phone TR 3-7271 Mooresville Phone NO 3-1271

PERMIT TO INSTALL SEPTIC TANK

Permit No. _____ Permit Date July 2 1969

Owner James Wilson Address City

Installed By C. Hoke & Sons Address R 7

Location of Property Lab. Norman Sec 17 - Lot 20


Part Burnells - Thru end of hard top - left state dirt - on left across from Paul Parker

Tank	Separation	Length of Lines	Fixtures
Block	200	225'	No. of Baths (2)
Precast (✓)	250	250	Dishwasher ( )
Mark	300	Other _____	Garbage Disp. ( )
	Other _____		Other _____

NOTIFY HEALTH DEPARTMENT AT LEAST EIGHT HOURS BEFORE TANK IS TO BE INSPECTED.

Final Inspection _____ 19__ Approved (✓) Disapproved ( )

Remarks Very deep - due to lay of land, to get off 50' water & well - lines in deep ground - 5.5ft on low end of tank & at tank & lines come up to about 5' not liable any thing due to grade land slope

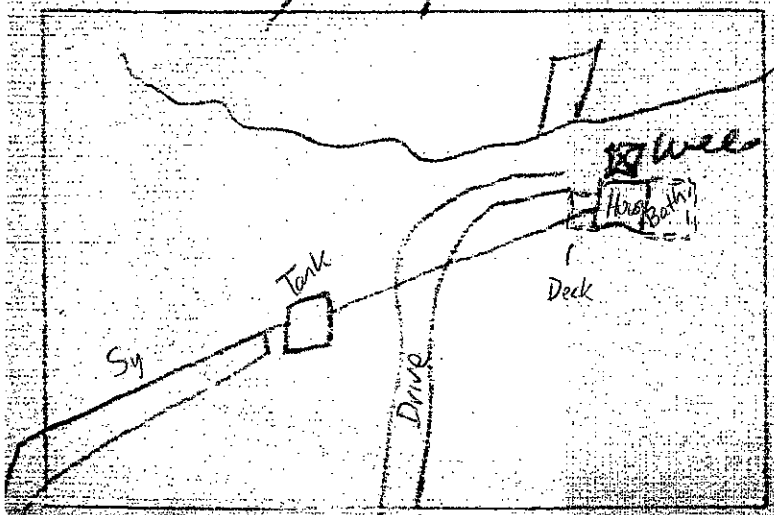

Sketch of Installation

The proposed Bathroom and deck addition does not appear to impact the existing septic system.

**NOTE: _____

_____ R.S.

Date: 3-9-10

CHD-Environmental Health Division

JAN. 1, 1989 18:59