PP. 200 1-21-98

4:30

IREDELL COUNTY HEALTH DEPARTMENT

STATESVILLE 704-878-5305 MOORESVILLE 704-664-5281

IMPROVEMENT PERMIT / AUTHORIZATION TO CONSTRUCT / OPERATION PERMIT / EXISTING SYSTEM INSPECTION

PERMIT# 971398 PIN# 4629821856 DATE 1-15-98

OWNER OR CONTRACTOR Michael J. Pasqual PHONE: Business ~~Morristown N.J.~~ Frontmen Home

ADDRESS 117 Cromdale Rd

LOCATION State Pk Rd Turn Morrison Farm Rd TL Willow PT TR Cromdale on left

SUBDIVISION Lake Norman Estates BLOCK / SECTION 17 LOT 34 LOT AREA 2.67 acres SITE CLASS PS DESIGN FLOW 360 L.T.A.R. .3

Septic Tank: 1000 Gallons; STB 794 Date 5-18-98

Pump Tank: 1000 Gallons; PT 17 Date 6-24-98

Pump Make: Hydromatic Model SHEF50 Serial No. 1/2 HP

Nitrification Field: No Fields 1 Square Feet 400 Linear Feet 200

No Lines 4 Trench Width 24" Max Trench Bottom Depth 36" Gravel Depth N/A

☑ New System ☐ Repair System Type: I, II, III, IV, V, VI

System Description: Pump to LPP Used Panels

Repair System Description:

Maintenance Agreement Required: ☐ Yes ☑ No

☑ House/Mod. Home No. Bedrooms 3

☐ Mobile Home No. Bathrooms 2

☐ Business No. Employees

☐ Other

☐ Slab ☐ Crawl Space ☑ Basement w/plumbing ☐ Basement wo/plumbing


Water Supply: ☑ Individual ☐ Public ☐ Community

Comments:/Conditions:


See Attached Sheets for Pump Tank & Drain line setup which are Part of This Permit.

Comments:/Conditions: Certified operator must be on contract before operations permit can be issued.

INITIAL SITE SKETCH

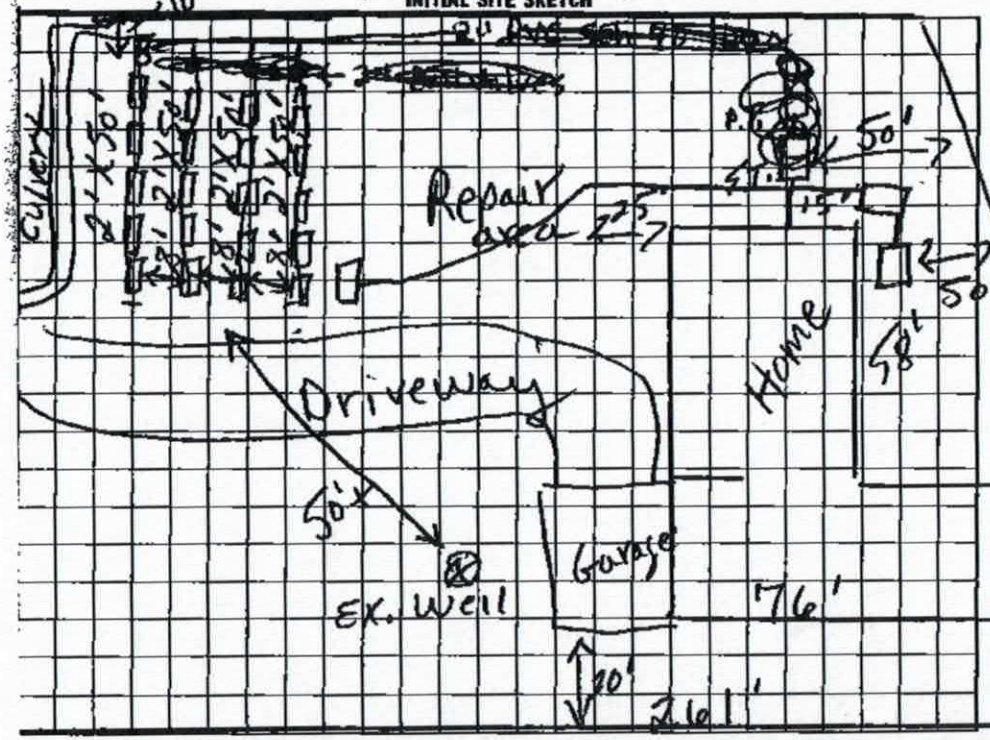

AS BUILT SKETCH

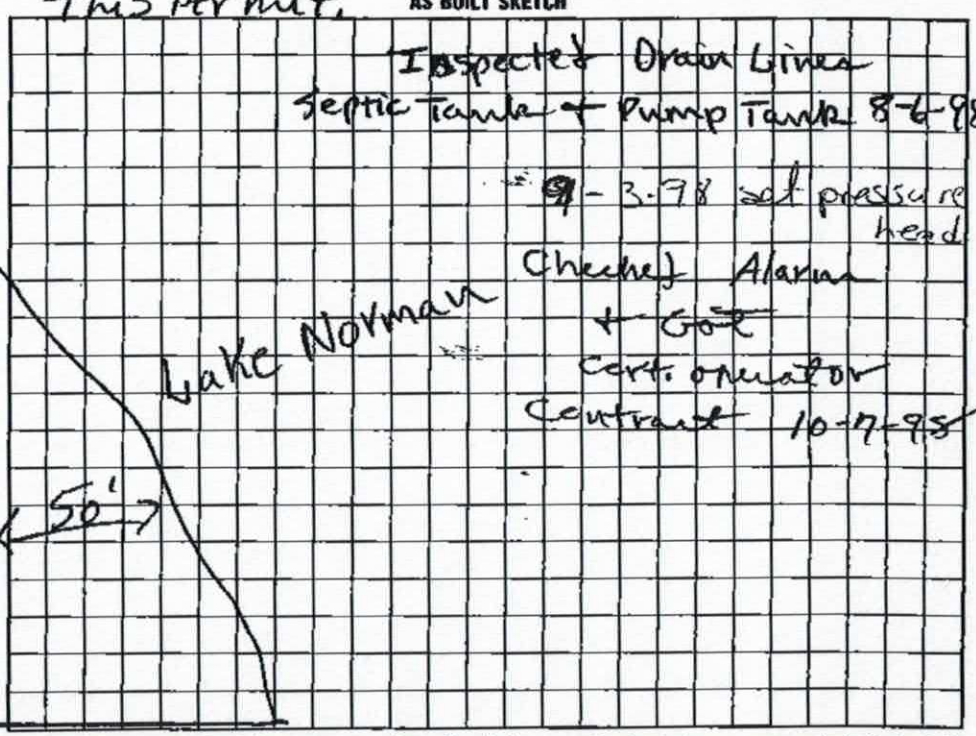

I understand that this permit can be suspended or revoked if any false information is supplied toward securing the permit/any unauthorized changes are made to the site/any unauthorized changes are made in the installation of the system. Improvement Permit with plat valid without expiration. Improvement Permit with site plan valid for sixty months. Authorization to Construct is valid for a period equal to that of Improvement Permit – not to exceed sixty months.

Signed: _____ date _____ Installed by: James Hudler

Improvement Permit by: P.C. Moore date 1-15-98 Operation Permit by: P.C. Moore date 10-7-98

Authorization to Construct by: P.C. Moore date 1-15-98 Existing System Inspection by: _____ date _____

HEALTH DEPT. COPY- WHITE INSPECTION COPY (FINAL)- GREEN OWNER COPY (FINAL)- YELLOW