pd. 200 1-27-95

Attn: Larry Beam

4:30

IREDELL COUNTY HEALTH DEPARTMENT

STATESVILLE 704-878-5305 MOORESVILLE 704-664-5281

IMPROVEMENT PERMIT / AUTHORIZATION TO CONSTRUCT / OPERATION PERMIT / EXISTING SYSTEM INSPECTION

DATE 1-15-98

PERMIT # 11398 PIN# 4629821856

OWNER OR CONTRACTOR Michael J. Pasqualone PHONE: Business ____ Home ____

ADDRESS 117 Crondale Rd. Morrisstown N.J.

LOCATION State Rt 62 Turn Morrison Farm Rd TL Willow PT TR Crondale on left

SUBDIVISION Lake Norman BLOCK / SECTION 17 LOT 34 LOT AREA .69 acres SITE CLASS PS DESIGN FLOW 360 I.T.A.R. .3

Septic Tank: 1000 Gallons; STB 794 Date 5-18-98

Pump Tank: 1000 Gallons; PT 17 Date 6-24-98

Pump Make: Myers Model SHE50 Serial No V2 440

Trenchless Field: No Fields 1 Square Feet 400 Linear Feet 200

No Lines 4 Trench Width 24" Max Trench Bottom Depth 36" Gravel Depth N/A

[ ] New System [ ] Repair System Type: I, II, III, (IV), V, VI

System Description: Pump to Lift Based Panels

Repair System Description: ____

Maintenance Agreement Required: [ ] Yes [X] No

[X] House/Mod. Home [ ] Mobile Home [ ] Business [ ] Other

No. Bedrooms 3 No. Bathrooms 2 No. Employees ____


[ ] Slab [ ] Crawl Space [X] Basement w/plumbing [ ] Basement w/o plumbing

Water Supply: [X] Individual [ ] Public [ ] Community


Comments/Conditions: See Attached Sheets For Pump Tank & Drain line setup which are Part of This Permit.

Comments/Conditions: Certified operator must be on contract before operations permit can be issued.

INITIAL SITE SKETCH

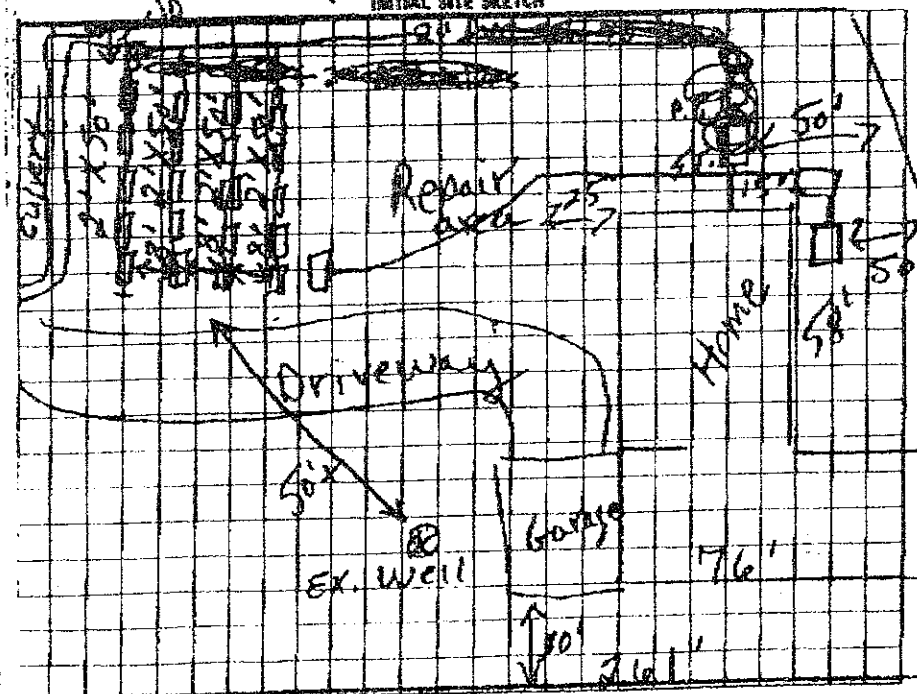

AS BUILT SKETCH

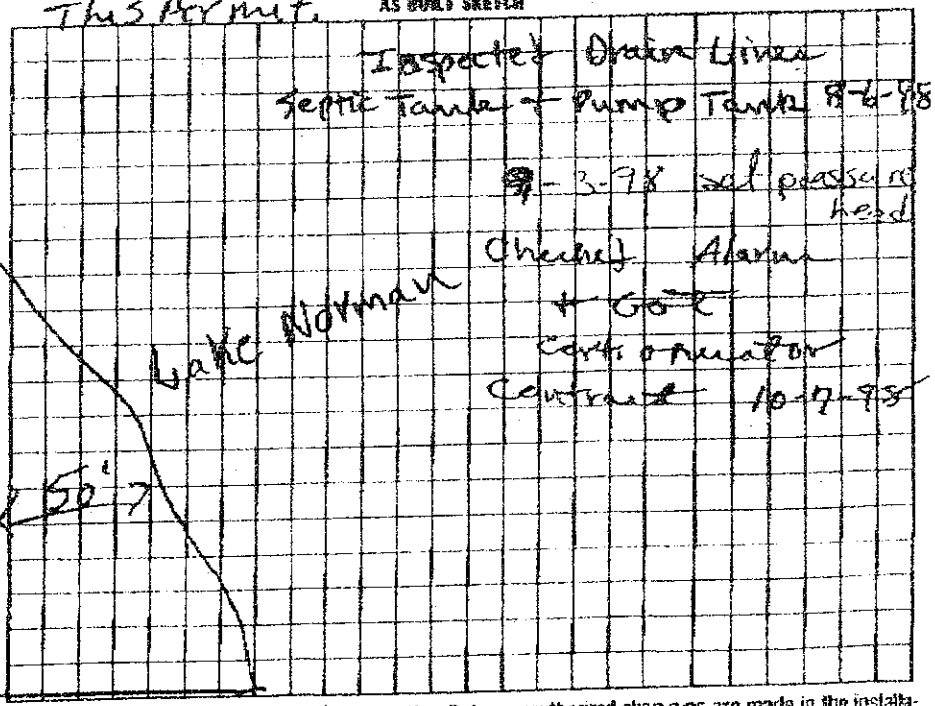

Inspected Drain Lines Septic Tank & Pump Tank 9-6-98

9-3-98 set pressure head

Checked Alarm & GFI

Certification Contract 10-7-98

I understand that this permit can be suspended or revoked if any false information is supplied toward securing the permit/any unauthorized changes are made to the site/any unauthorized changes are made in the installation of the system. Improvement Permit with plat valid without expiration. Improvement Permit with site plan valid for sixty months. Authorization to Construct is valid for a period equal to that of Improvement Permit – not to exceed sixty months.

Signed: ____ date ____ Installed by: James Hudler

Improvement Permit by: P.C. Moore date 1-15-98 Operation Permit by: P.C. Moore date 10-7-98

Authorization to Construct by: P.C. Moore date 1-15-98 Existing System Inspection by: ____ date ____

TOTAL P.01