IREDELL COUNTY HEALTH DEPARTMENT

STATESVILLE 704-878-5305 MOORESVILLE 704-664-5281

IMPROVEMENT PERMIT / CERTIFICATE OF COMPLETION / OPERATION PERMIT / EXISTING SYSTEM INSPECTION

PROPERTY DESCRIPTION NO. REPAIR DATE 2-28-96 TAX MAP NO

OWNER OR CONTRACTOR DICK AMBROSE PHONE Business 872-9261 Home 872-6407

ADDRESS 156 GREGORY RD STATESVILLE, NC 28677 Watershed: Yes ✓ No

LOCATION US 21 S, TR PERTH RD, TR STATE PARK RD, TL MORRISON FARM, TL WILLOWPOINT, TL AT END, 1ST ON (R)

SUBDIVISION BLOCK / SECTION LOT LOT AREA LIMITED SITE CLASS PS DESIGN FLOW 360 L.T.A.R. EXISTING

Septic Tank EXISTING Gallons: STB Date

Pump Tank Gallons: PT Date

Pump Make Model Serial No

Nitrification Field: No Fields 1 Square Feet 240 Linear Feet 40

No Lines RED 1 Trench Width 72" Max Trench Bottom Depth 36" Gravel Depth 24"

✓ New System Repair System Type I II III IV V

System Description: CONVENTIONAL GRAVITY

Repair System Description: CONV. GRAVITY

Maintenance Agreement Required Yes ✓ No

House/Mod. Home No Bedrooms 3

Mobile Home No Bathrooms 2½

Business No Employees

Other


Slab Crawl Space ✓ Basement w/plumbing Basement wo/plumbing

Water Supply: ✓ Individual Community Public WELL

Comments: ① INSTALL NEW DIST. BOX AT LOCATION SHOWN, ② INSTALL NEW 6'X40' BED AS FLAGGED USING 24" STONE. ③ KEEP SYSTEM MINIMUM 50' FROM 760' CONTOUR LINE, 10' FROM PROPERTY LINE.

Comments

INITIAL SITE SKETCH

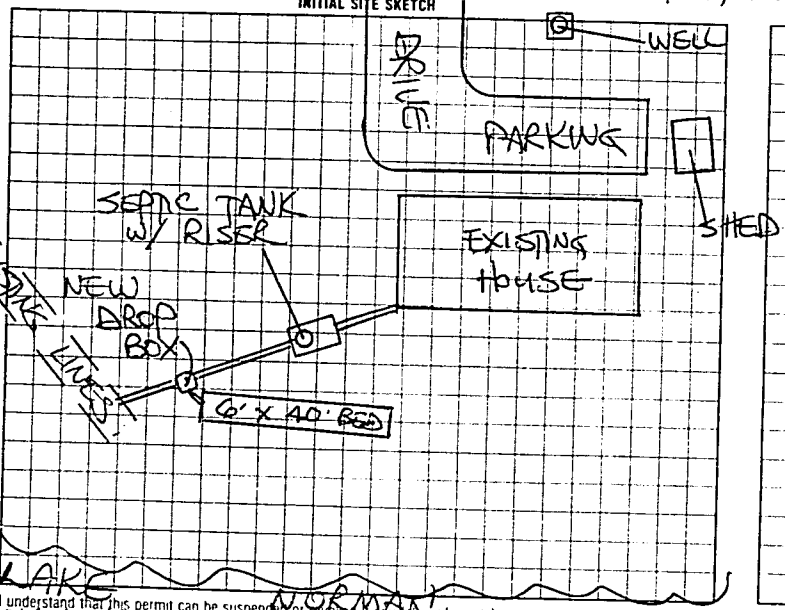

AS BUILT SKETCH

SYSTEM REPAIRED ACCORDING TO INITIAL SITE SKETCH

I understand that this permit can be suspended or revoked if any false information is supplied toward securing the permit, any unauthorized changes are made to the site, any unauthorized changes are made in the installation of the system

AUTHORIZATION TO CONSTRUCT IS VALID FIVE (5) YEARS FROM DATE OF AUTHORIZATION. IMPROVEMENT PERMIT HAS NO EXPIRATION DATE.

Signed X Dick Ambrose

Improvement Permit by: STEVE HEDRICK date 2-28-9

Authorization To Construct by STEVE HEDRICK date

Installed by WES LYTTON

Certificate of Completion by date

Operation Permit by STEVE HEDRICK date 4-25-96

HEALTH DEPT. COPY WHITE INSPECTION COPY (FINAL) GREEN OWNER COPY (FINAL) YELLOW INSPECTION COPY (INITIAL) PINK