77130

pd 950 6-12-96

IREDELL COUNTY HEALTH DEPARTMENT

Const. Auth. STATESVILLE 704-878-5305 MOORESVILLE 704-664-5281

IMPROVEMENT PERMIT / ~~CERTIFICATE OF COMPLETION~~ / OPERATION PERMIT / EXISTING SYSTEM INSPECTION

PROPERTY DESCRIPTION NO. 23305 DATE June 6, '96 TAX MAP NO. part of 2545I Watershed: ☒ Yes ☐ No

OWNER OR CONTRACTOR Easter Development Co. PHONE: Business _____ Home 664 2906

ADDRESS 227 Hideaway Lane, Mooresville

LOCATION Morgan Farm Rd. TL Willow Point Rd on Right just before Cromdale

SUBDIVISION Willow Point BLOCK / SECTION _____ LOT 2 LOT AREA .55 Ac SITE CLASS. B pm 1/2 DESIGN FLOW 360 gpd L.T.A.R. .3

Septic Tank: 1000 Gallons; STB 1012 Date 10-23-98

Pump Tank: _____ Gallons; PT _____ Date _____

Pump Make: _____ Model _____ Serial No. _____

Nitrification Field: No Fields 1 Square Feet 900 Linear Feet 300

No Lines 4 Trench Width 36" Max Trench Bottom Depth 36" Gravel Depth NA

☒ New System ☐ Repair System Type: I II (III) IV V VI

System Description: gravity chambered

Repair System Description: post. panel block

Maintenance Agreement Required ☐ Yes ☒ No

☒ House/Mod. Home No. Bedrooms 3

☐ Mobile Home No. Bathrooms 2

☐ Business No. Employees _____

☐ Other _____

☐ Slab ☒ Crawl Space ☐ Basement w/plumbing ☐ Basement wo/plumbing


Water Supply: ☒ Individual ☐ Community ☐ Public

Comments:

Comments:

1" = 40'

INITIAL SITE SKETCH

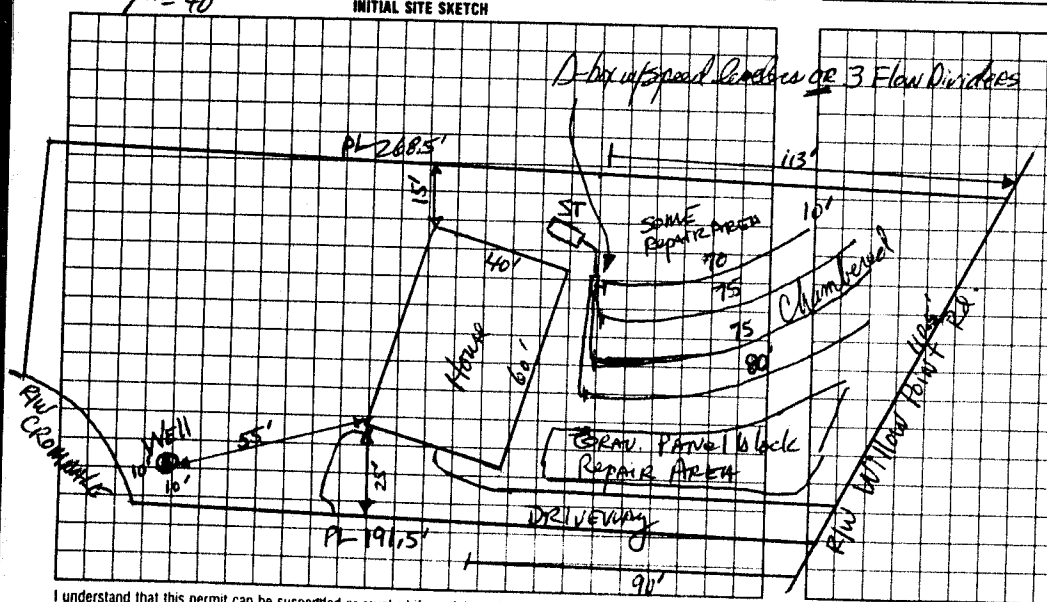

AS BUILT SKETCH

Same as initial sketch

I understand that this permit can be suspended or revoked if any false information is supplied toward securing the permit/any unauthorized changes are made to the site/any unauthorized changes are made in the installation of the system

Signed: _____

Improvement Permit by: Mark D. Stevenson, RS date 6-6-96

~~Construction~~ Authorization by: P. C. Moore date 9-30-98

Installed by Tommy Cothren

Certificate of Completion by _____ date _____

Operation Permit by P. C. Moore date 1-20-99

~~Existing System Inspection by~~

DEPT COPY WHITE INSPECTION COPY (FINAL) GREEN OWNER COPY (FINAL) YELLOW INSPECTION COPY (INITIAL) PINK OWNER COPY (INITIAL) GOLD