# IREDELL COUNTY HEALTH DEPARTMENT

Statesville Office (704) 878-5305 Mooresville Office (704) 660-3625 PERMIT # 211357

## IMPROVEMENT PERMIT / AUTHORIZATION TO CONSTRUCT / OPERATION PERMIT / EXISTING SYSTEM

PIN # 4629832710 ✓

APPLICANT: Live Well Homes APPLICANT ADDRESS: 501 Spring Crest Dr.

SITE ADDRESS: 642 Stillwater Rd. PHONE: 704-578-4951 ALT. PHONE: N/A

SITE DIRECTIONS: State Park Rd to Morrison Farm Rd TL Stillwater Rd.

SUBDIVISION: Falls Park SECTION: 3A LOT # 36 LOT AREA: 1.779 acres DESIGN FLOW: 480 gpd L.T.A.R.: 0.3

Septic Tank 1000 (gal) STB 444-1560 Date 8-7
Pump Tank (gal) PT Date
Pump Make Model Serial #
# Nitrification Fields 1 # Lines 6 Linear Ft: 535
Trench Width 36" Max. Trench Bottom Depth 48" high side Gravel Depth 12"

☑ New System ☐ Repair ☐ Expansion System Type: I (II) III IV V VI
System Description: Conventional
Repair System Description: Low Pressure PPBPS
Maintenance Agreement Required: ☐ YES ☑ NO
☑ GRAVITY ☐ PRESSURE

☑ Residence No. Bedrooms 4
☐ Business No. Persons 8
☐ Other No. Employees
☐ Slab ☑ Crawl Space
☐ Basement w/plumbing ☐ Basement w/o plumbing

Water Supply: ☐ Private ☑ Public ☐ Community

Comments / Conditions: ~~A~~ Install trench bottoms @ 48" on high side. An approved system CAN be installed without any reduction. ~~st~~

INITIAL SITE SKETCH

See attached design by:

Kathleen Saunders, LSS

AS BUILT SKETCH

- Red Poly/or filter installed
- Quick 4 Chambers installed
- Installed as drawn

*Permit can be suspended or revoked if any false information is supplied toward securing the permit / any unauthorized changes are made to the site / any unauthorized changes are made in the installation of the system.* **CONTACT A LOCATOR SERVICE PRIOR TO ANY EXCAVATION**

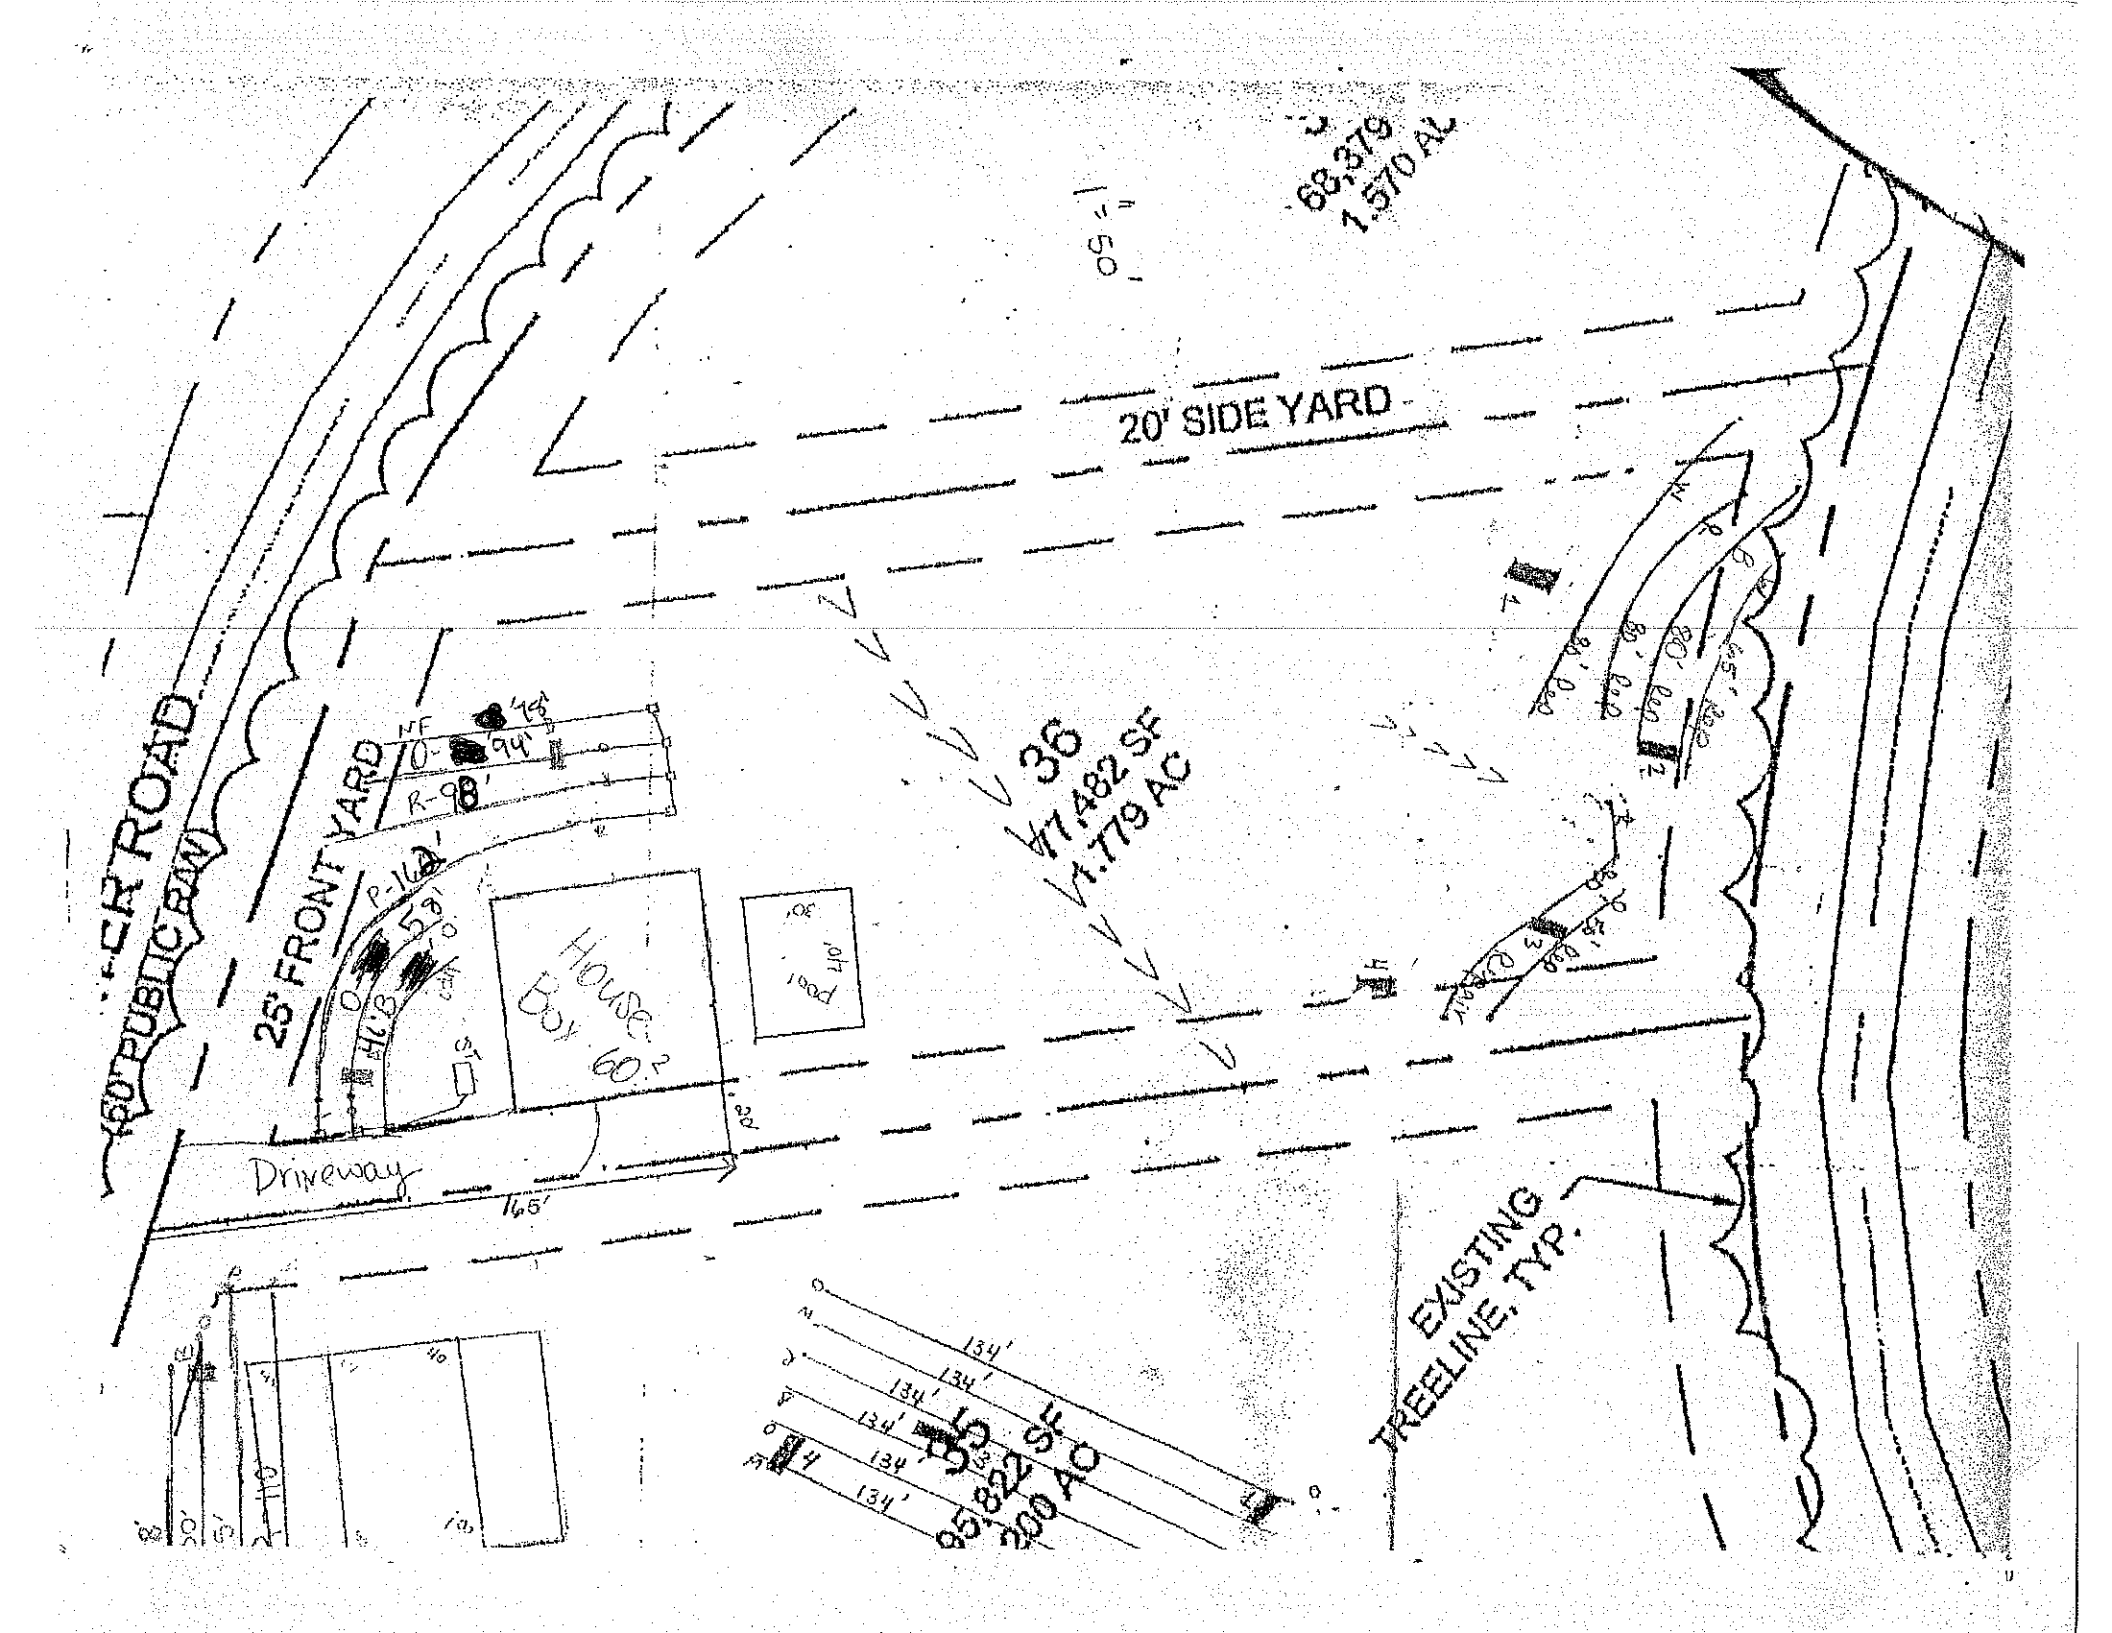
☐ **IMPROVEMENT PERMIT** *with plat valid without expiration.* ☑ **IMPROVEMENT PERMIT** *with site plan valid for 60 mos.* ☑ **AUTHORIZATION TO CONSTRUCT** *valid for period equal to IMPROVEMENT PERMIT--not to exceed 60 mo.*

Owner / Applicant Signature: Date: 7-6-15 Installed by: Wesson Septic Service

IMPROVEMENT PERMIT by: Justin Henderson Date: 8-5-15 OPERATION PERMIT by: Justin Henderson Date: 2-10-16

AUTHORIZATION TO CONSTRUCT by: Justin Henderson Date: 8-5-15 Existing System Inspected by: Date:

Health Dept. Copy - WHITE Applicant (Final Approval) - YELLOW Applicant (Conditional Approval) - PINK


68,379
1.570 AC
20' SIDE YARD
60' PUBLIC R/W
CR ROAD
25' FRONT YARD
36
71,482 SF
1.779 AC
HOUSE
BOX 60.2
Driveway
165'
EXISTING
TREELINE, TYP.
65,822 SF
1.511 AC