IREDELL COUNTY HEALTH DEPARTMENT

STATESVILLE 704-878-5305 MOORESVILLE 704-664-5281

IMPROVEMENT PERMIT / CERTIFICATE OF COMPLETION / OPERATION PERMIT / EXISTING SYSTEM INSPECTION

PROPERTY DESCRIPTION NO. 065567 DATE 5/29/97 TAX MAP NO. 4629841457 Watershed: ☑ Yes ☐ No

OWNER OR CONTRACTOR Luis F. Sowers PHONE: Business 872-2582 Home

ADDRESS 210 Hartness Road, Statesville NC 28677 WSII-CA

LOCATION

SUBDIVISION CLET BLOCK / SECTION 17 LOT 53 LOT AREA SITE CLASS. DESIGN FLOW L.T.A.R.

Septic Tank: Gallons; STB Date

Pump Tank: Gallons; PT Date

Pump Make: Model Serial No.

Nitrification Field: No Fields Square Feet Linear Feet

No Lines Trench Width Max Trench Bottom Depth Gravel Depth

☐ New System ☐ Repair System Type: I, II, III, IV, V, VI

System Description:

Repair System Description:

Maintenance Agreement Required: ☐ Yes ☐ No

☐ Slab ☐ Crawl Space ☐ Basement w/plumbing ☐ Basement wo/plumbing

☑ House/Mod. Home No. Bedrooms

☐ Mobile Home No. Bathrooms

☐ Business No. Employees

☐ Other

Water Supply:
☑ Individual
☐ Community
☐ Public
On Site

Comments:


Keep Rear of MH No Closer To Road Than Exist MH (5' minimum from Septic tank)

INITIAL SITE SKETCH

Comments:

Replace 2Br w/ 2 or 3Br System Sized for 3Br MH

AS BUILT SKETCH

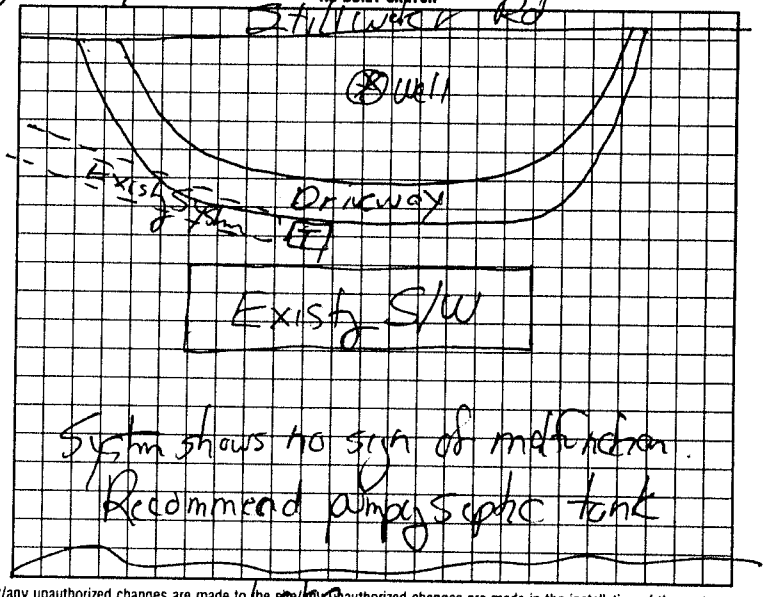

System shows no sign of malfunction.
Recommend pumping Septic tank

I understand that this permit can be suspended or revoked if any false information is supplied toward securing the permit/any unauthorized changes are made to the site/any unauthorized changes are made in the installation of the system. Improvement Permit is valid for 60 months from date of issuance.

Signed:

Improvement Permit by: date

Existing System Inspection by: date 5/29/97

Installed by:

Certificate of Completion by: date

Operation Permit by: date

HEALTH DEPT. COPY: WHITE INSPECTION COPY (FINAL): GREEN OWNER COPY (FINAL): YELLOW INSPECTION COPY (INITIAL): PINK OWNER COPY (INITIAL): GOLD