THIS PERMIT REPLACES PREVIOUS ISSUED 7-19-2007

IREDELL COUNTY HEALTH DEPARTMENT

STATESVILLE 704-878-5305 MOORESVILLE 704-664-5281

IMPROVEMENT PERMIT / AUTHORIZATION TO CONSTRUCT / OPERATION PERMIT / EXISTING SYSTEM INSPECTION

PERMIT# 139942 PIN# 4629-84-2962 DATE 4-8-2011

OWNER OR APPLICANT TIMOTHY TRUESDALE PHONE: Business 704-604-5374 Home 704-662-3856

ADDRESS 551 STILLWATER ROAD TROUTMAN NC 28166

LOCATION STATE PARK ROAD, TO MORRISON FARM ROAD, TL DAYVAULT CUT, TR STILLWATER RD, 0.75 MILE ON LEFT

SUBDIVISION CL & T BLOCK / SECTION 17 LOT 877 LOT AREA 1.1 ACRES SITE CLASS: PS DESIGN FLOW 480 L.T.A.R. 0.25 GPD/FT²

Septic Tank: 1000 Gallons: STB 794 Date 2/15/11
Pump Tank: 1000 Gallons: PT 283 Date 10/10/10
Pump Make: GOULDS Model WE07 12H Serial No. G088 1338
Nitrification Field: No Fields 1 Square Feet EQ. TO 1920 Linear Feet 320
No Lines 3 Trench Width 24" Max Trench Bottom Depth 36" Stone Depth 16"

☑ New System ☐ Repair ☐ Expansion System Type: I II III IV V VI
System Description: 50% REDUCTION, LOW-PRESS.
Repair System Description: 50% REDUCTION, LOW-PRESS.
Maintenance Agreement Required: ☑ Yes ☐ No

☑ House/Mod. Home No. Bedrooms 4
☐ Mobile Home No. Persons ____
☐ Business No. Employees ____
☐ Other ____


Water Supply: ☑ Individual ☐ Public ☐ Community

☐ Gravity ☑ Pressure ☐ Slab ☐ Crawl Space ☑ Basement w/plumbing ☐ Basement wo/plumbing


Comments/Conditions: INSTALL 50% REDUCTION SYSTEM AS SHOWN USING 76 PPBPS PANELS (23, 25, 28) USING LOW-PRESSURE DISTRIBUTION. SEE ATTACHED SHEETS FOR PUMP & LOW-PRESSURE DISTRIBUTION SPECIFICATIONS.

Comments/Conditions: A CONTRACT SHALL BE EXECUTED BETWEEN THE SYSTEM OWNER & A MANAGEMENT ENTITY PRIOR TO ISSUANCE OF THE OPERATION PERMIT

INITIAL SITE SKETCH

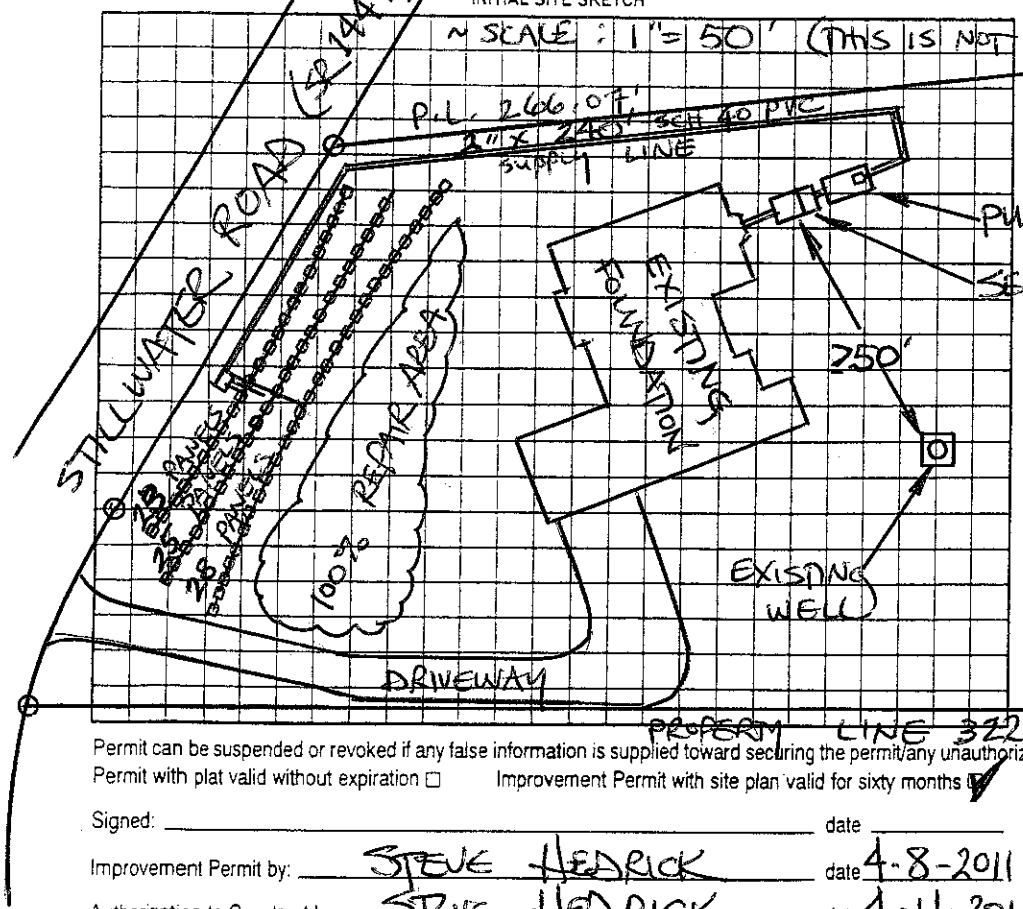

AS BUILT SKETCH

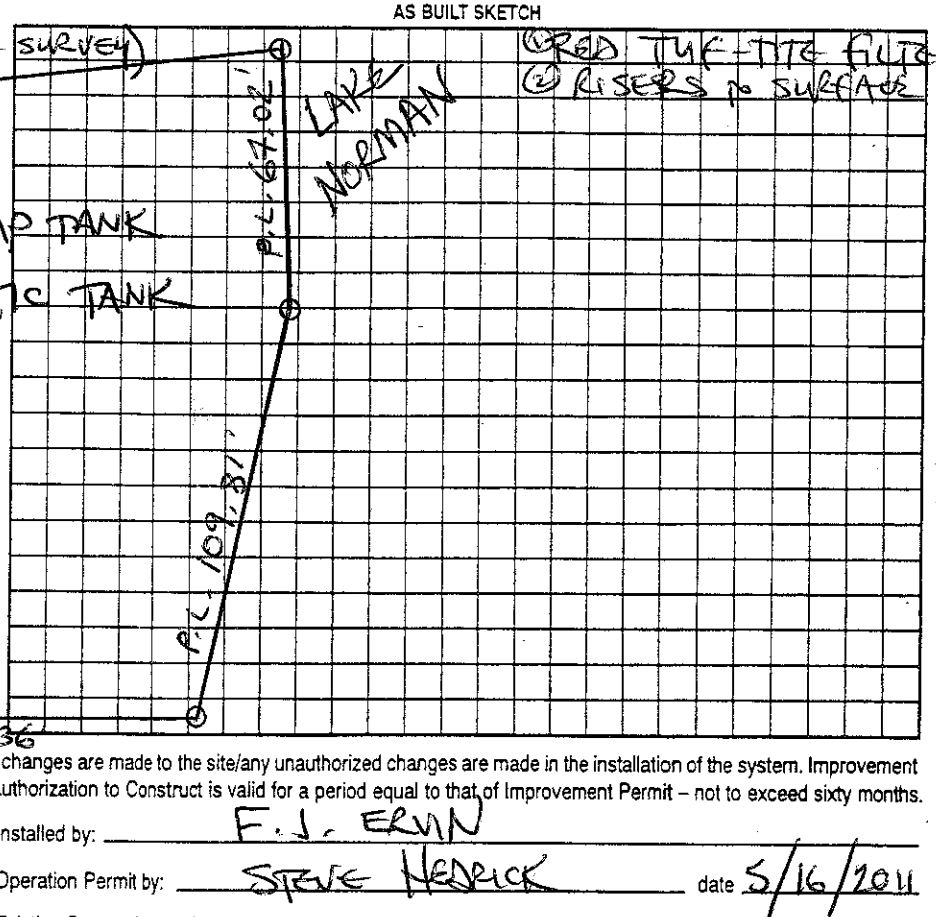

Permit can be suspended or revoked if any false information is supplied toward securing the permit/any unauthorized changes are made to the site/any unauthorized changes are made in the installation of the system. Improvement Permit with plat valid without expiration ☐ Improvement Permit with site plan valid for sixty months ☑ Authorization to Construct is valid for a period equal to that of Improvement Permit – not to exceed sixty months.

Signed: _____ date _____

Improvement Permit by: STEVE HEDRICK date 4-8-2011

Authorization to Construct by: STEVE HEDRICK date 4-11-2011

Installed by: F. J. ERVIN

Operation Permit by: STEVE HEDRICK date 5/16/2011

Existing System Inspection by: _____ date _____

PAID APR 11 2011
$305.00 - Comp. Reasont

HEALTH DEPT. COPY: WHITE OWNER COPY (FINAL): YELLOW OWNER COPY (INITIAL): PINK