IREDELL COUNTY HEALTH DEPARTMENT

Statesville Office (704) 878-5305 Mooresville Office (704) 660-3625 PERMIT # 210131

IMPROVEMENT PERMIT / AUTHORIZATION TO CONSTRUCT / OPERATION PERMIT / EXISTING SYSTEM

PIN # 4629-84-1968

APPLICANT: Jones Family Builders APPLICANT ADDRESS: 1020 Jones Rd Mt. Ulla NC

SITE ADDRESS: 551 Stillwater Rd PHONE: 704-400-7485 ALT. PHONE:

SITE DIRECTIONS: Hwy 115 S, R on Perth, R on State Park Rd, L on Morrison Farm, L on Dayvault, R on Stillwater, Loton L


SUBDIVISION: CL&T SECTION: 17 LOT # 876+877 LOT AREA: 2.17 ac DESIGN FLOW: 100 gpd L.T.A.R.: 0.2 I, 0.25 R

Septic Tank	1000	(gal)	STB 825-1000	Date	11-1-15	☑ New System ☐ Repair ☐ Expansion	System Type: I II III IV V VI	☐ Residence	No. Bedrooms	0	Water Supply
Pump Tank		(gal)	PT	Date		System Description:	Gravity At Grade 25% Reduction	☐ Business	No. Persons		☑ Private
Pump Make		Model		Serial #		Repair System Description:	PM 25% Reduction	☑ Other	No. Employees		☐ Public
# Nitrification Fields	1	# Lines	2	Linear Ft:	128'	Maintenance Agreement Required:	☐ YES ☑ NO	☐ Slab	☐ Crawl Space		☐ Community
Trench Width	36"	Max. Trench Bottom Depth	12" Low side	Gravel Depth	N/A	☑ GRAVITY	☐ PRESSURE	☐ Basement w/plumbing	☐ Basement w/o plumbing		


Comments / Conditions: *12" maximum trench bottom. Minimum 6" of suitable cover to be brought in, recommend 12". *No bedrooms in addition plumbing for bathrooms only and kitchenette, no full kitchen.

Garage / Office

INITIAL SITE SKETCH

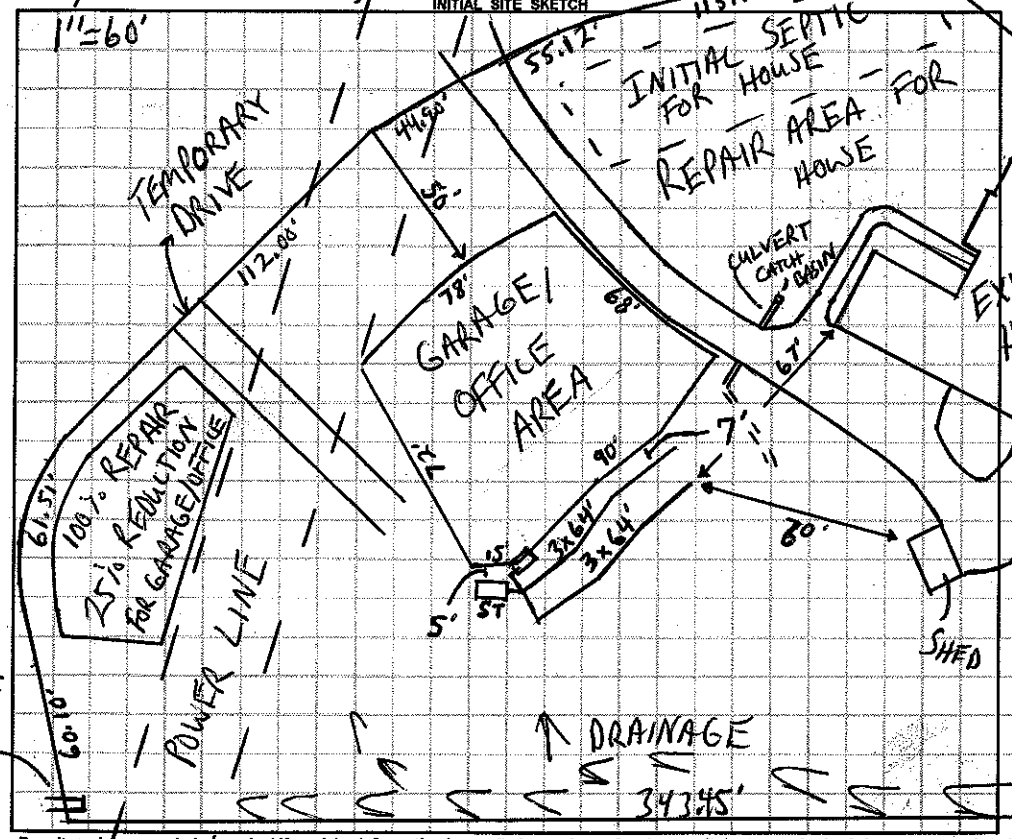

AS BUILT SKETCH

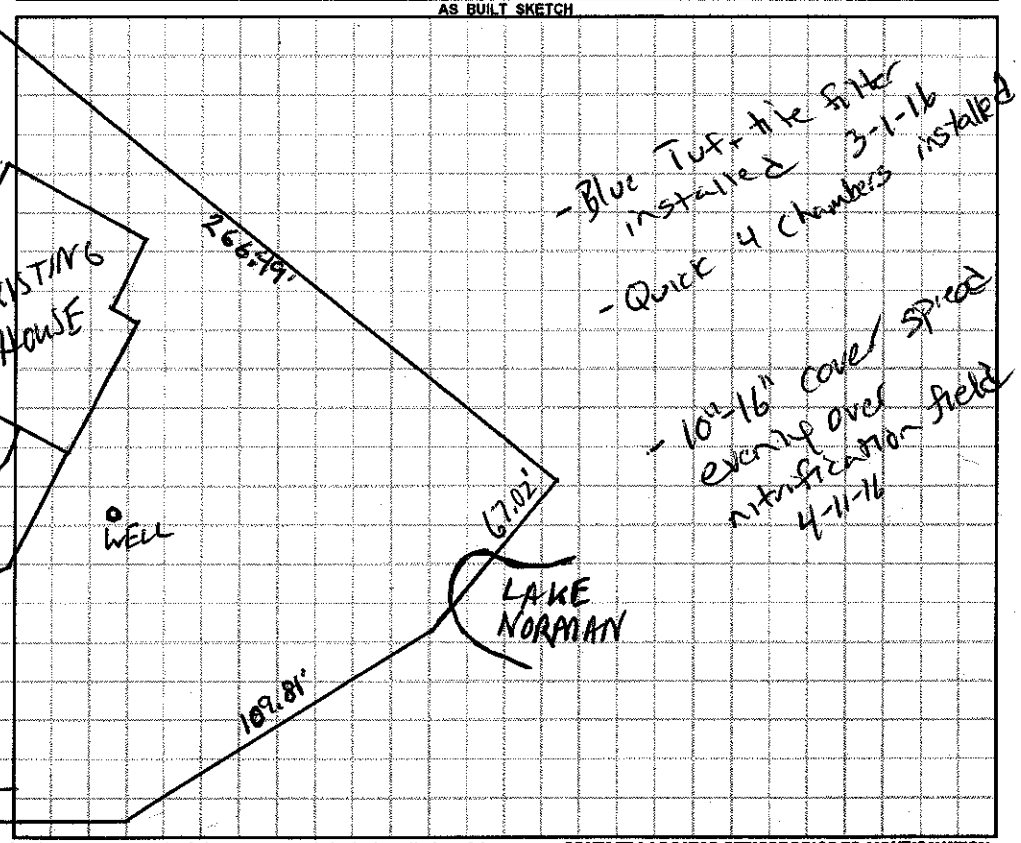

Permit can be suspended or revoked if any false information is supplied toward securing the permit / any unauthorized changes are made to the site / any unauthorized changes are made in the installation of the system. **CONTACT A LOCATOR SERVICE PRIOR TO ANY EXCAVATION**

☐ **IMPROVEMENT PERMIT** *with plat valid without expiration.* ☑ **IMPROVEMENT PERMIT** *with site plan valid for 60 mos.* ☑ **AUTHORIZATION TO CONSTRUCT** *valid for period equal to IMPROVEMENT PERMIT--not to exceed 60 mo.*

Owner / Applicant Signature: Judy Jones Date: 6-11-15 Installed by: Rowan Septic

IMPROVEMENT PERMIT by: Date: 6-9-15 OPERATION PERMIT by: Date: 4-11-16

AUTHORIZATION TO CONSTRUCT by: Date: 6/11/15 Existing System Inspected by: Date:

Health Dept. Copy - WHITE Applicant (Final Approval) - YELLOW Applicant (Conditional Approval) - PINK