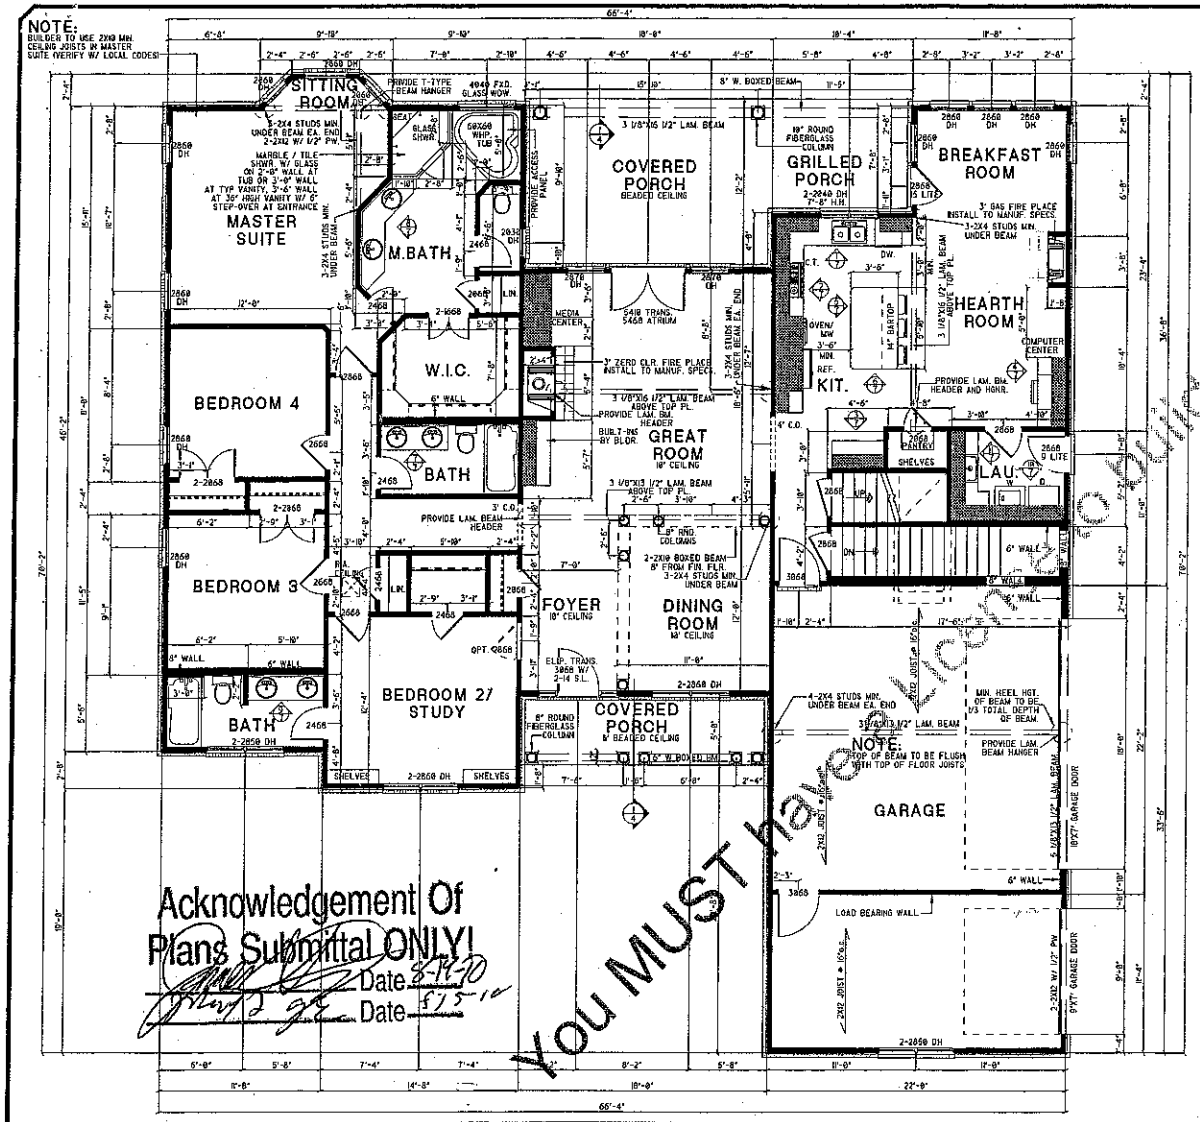


STOP! DID YOU KNOW?


The license purchased for this NDG home plan only allows this plan to be built one time, and does not transfer any right, title, or interest in the plan or the copyright thereto to the purchaser or persons involved in the building process. A license must be purchased each time the plan is used for construction.

Such plans are copyrighted. Nelson Design Group

FLOOR PLAN NOTES:

1. ALL STRUCTURAL INFORMATION SHOWN FOR REFERENCE PURPOSES ONLY. CONTRACTOR SHALL HAVE LICENSED STRUCTURAL ENGINEER REVIEW AND DESIGN ALL STRUCTURAL ELEMENTS SUCH AS ALL FRAMING WALLS, BEAMS, CONNECTIONS, HEADERS, JOISTS AND RAILERS.
2. ALL DIMENSIONS ARE FROM FACE OF STUD TO FACE OF STUD UNLESS NOTED OTHERWISE.
3. WINDOW SIZES INDICATED ON PLANS ARE NOTED BY APPROXIMATE ROUGH OPENING SIZE, REFER TO PLANS AND EXTERIOR ELEVATIONS FOR WINDOW TYPES.
4. COORDINATE LOCATION OF UTILITY METERS WITH SITE PLAN AND LOCATE AWAY FROM PUBLIC VIEW. VISUAL IMPACT SHALL BE MINIMIZED, I.E. MOUNT AS LOW AS POSSIBLE.
5. PREFABRICATED FIREPLACE CONSTRUCTION SHALL MEET OR EXCEED ALL APPLICABLE CODES REGARDING USE OF FIRE SEPARATIONS, CLEARANCES, ETC. IT IS THE CONTRACTOR'S RESPONSIBILITY TO ENSURE THAT ALL ITEMS AND CONSTRUCTION MEET OR EXCEED CODE. OVERALL FLUE HEIGHT SHALL BE COORDINATED TO MATCH HEIGHT SHOWN ON PLANS AND SHALL NOT EXCEED THE TOP OF CHIMNEY CHASE AS CONSTRUCTED.
6. CONTRACTOR SHALL COORDINATE ALL CLOSET SHELVING REQUIREMENTS.
7. DO NOT SCALE DRAWINGS, FOLLOW DIMENSIONS ONLY.
8. CONTRACTOR SHALL FIELD VERIFY ALL CABINET DIMENSIONS BEFORE FABRICATION.
9. BEDROOM WINDOWS SHALL HAVE A MINIMUM NET CLEAR OPENING OF 5.7 SQ.FT. A MINIMUM NET CLEAR OPENABLE WIDTH OF 20". A MINIMUM NET CLEAR OPENABLE HEIGHT OF 24" AND HAVE A MAXIMUM FINISH SILL HEIGHT OF 43" FROM FINISH FLOOR.
10. ALL GLASS LOCATED WITHIN 18" OF FLOOR, 12" OF A DOOR OR LOCATED WITHIN 60" OF FLOOR AT BATHTUBS, WHIRLPOOLS, SHOWERS, SAUNAS, STEAM ROOMS OR HOT TUBS SHALL BE TEMPERED.
11. ALL EXPOSED INSULATION SHALL HAVE A FLAME SPREAD RATING OF LESS THAN 25 AND A SMOKE DENSITY RATING OF LESS THAN 450.
12. PROVIDE COMBUSTION AIR VENTS, WITH SCREEN AND BACK DAMPER, FOR FIREPLACES, WOOD STOVES AND ANY APPLIANCE WITH AN OPEN FLAME.
13. BATHROOMS AND UTILITY ROOMS SHALL BE VENTED TO THE OUTSIDE WITH A MINIMUM OF A 50 CFM FAN. RANGE HOODS SHALL ALSO BE VENTED TO OUTSIDE.
14. ATTIC HVAC UNITS SHALL BE LOCATED WITHIN 20' OF ITS SERVICE OPENING. RETURN AIR GRILLES SHALL NOT BE LOCATED WITHIN 10 FEET OF A GAS FIRED APPLIANCE.
15. ALL WALLS AND CEILINGS IN GARAGE AND GARAGE STORAGE AREAS TO HAVE 5/8" TYPE-X GYP. BOARD W/ 1-HOUR FIRE-RATING. ALL EXT. DOORS IN GARAGE TO BE METAL OR SOLID CORE DOORS INCLUDING DOORS ENTERING HEAT/COOLED PORTION OF RESIDENCE.
16. ALL FIREPLACE CHASE WALLS SHALL BE INSULATED INSIDE AND OUTSIDE. PROVIDE HORIZONTAL "DRAFT STOPS" AT EACH FLOOR LEVEL BY PACKING 6" (R-19) INSULATION BETWEEN 2X4 JOISTS.
17. ALL INTERIOR WALLS SHALL BE COVERED WITH 1/2" GYPSUM BOARD, WITH METAL CORNER REINFORCING, TAPE, FLOAT AND SAND K3 COATS! USE 5/8" GYPSUM BOARD ON CEILING WHEN SUPPORTING MEMBERS ARE 24" O.C. OR GREATER. USE 1/2" GYPSUM BOARD ON CEILING MEMBERS LESS THAN 24" O.C.
18. ALL BATH AND TOILET AREA WALLS AND CEILINGS SHALL HAVE WATER RESISTANT GYPSUM BOARD.

IF THIS STAMP IS NOT RED IT IS AN ILLEGAL SET OF PLANS
Nelson Design Group

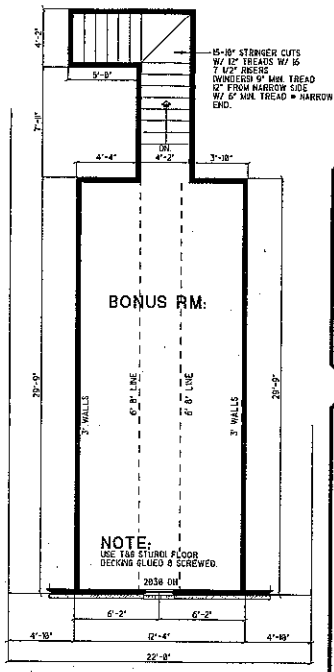

FLOOR PLAN SPECIFICATIONS

HEAT/COOLED:	2497 SQ. FT.
GARAGE:	737 SQ. FT.
PORCH:	393 SQ. FT.
BONUS RM:	356 SQ. FT.
TOTAL:	3985 SQ. FT.

NOTE:

1.- ALL CEILINGS TO BE 9' UNLESS NOTED.
2.- BUILDER TO APPROVE & VERIFY ALL PLANS BEFORE CONSTRUCTION.
3.- VERIFY ALL PLANS W/ LOCAL BUILDING CODES.
4.- HVAC & W.H. TO BE IN ATTIC UNLESS OTHERWISE NOTED.
5.- PROVIDE SHUT-OFF VALVE FOR ALL GAS APPLIANCES. REFERENCE IRC SECTION 624(6
6.- ALL GLASS LOCATED WITHIN 18" OF FLOOR, 12" OF A DOOR OR LOCATED WITHIN 60" OF FLOOR AT BATHTUBS, WHIRLPOOLS, SHOWERS, SAUNAS, STEAM ROOMS OR HOT TUBS SHALL BE TEMPERED TO COMPLY WITH IRC SECTION R308.4.6

© 2001 NELSON DESIGN GROUP, LLC.
Reproduction of these plans, in any form, without the written consent of the Designer, is prohibited.

REVISIONS	BY
08/26/04	GHT
3-24-05	GH/RP SH
12-07-05	GH
	24x36

Nelson Design Group LLC
NATIONALLY PUBLISHED
MICHAEL E. NELSON
P.B.D. Cert. No. AR-104

NOTICE DUTY OF COOPERATION

NELSON DESIGN GROUP, LLC, or Michael E. Nelson assumes no liability for any HOME constructed from this plan. Release of these plans contemplates further cooperation among the owner, the contractor and the designer. Design and construction are complex. Although the designer and his consultants performed their services with due care and diligence, they cannot guarantee perfection. Construction is imperfect and every contingency cannot be anticipated. Any ambiguity or discrepancy discovered by the use of these plans shall be reported immediately to the designer. Failure to notify the designer constitutes misunderstanding and increases construction costs. A failure to cooperate by a simple notice to the designer shall relieve the designer from responsibility for all consequences. Changes made from the plans without the consent of the designer are unauthorized and shall relieve the designer of responsibility for all consequences arriving out of such changes. Only qualified Designer, Architect, Contractor, or Structural Engineer should attempt to modify any portion of this design. Written dimensions on these drawings shall have precedence over scaled dimensions, contractors shall verify and be responsible for all dimensions and conditions on the job. This office must be notified of any variations from the dimensions and conditions shown by these drawings. Shop details must be submitted to this office for approval before proceeding with fabrication

FLOOR PLAN / NOTES

NDG563-1R

" Where Traditional Values and Family Come Together "

CAD DESIGNED

DATE	1/1/01
SCALE	1/4" = 1'-0"
BUILDER	
JOB	NDG563-1R
DRAWN BY	

1 OF 7