IREDELL COUNTY HEALTH DEPARTMENT - *ENVIRONMENTAL HEALTH* ☐ STATESVILLE OFFICE 704-878-5305 ☐ MOORESVILLE OFFICE 704-664-5281

IMPROVEMENT PERMIT / AUTHORIZATION TO CONSTRUCT / OPERATION PERMIT / EXISTING SYSTEM INSPECTION

PERMIT # EXPANSION 17530 PIN # 4629 84 4046 DATE MARCH 5, 2012

OWNER JIM & BECKY KARR APPLICANT: SAME PHONE: Home/Cell # 704-202-3791 Business # 336-817-8903

SITE ADDRESS 637 STILLWATER RD OWNER / APPLICANT ADDRESS 637 STILLWATER RD TROUTMAN, NC

SITE DIRECTIONS STATE PARK RD TO MORRISON FARM RD, TL WILLOW POINT RD, TL STILLWATER RD, #637 on R

SUBDIVISION CLT BLOCK / SECTION 17 LOT # 149 LOT AREA 0.77 ACRE DESIGN FLOW 360 L.T.A.R. 0.30 gpd/ft

Septic Tank EXIST. Gallons: STB ____ Date ____

Pump Tank ____ Gallons: P T ____ Date ____

Pump Make ____ Model ____ Serial # ____

No. Nitrification Fields: 1 No. Lines 1 Linear Feet 52'

Trench Width 36" Max. Trench Bottom Depth 36" Gravel Depth N/A

☐ New System ☐ Repair ☑ Expansion System Type I II III IV V VI

System Description: 25% REDUCTION SYSTEM

Repair System Description: 50% REDUCTION, PRETREAT.

Maintenance Agreement Required ☐ YES ☒ NO

☑ GRAVITY ☐ PRESSURE

☑ Residence No. Bedrooms 3

☐ Business No. Persons ____

☐ Other No. Employees ____


☐ Slab ☑ Crawl Space

☐ Basement w/plumbing ☐ Basement w/o plumbing

Water Supply: ☑ Private WELL ☐ Public ☐ Community

Comments / Conditions: ① REMOVE ALL DECK & DECK FOUNDATION WITHIN FIVE FEET of SEPTIC TANK & DRAINLINE ② INSTALL NEW 3' x 52' DRAINLINE USING 25% REDUCTION AS SPECIFIED IN ATTACHED FAST TRACK PLAN.

INITIAL SITE SKETCH

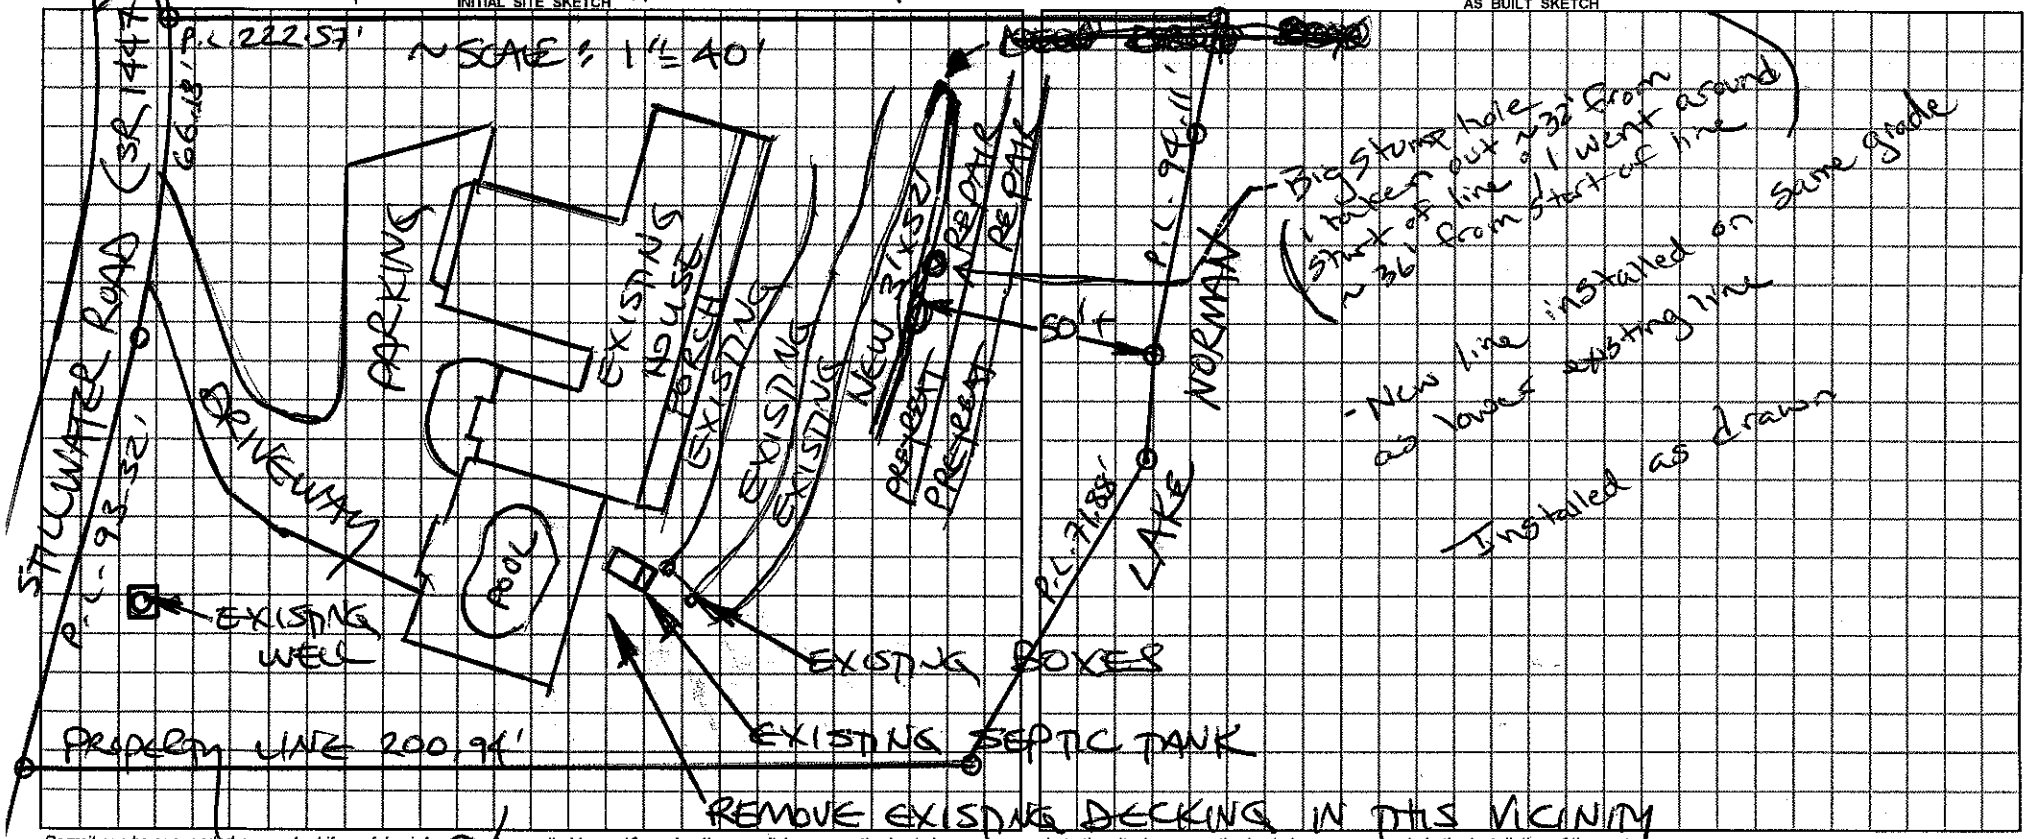

AS BUILT SKETCH

Permit can be suspended or revoked if any false information is supplied toward securing the permit / any unauthorized changes are made to the site / any unauthorized changes are made in the installation of the system.

☐ ***IMPROVEMENT PERMIT*** *with plat valid without expiration.* ☑ ***IMPROVEMENT PERMIT*** *with plat valid without expiration.* site plan valid 60 mo. ☑ ***AUTHORIZATION TO CONSTRUCT*** valid for period equal to IMPROVEMENT PERMIT--not to exceed 60 mo.

Owner / Applicant Signature: ____ Date 3-10-2012 Installed by: Rowan Septic

IMPROVEMENT PERMIT by: R. STEVE HEDRICK REHS Date 3-5-12 OPERATION PERMIT by: Justin Mendenhall REHS Date 4-2-14

AUTHORIZATION TO CONSTRUCT by: R. STEVE HEDRICK REHS Date 3-5-12 Existing System Inspected by: ____ REHS Date ____

YOU SHOULD CONTACT A LOCATOR SERVICE PRIOR TO ANY EXCAVATION

White Copy – Environmental Health YELLOW COPY (Final) Owner / Applicant PINK COPY (Initial) Owner / Applicant