IREDELL COUNTY HEALTH DEPARTMENT

STATESVILLE 704-878-5305 MOORESVILLE 704-664-5281

IMPROVEMENT PERMIT / CERTIFICATE OF COMPLETION / OPERATION PERMIT / EXISTING SYSTEM INSPECTION

PROPERTY DESCRIPTION NO. 21002 DATE 7/31/95 TAX MAP NO. 3C-2-A-49 Watershed: ☐ Yes ☒ No

OWNER OR CONTRACTOR Patsy J. Tsiliaris PHONE: Business _____ Home 528-9937

ADDRESS 233 Stillwater Road, Troutman NC

LOCATION State Park Road, Lt on Morrison Farm Lt on Willow Point, Lt on Stillwater, Lot on Rt


SUBDIVISION CLT BLOCK / SECTION 17 LOT 49 LOT AREA .79 SITE CLASS IPS DESIGN FLOW _____ L.T.A.R. _____

Septic Tank: _____ Gallons: STB _____ Date _____	☐ New System ☐ Repair System Type: I, II, III, IV, V, VI	☐ House/Mod. Home No. Bedrooms ____	Water Supply:
Pump Tank: _____ Gallons: PT _____ Date _____	System Description: Conventional Grav	☐ Mobile Home No. Bathrooms ____	☒ Individual
Pump Make: _____ Model _____ Serial No. _____	Repair System Description: Conventional (Pump)	☐ Business No. Employees ____	☐ Community
Nitrification Field: No Fields ____ Square Feet ____ Linear Feet ____	Maintenance Agreement Required: ☐ Yes ☐ No	☒ Other 2Br Cabin	☐ Public
No Lines ____ Trench Width ____ Max Trench Bottom Depth ____ Gravel Depth ____	☐ Slab ☒ Crawl Space ☐ Basement w/plumbing ☐ Basement wo/plumbing		


Comments: Small Cabin Replac 2Br MH
Maintain 5' from all parts of septic system

Comments: System Functioning Properly At Time of Inspection

INITIAL SITE SKETCH

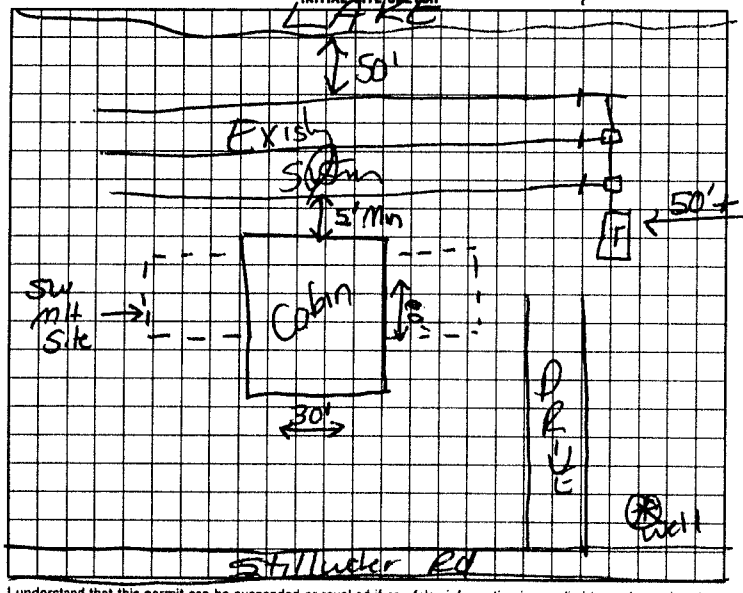

AS BUILT SKETCH

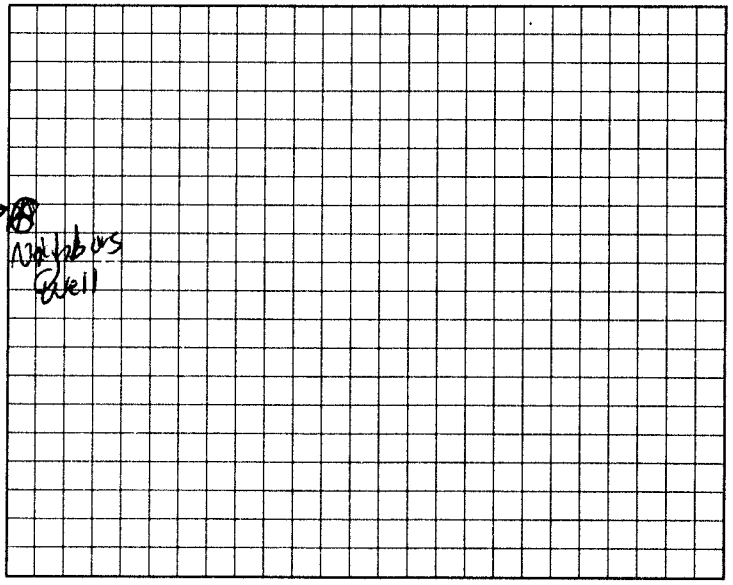

I understand that this permit can be suspended or revoked if any false information is supplied toward securing the permit/any unauthorized changes are made to the site/any unauthorized changes are made in the installation of the system. Improvement Permit is valid for 60 months from date of issuance.

Signed: _____

Improvement Permit by: _____ date _____

Existing System Inspection by: _____ date 7/31/95

Installed by: _____

Certificate of Completion by: _____ date _____

Operation Permit by: _____ date _____

HEALTH DEPT. COPY: WHITE INSPECTION COPY (FINAL): GREEN OWNER COPY (FINAL): YELLOW INSPECTION COPY (INITIAL): PINK OWNER COPY (INITIAL): GOLD