IREDELL COUNTY HEALTH DEPARTMENT

Statesville Phone TR 3-7271 Mooresville Phone NO 3-1271

PERMIT TO INSTALL SEPTIC TANK

Permit NO. 285 Bill — Permit Date April 29 1971

Owner Parlier Bros. Address: Statesville, N.C.

Installed By Lackey Bros. Address: Stony Point, N.C.

Location of Property Trautman, State Park Road —


Section 17 - Lot 59

| Tank | | Capacity | | Length of Lines | | Fixtures | |
|---|---|---|---|---|---|---|---|
| Block | ( ) | 1000 | (✓) | 225' | (✓) | No. of Baths | (1) |
| Precast | (✓) | 1250 | ( ) | 250' | ( ) | Dishwasher | ( ) |
| | | 1500 | ( ) | Other | | Garbage Grdr. | ( ) |
| | | Other | | | | Other | |

NOTIFY HEALTH DEPARTMENT AT LEAST EIGHT HOURS BEFORE TANK IS TO BE INSPECTED.

Final Inspection April 29 1971 Approved (✓) Disapproved ( )

Remarks No well on Property

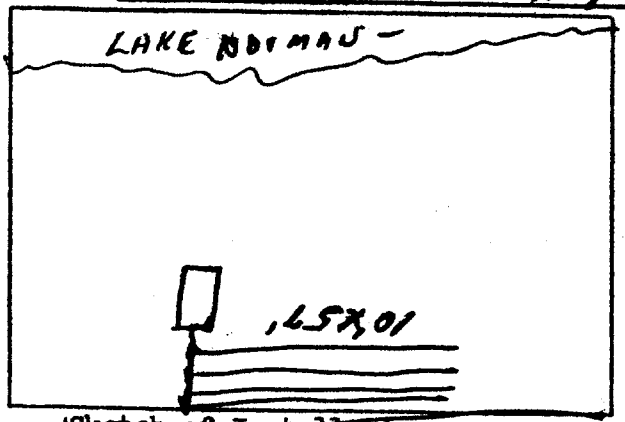


Sketch of Installation

Road

Sanitarian