IREDELL COUNTY HEALTH DEPARTMENT

Statesville Office (704) 878-5305 Mooresville Office (704) 660-3625 PERMIT # 20620

IMPROVEMENT PERMIT / AUTHORIZATION TO CONSTRUCT / OPERATION PERMIT / EXISTING SYSTEM

PIN # 4629849914

APPLICANT: Livewell Homes APPLICANT ADDRESS: 501 Springcrest Dr.

SITE ADDRESS: 518 Stillwater Dr. PHONE: 704-578-4951 ALT. PHONE: N/A

SITE DIRECTIONS: State Park Rd to Morrison Farm TL Dayvalt Cut TR Stillwater Rd.

SUBDIVISION: Falls Park SECTION: 2 LOT # 17 LOT AREA: 1.018 acres DESIGN FLOW: 480gpd L.T.A.R.: 0.3

Septic Tank 1000 (gal) STB 794-1000 Date 2-16-16
Pump Tank (gal) PT Date
Pump Make Model Serial #
Nitrification Fields 1 # Lines 4 Linear Ft: 400
Trench Width 36" Max. Trench Bottom Depth 36" Gravel Depth N/A

☑ New System ☐ Repair ☐ Expansion System Type: I II (III) IV V VI
System Description: 25% Reduction
Repair System Description: 25% Reduction
Maintenance Agreement Required: ☐ YES ☑ NO
☑ GRAVITY ☐ PRESSURE

☑ Residence No. Bedrooms 4
☐ Business No. Persons 8
☐ Other No. Employees
☐ Slab ☑ Crawl Space
☐ Basement w/plumbing ☐ Basement w/o plumbing

Water Supply: ☐ Private ☑ Public ☐ Community

Comments / Conditions:

INITIAL SITE SKETCH

See attached Plan by:
Kathleen Saunders, LSS

AS BUILT SKETCH

- Red Polylok filter installed
- Quick 4 Chambers installed
- Installed as drawn

Permit can be suspended or revoked if any false information is supplied toward securing the permit / any unauthorized changes are made to the site / any unauthorized changes are made in the installation of the system. **CONTACT A LOCATOR SERVICE PRIOR TO ANY EXCAVATION**

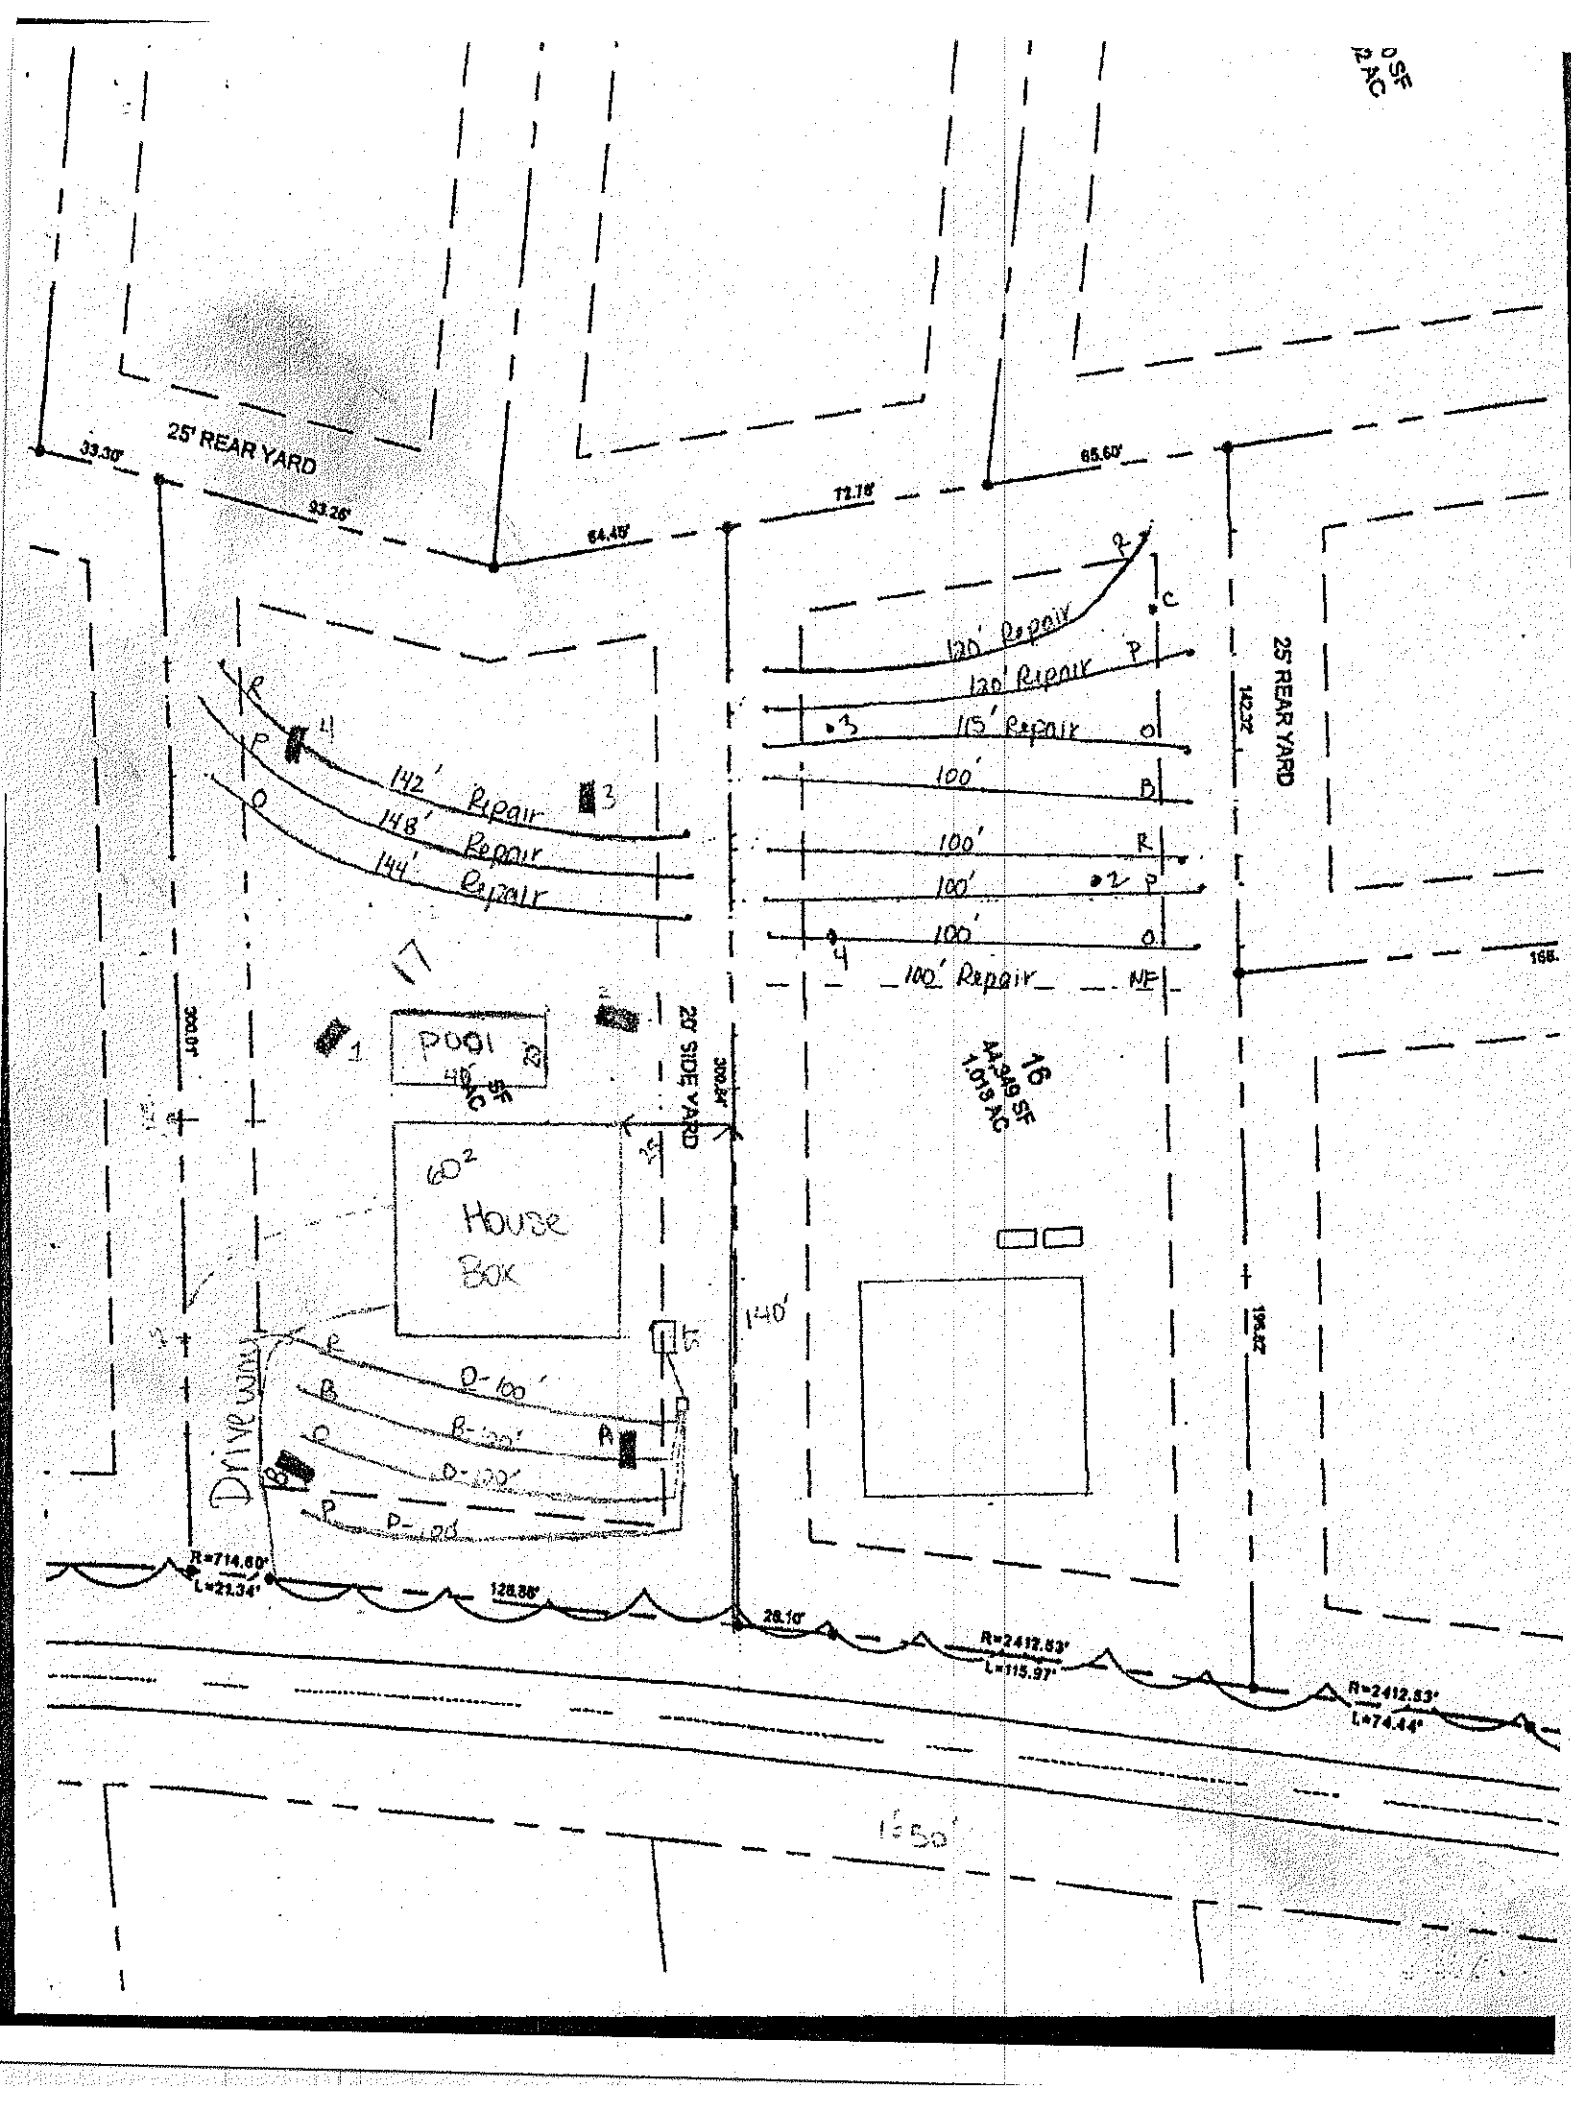
☐ **IMPROVEMENT PERMIT** *with plat valid without expiration.* ☑ **IMPROVEMENT PERMIT** *with site plan valid for 60 mos.* ☑ **AUTHORIZATION TO CONSTRUCT** *valid for period equal to IMPROVEMENT PERMIT--not to exceed 60 mo.*

Owner / Applicant Signature: Date: 8-28-15 Installed by: Wesson Septic

IMPROVEMENT PERMIT by: Justin Henderson Date: 8-28-15 OPERATION PERMIT by: Justin Henderson Date: 3-18-16

AUTHORIZATION TO CONSTRUCT by: Justin Henderson Date: 8-28-15 Existing System Inspected by: Date:

Health Dept. Copy - WHITE Applicant (Final Approval) - YELLOW Applicant (Conditional Approval) - PINK


25' REAR YARD
33.30'
33.26'
64.48'
72.78'
65.60'
120' Repair
120' Repair
115' Repair
100'
100'
100'
100' Repair
142' Repair
148' Repair
144' Repair
25' REAR YARD
142.32'
168.
POOL
20' SIDE YARD
300.00'
300.00'
16
44,849 SF
1.03 AC
60²
House
Box
140'
194.82'
Driveway
D-100'
D-120'
D-120'
D-120'
R=714.60'
L=21.34'
128.38'
28.10'
R=2412.83'
L=115.97'
R=2412.83'
L=74.44'
150'