IREDELL COUNTY HEALTH DEPARTMENT

Statesville Office (704) 878-5305 Mooresville Office (704) 660-3625 PERMIT # 213775 ~~20463~~ 4 BF

IMPROVEMENT PERMIT / AUTHORIZATION TO CONSTRUCT / OPERATION PERMIT / EXISTING SYSTEM

PIN # 4629853384

APPLICANT: Livewell Homes APPLICANT ADDRESS: 501 Springcrest Dr

SITE ADDRESS: 552 Stillwater Rd Troutman NC PHONE: 704-578-4957 ALT. PHONE: N/A

SITE DIRECTIONS: State Park Rd T/L Morrison Farm Rd T/L Dayvault Cut T/R Stillwater lot on right

SUBDIVISION: Falls Park SECTION: 2 LOT # 22 LOT AREA: 1.625ac DESIGN FLOW: 480 L.T.A.R.: 0.25

Septic Tank 1000 (gal) STB 794-1000 Date 2-16-16
Pump Tank (gal) PT Date
Pump Make Model Serial #
Nitrification Fields 1 # Lines 6 Linear Ft: 480
Trench Width 36" Max. Trench Bottom Depth 24" Gravel Depth N/A

[X] New System [ ] Repair [ ] Expansion System Type: I II [III] IV V VI
System Description: 25% Reduction
Repair System Description: 25% Reduction Pump
Maintenance Agreement Required: [ ] YES [X] NO
[X] GRAVITY [ ] PRESSURE

[X] Residence No. Bedrooms 4
[ ] Business No. Persons 8
[ ] Other No. Employees
[ ] Slab [X] Crawl Space
[ ] Basement w/plumbing [ ] Basement w/o plumbing

Water Supply: [ ] Private [X] Public [ ] Community

Comments / Conditions: Install per plan by Oaks Group PA

INITIAL SITE SKETCH

See plan by Oaks Group PA

AS BUILT SKETCH

- Quick 4 Chambers installed
- Red Poly lok filter installed
- Installed as drawn

Permit can be suspended or revoked if any false information is supplied toward securing the permit / any unauthorized changes are made to the site / any unauthorized changes are made in the installation of the system. **CONTACT A LOCATOR SERVICE PRIOR TO ANY EXCAVATION**

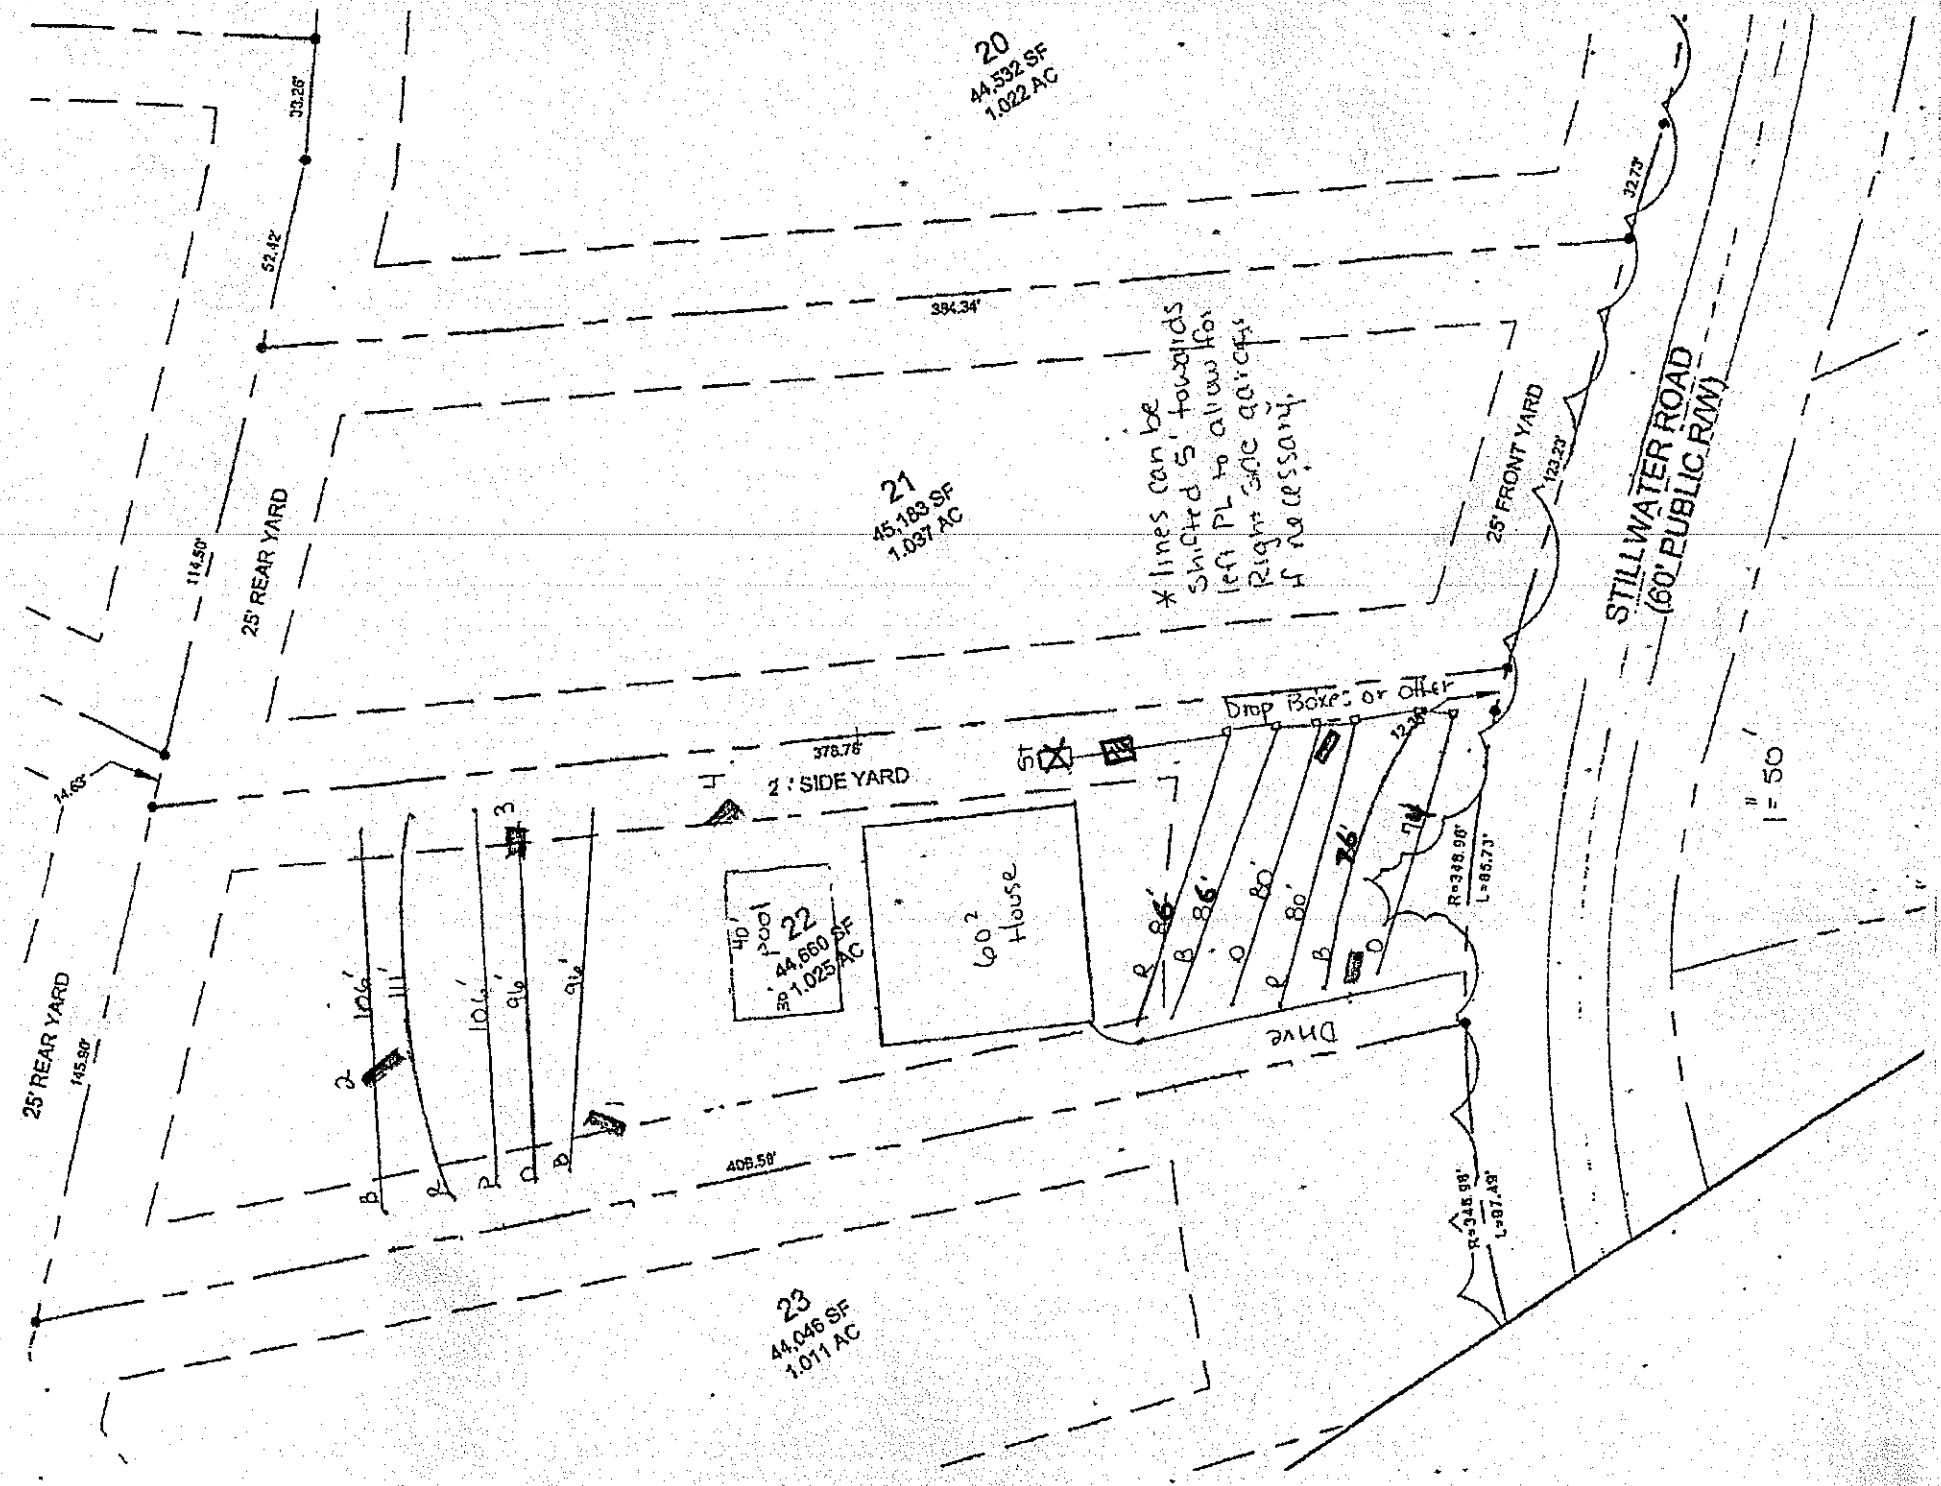
[ ] **IMPROVEMENT PERMIT** *with plat valid without expiration.* [Y] **IMPROVEMENT PERMIT** *with site plan valid for 60 mos.* [X] **AUTHORIZATION TO CONSTRUCT** *valid for period equal to IMPROVEMENT PERMIT--not to exceed 60 mo.*

Owner / Applicant Signature: Date: 9-17-15 Installed by: Chris Dobbins

IMPROVEMENT PERMIT by: Date: 09/17/15 OPERATION PERMIT by: Justin Henderson Date: 3/16/16

AUTHORIZATION TO CONSTRUCT by: Date: 09/17/15 Existing System Inspected by: Date:

Health Dept. Copy - WHITE Applicant (Final Approval) - YELLOW Applicant (Conditional Approval) - PINK


20
44,532 SF
1.022 AC
21
45,183 SF
1.037 AC
22
44,660 SF
1.025 AC
23
44,046 SF
1.011 AC
33.25'
52.42'
384.34'
114.50'
25' REAR YARD
25' FRONT YARD
123.29'
32.75'
STILLWATER ROAD
(60' PUBLIC R/W)
* lines can be shifted 5' towards left PL to allow for Right side access, if necessary.
Drop Boxes or Other
12.28'
378.76'
14.65'
4
2' SIDE YARD
3
2
60² House
40' Pool
39'
R=348.99'
L=85.73'
R=348.99'
L=87.49'
408.58'
145.80'
Drive
1" = 50'