IREDELL COUNTY HEALTH DEPARTMENT

Statesville Office (704) 878-5305 Mooresville Office (704) 660-3625 PERMIT # DF 204623

IMPROVEMENT PERMIT / AUTHORIZATION TO CONSTRUCT / OPERATION PERMIT / EXISTING SYSTEM

PIN # 4629854275

APPLICANT: Livewell Homes APPLICANT ADDRESS: 501 Springcrest Dr

SITE ADDRESS: 548 Stillwater Rd PHONE: 704-578-4951 ALT. PHONE: N/A

SITE DIRECTIONS: Perth Rd to State Park T/L Morrison Farm Rd T/L Stillwater Lot on right

SUBDIVISION: Falls Park SECTION: 2 LOT # 21 LOT AREA: 1.03ac DESIGN FLOW: 480 L.T.A.R.: 0.3

Septic Tank 1000 (gal) STB 794-1000 Date 4-25

Pump Tank (gal) PT Date

Pump Make Model Serial #

Nitrification Fields 1 # Lines 6 Linear Ft: 400

Trench Width 36" Max. Trench Bottom Depth 36" Gravel Depth N/A

[X] New System [ ] Repair [ ] Expansion System Type: I II [III] IV V VI

System Description: 25% Reduction

Repair System Description: 25% Reduction

Maintenance Agreement Required: [ ] YES [X] NO

[X] GRAVITY [ ] PRESSURE

[X] Residence No. Bedrooms 4

[ ] Business No. Persons 8

[ ] Other No. Employees

[ ] Slab [X] Crawl Space

[ ] Basement w/plumbing [ ] Basement w/o plumbing

Water Supply: [ ] Private [X] Public [ ] Community

Comments / Conditions: Install per plan by Kathleen Saunders

INITIAL SITE SKETCH

See plan by Kathleen Saunders

AS BUILT SKETCH

- Red Polylok filter installed
- Quick 4 Chambers installed
- Installed as drawn

Permit can be suspended or revoked if any false information is supplied toward securing the permit / any unauthorized changes are made to the site / any unauthorized changes are made in the installation of the system. **CONTACT A LOCATOR SERVICE PRIOR TO ANY EXCAVATION**

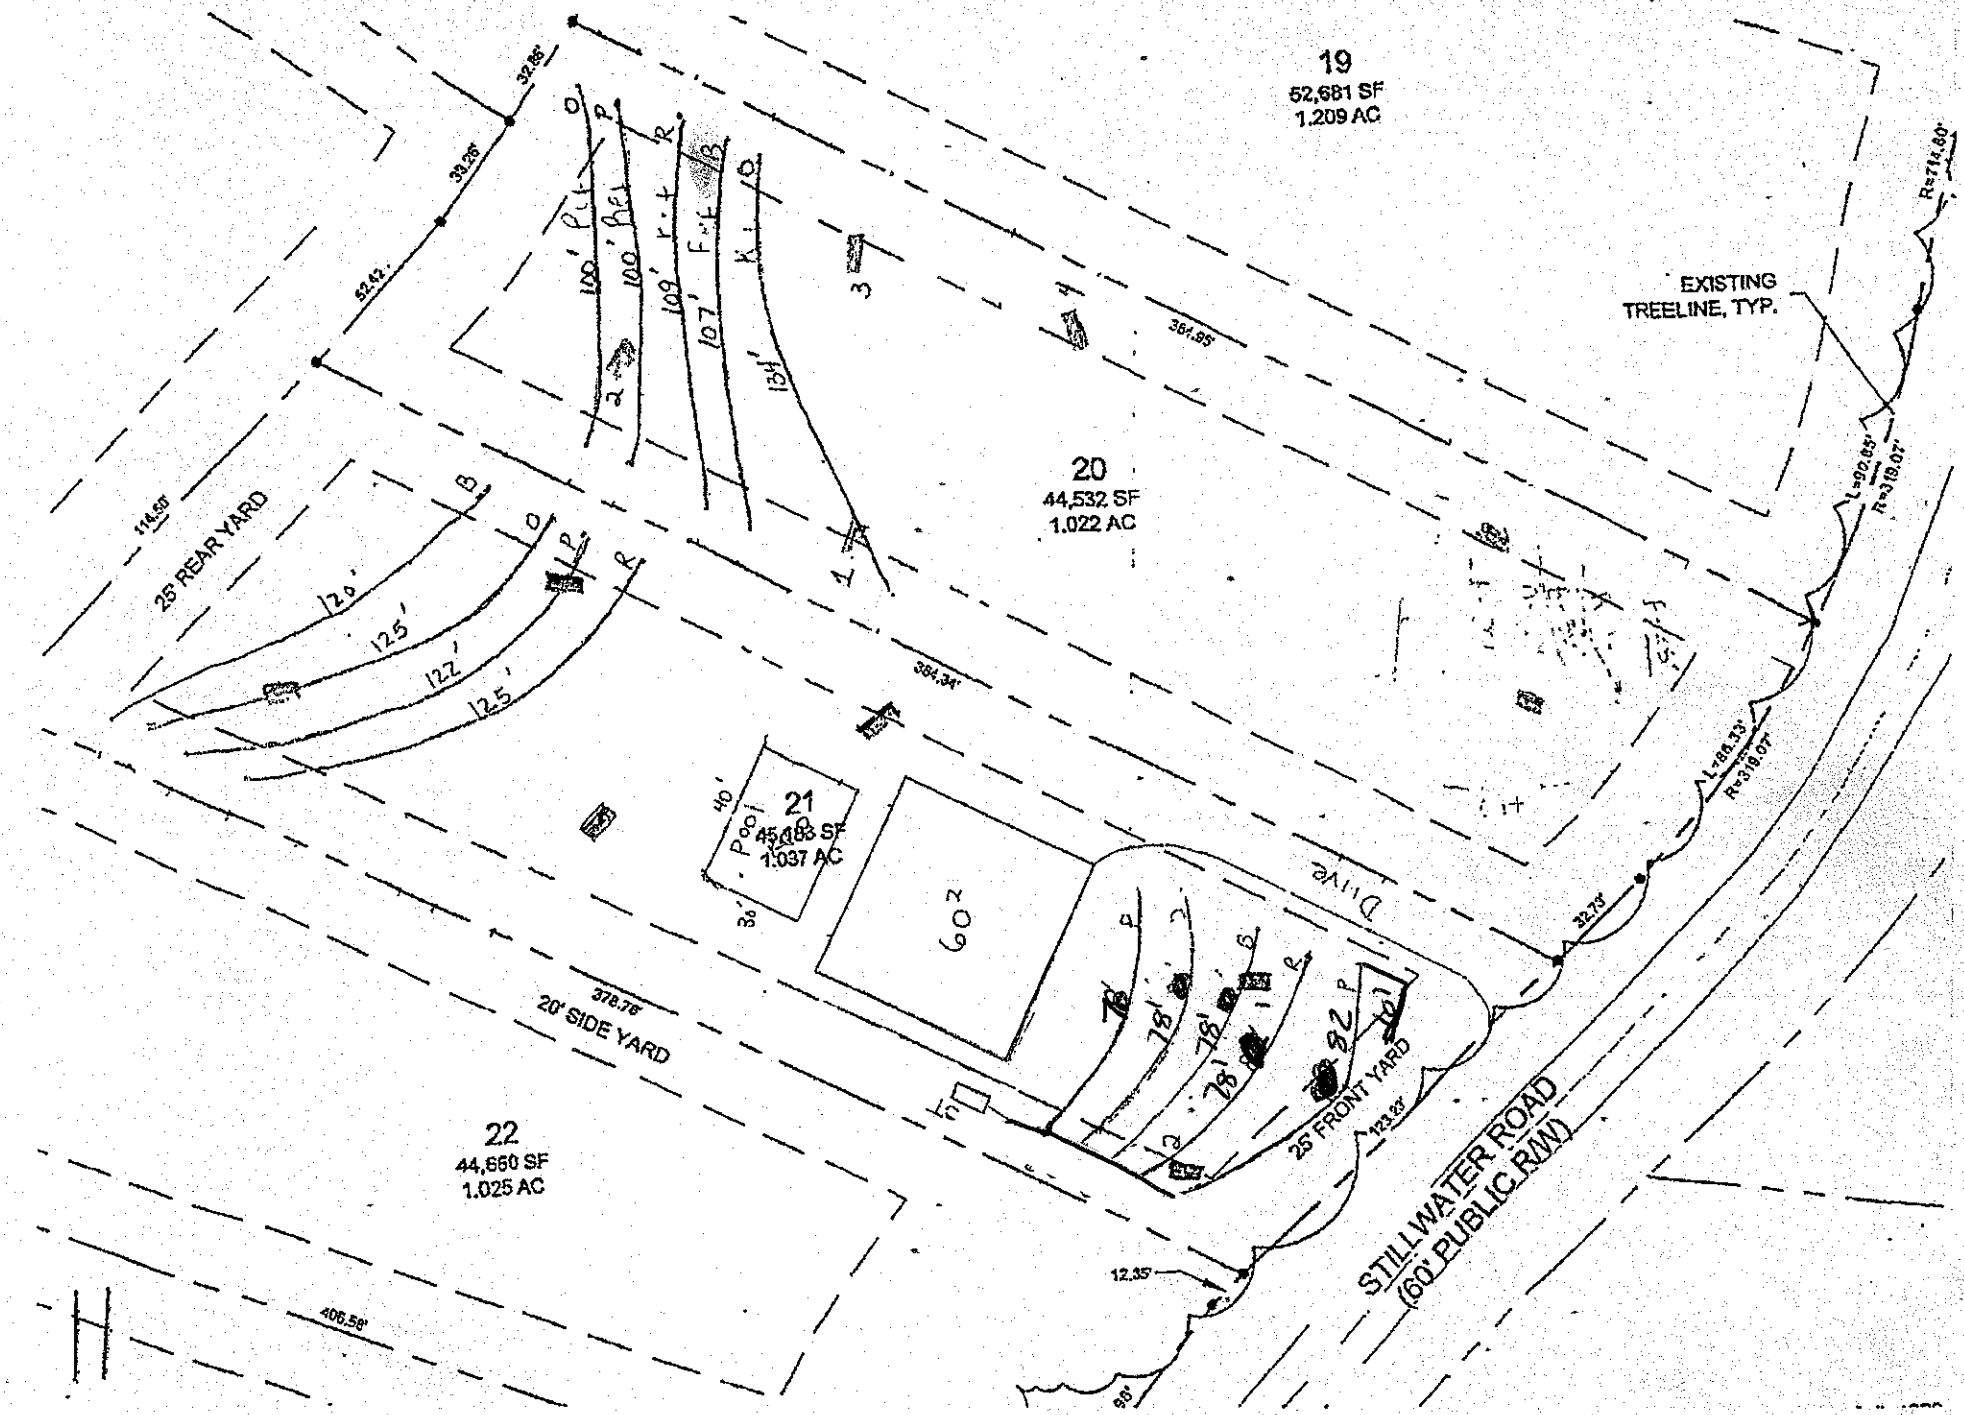
[ ] **IMPROVEMENT PERMIT** *with plat valid without expiration.* [X] **IMPROVEMENT PERMIT** *with site plan valid for 60 mos.* [X] **AUTHORIZATION TO CONSTRUCT** *valid for period equal to IMPROVEMENT PERMIT--not to exceed 60 mo.*

Owner / Applicant Signature: Date: 9-15-15 Installed by: Chris Dobbins

IMPROVEMENT PERMIT by: Date: 09/15/15 OPERATION PERMIT by: Date: 5-27-16

AUTHORIZATION TO CONSTRUCT by: Date: 09/15/15 Existing System Inspected by: Date:

Health Dept. Copy - WHITE Applicant (Final Approval) - YELLOW Applicant (Conditional Approval) - PINK


19
52,681 SF
1.209 AC
20
44,532 SF
1.022 AC
21
45,083 SF
1.037 AC
22
44,660 SF
1.025 AC
EXISTING
TREELINE, TYP.
25' REAR YARD
20' SIDE YARD
25' FRONT YARD
STILLWATER ROAD
(60' PUBLIC R/W)
Pool
Drive
60'
384.34'
364.95'
378.76'
406.58'
114.50'
32.73'
123.33'
12.35'
R=714.60'
L=90.83'
R=319.07'
L=66.33'
R=319.07'