IREDELL COUNTY HEALTH DEPARTMENT

Statesville Office (704) 878-5305 Mooresville Office (704) 660-3625 PERMIT # 212444

IMPROVEMENT PERMIT / AUTHORIZATION TO CONSTRUCT / OPERATION PERMIT / EXISTING SYSTEM

PIN # 4629855156

APPLICANT: Livewell Homes LLC APPLICANT ADDRESS: 542 Stillwater Rd.

SITE ADDRESS: 542 Stillwater Dr. PHONE: 704-578-4951 ALT. PHONE: N/A

SITE DIRECTIONS: State Park Rd Left on Morrison Farm Rd Left on Stillwater Rd.

SUBDIVISION: Falls Park SECTION: 2 LOT # 20 LOT AREA: 1.022 acres DESIGN FLOW: 480gpd L.T.A.R.: 0.3

Septic Tank 1000 (gal) STB 794 Date 7-24-15
Pump Tank 1000 (gal) PT 285-1000 Date 2-3-16
Pump Make Liberty Model 283 Serial #
Nitrification Fields 1 # Lines 3 Linear Ft: 401
Trench Width 36" Max. Trench Bottom Depth 36" Gravel Depth N/A

☑ New System ☐ Repair ☐ Expansion System Type: I II (III) IV V VI
System Description: 25% Reduction - Pump
Repair System Description: 25% Reduction
Maintenance Agreement Required: ☐ YES ☑ NO
☐ GRAVITY ☑ PRESSURE

☑ Residence ☐ Business ☐ Other ☐ Slab ☐ Basement w/plumbing
No. Bedrooms 4 No. Persons 8 No. Employees
☑ Crawl Space ☐ Basement w/o plumbing

Water Supply: ☐ Private ☑ Public ☐ Community

Comments / Conditions:

INITIAL SITE SKETCH

See attached design by

Kathleen Saunders, LSS

AS BUILT SKETCH

Red Poly/ck Sr7e, installed
- Pump Tank 29" Deep w/ risers
- septic Tank ~ 17" Deep w/ risers
- Qurck d chambers, installed

	Date	Initials
Drain Lines Checked	3-15-16	JH
Tanks Checked	3-15-16	JH
Pressure Manifold or Valve Box Checked	3-15-16	JH
Pressure Head Set	3-18-16	DR
Electrical Checked	3-29-16	JH
Floats Set	3-15-16	JH
Alarm Checked	3-18-16	JH
Maintenance Contract Y / N	N/A	

Permit can be suspended or revoked if any false information is supplied toward securing the permit / any unauthorized changes are made to the site / any unauthorized changes are made in the installation of the system. **CONTACT A LOCATOR SERVICE PRIOR TO ANY EXCAVATION**

☐ **IMPROVEMENT PERMIT** *with plat valid without expiration.* ☑ **IMPROVEMENT PERMIT** *with site plan valid for 60 mos.* ☑ **AUTHORIZATION TO CONSTRUCT** *valid for period equal to IMPROVEMENT PERMIT--not to exceed 60 mo.*

Owner / Applicant Signature: Date:

Installed by: Chris Dabbins

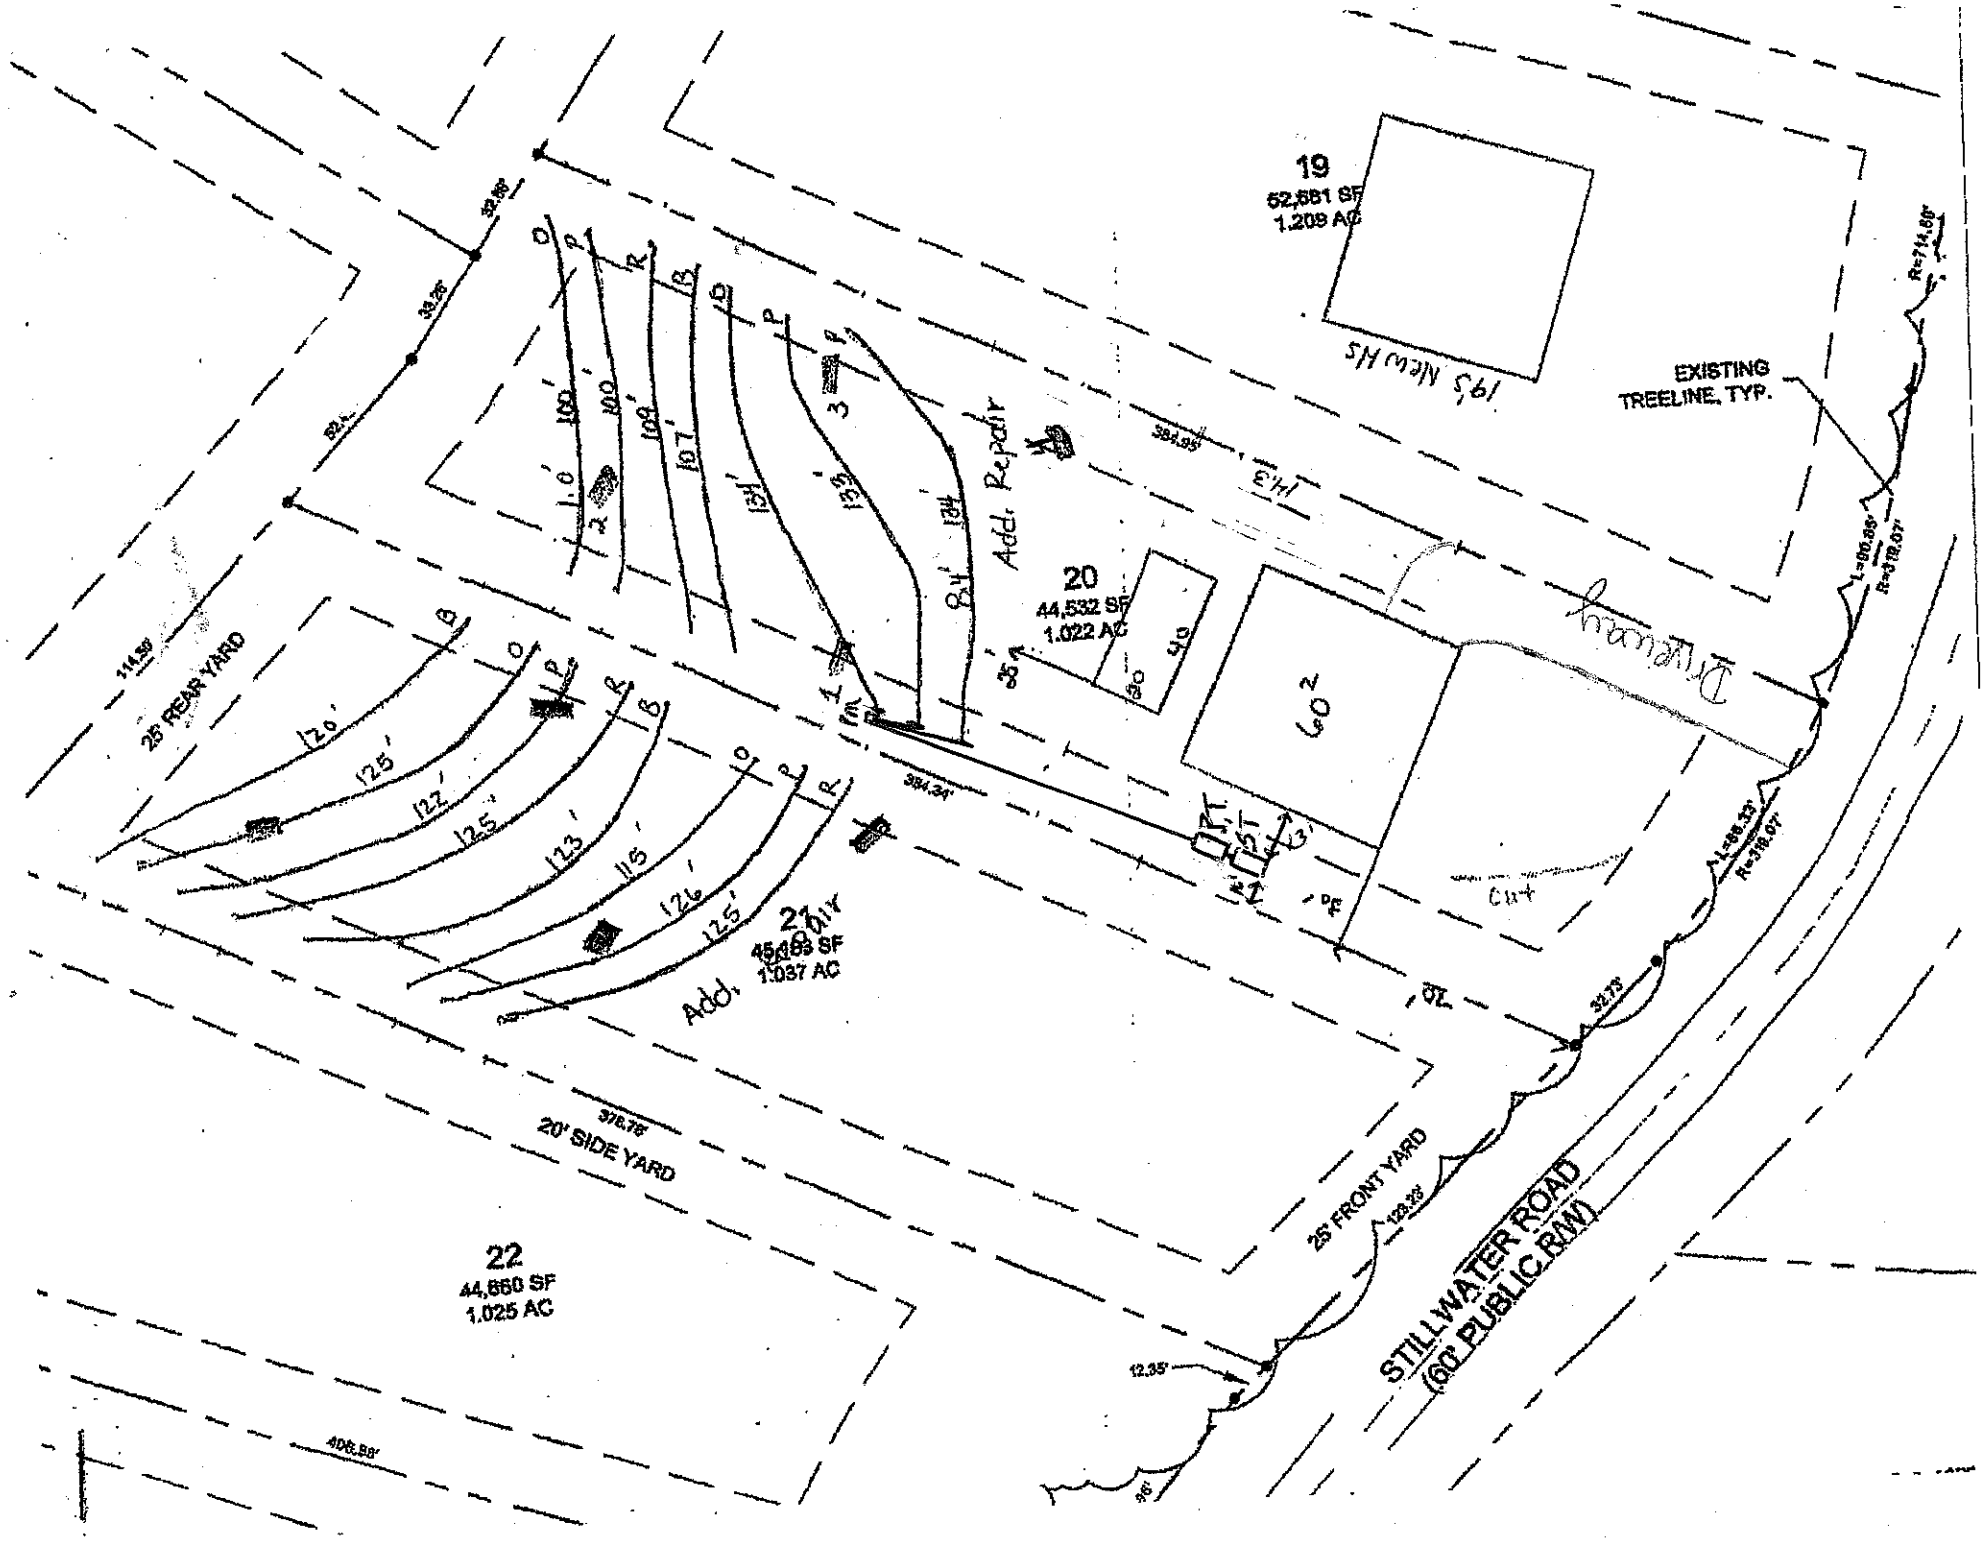
IMPROVEMENT PERMIT by: Justin Henderson Date: 8-13-15

OPERATION PERMIT by: Justin Henderson Date: 3-29-16

AUTHORIZATION TO CONSTRUCT by: Justin Henderson Date: 8-13-15

Existing System Inspected by: Date:

Health Dept. Copy - WHITE Applicant (Final Approval) - YELLOW Applicant (Conditional Approval) - PINK


19
52,881 SF
1.209 AC
EXISTING
TREELINE, TYP.
20
44,532 SF
1.022 AC
21
45,083 SF
1.037 AC
22
44,660 SF
1.025 AC
25' REAR YARD
20' SIDE YARD
25' FRONT YARD
STILLWATER ROAD
(@ PUBLIC R/W)
Add. Repair
Add.
