IREDELL COUNTY HEALTH DEPARTMENT

Statesville Office (704) 878-5305 Mooresville Offices (704) 660-3625 PERMIT # 217793

IMPROVEMENT PERMIT / AUTHORIZATION TO CONSTRUCT / OPERATION PERMIT / EXISTING SYSTEM

PIN # 4629-85-6487

APPLICANT: Livewell Homes APPLICANT ADDRESS: 501 Spring Crest Dr. Fort Mill, SC 29715

SITE ADDRESS: 424 Stillwater Rd. Troutman PHONE: ALT. PHONE: Kathleen Saunders 704-578-4951

SITE DIRECTIONS: Rt 150 West → R on Perth Rd → L on State Park Rd → L on Morrison Farm Rd → L on Dayvault Ct → R on Stillwater Rd → on Right

SUBDIVISION: Falls Park SECTION: 1B LOT # 7 LOT AREA: 1.025 acres DESIGN FLOW: 600 gpd L.T.A.R.: 0.35

Septic Tank 1500 (gal) STB 338 - Dellinger Date 9-8-16
Pump Tank — (gal) PT — Date —
Pump Make — Model — Serial # —
Nitrification Fields 1 # Lines 6 Linear Ft: 430
Trench Width 36" Max. Trench Bottom Depth 24" low side Gravel Depth —

☒ New System ☐ Repair ☐ Expansion System Type: I (II) III IV V VI
System Description: 25% Reduction
Repair System Description: 25% Reduction
Maintenance Agreement Required: ☐ YES ☒ NO
☒ GRAVITY ☐ PRESSURE

☒ Residence No. Bedrooms 5
☐ Business No. Persons 10
☐ Other No. Employees —
☐ Slab ☒ Crawl Space
☐ Basement w/plumbing ☐ Basement w/o plumbing

Water Supply: ☐ Private ☒ Public ☐ Community

Comments / Conditions: Follow all N.C. septic rules. Recommend pumping septic tank every 3-5 years. * Attached plans indicate a 4-Bedroom house to be built. Any deviation from these plans require a seperate health department approval *


INITIAL SITE SKETCH

See attached plans from The Oaks Group, PA

Dated 6-20-2016
Kathleen Saunders LSS # 1313

AS BUILT SKETCH

12/15/16 Dellinger Top-seam tank w/ a Polylok PL-68 Filter
L1 = 76' 3' 10.25" L5 = 60' 9' 6.25" 433 l.f. of Infiltrator Quick 4s
L2 = 76' — L6 = 56' 8' 4" installed @ 24"
L3 = 72' 5' 6" L7 = 27' —
L4 66' —

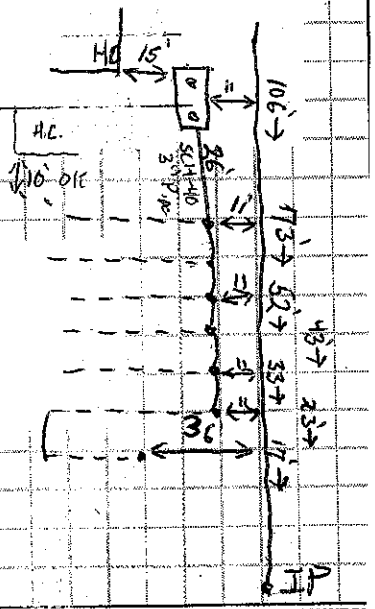

Permit can be suspended or revoked if any false information is supplied toward securing the permit / any unauthorized changes are made to the site / any unauthorized changes [illegible] system. CONTACT [illegible] FOR SERVICE PRIOR TO ANY EXCAVATION

☐ IMPROVEMENT PERMIT with plat valid without expiration. ☒ IMPROVEMENT PERMIT with site plan valid for 60 mos. ☒ AUTHORIZATION TO CONSTRUCT [illegible] to period equal to IMPROVEMENT PERMIT--not to exceed 60 mo

Owner / Applicant Signature: Date:

IMPROVEMENT PERMIT by: Tom Shuck Date: 6/28/16


AUTHORIZATION TO CONSTRUCT by: Tom Shuck Date: 6/28/16

Installed by: Wesson Septic Tank Co

OPERATION PERMIT by: Tom Shuck Date: 12/15/16

Existing System Inspected by: Date:

Health Dept. Copy - WHITE Applicant (Final Approval) - YELLOW Applicant (Conditional Approval) - PINK

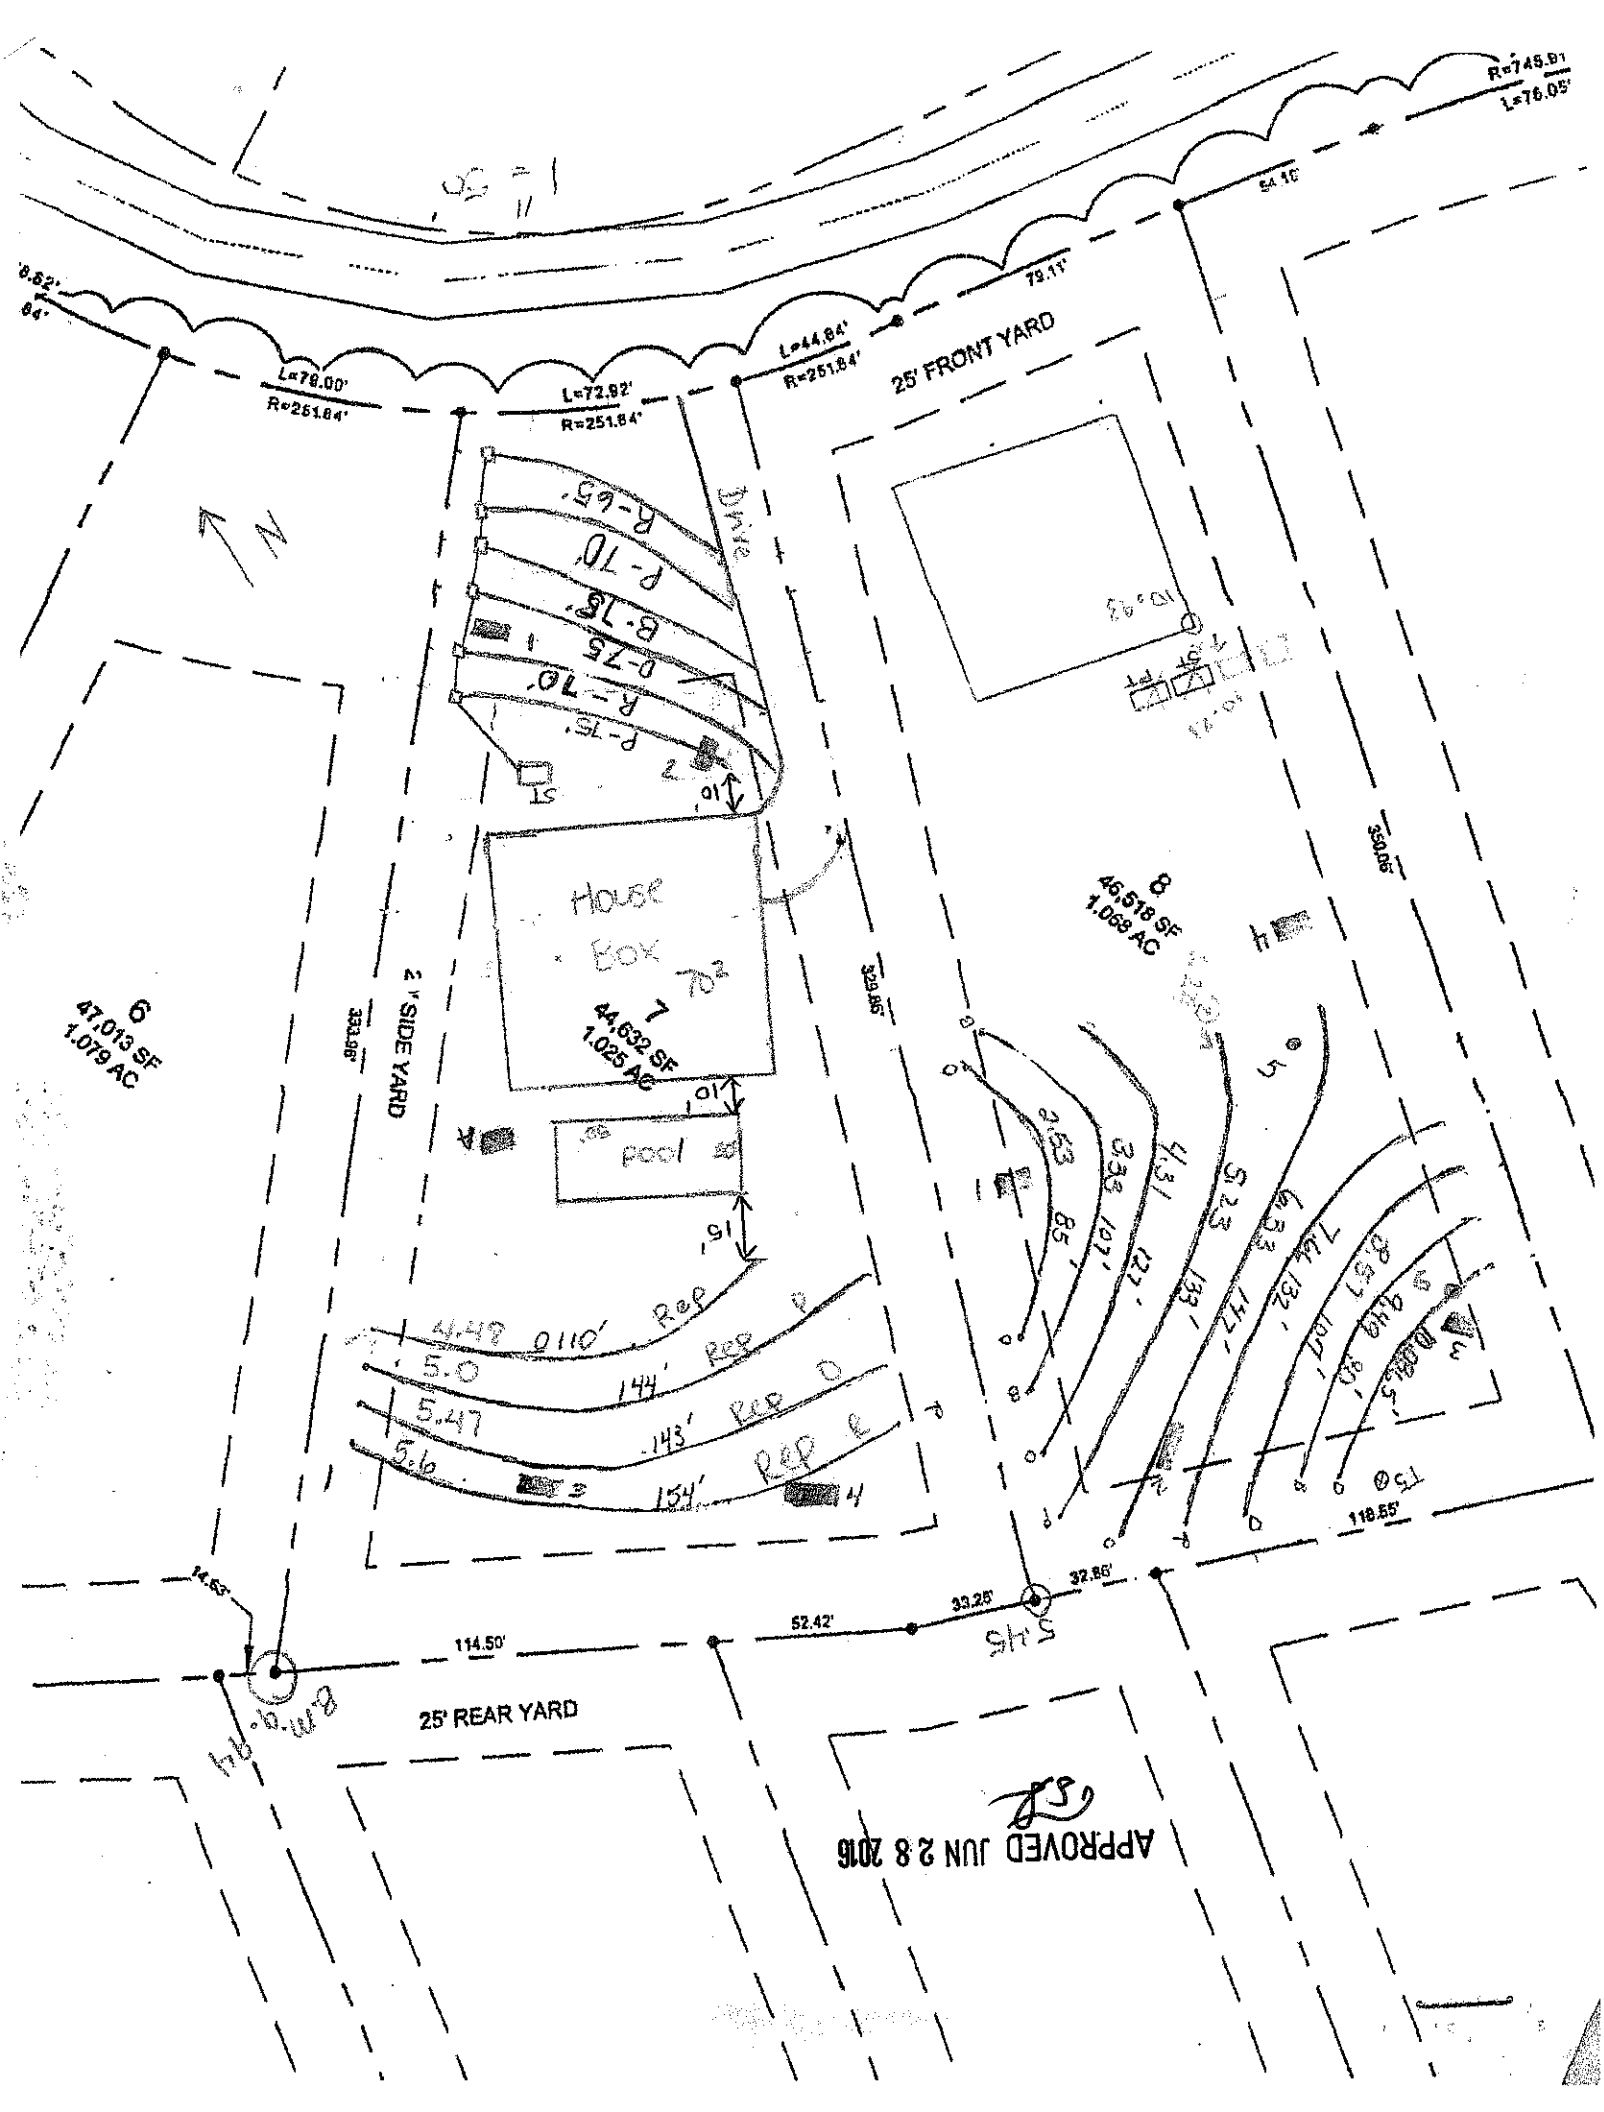
25' FRONT YARD
25' REAR YARD
2' SIDE YARD
L=79.00'
R=251.84'
L=72.92'
R=251.84'
L=44.84'
R=251.84'
R=749.91'
L=76.05'
79.11'
54.10'
R-65'
P-70'
B-75'
0-75'
R-70'
P-75'
House
Box
70²
Pool
6
47,013 SF
1.079 AC
7
44,632 SF
1.025 AC
8
46,518 SF
1.068 AC
329.46'
359.06'
333.96'
118.55'
114.50'
52.42'
33.25'
32.86'
14.63'
APPROVED JUN 28 2016