IREDELL COUNTY HEALTH DEPARTMENT

Statesville Office (704) 878-5305 Mooresville Office (704) 660-3625 PERMIT # 212451

IMPROVEMENT PERMIT / AUTHORIZATION TO CONSTRUCT / OPERATION PERMIT / EXISTING SYSTEM

PIN # 4629857083

APPLICANT: Livewell Homes APPLICANT ADDRESS: 501 Springcrest Dr Fort Mill SC 29715

SITE ADDRESS: 526 Stillwater Rd Troutman NC PHONE: 704-582-9219 ALT. PHONE: N/A

SITE DIRECTIONS: State Park Rd T/L Morrison Farm Rd T/L Dayvault cut T/R Stillwater Lot on right

SUBDIVISION: Falls Park SECTION: 2 LOT # 18 LOT AREA: 1.018 ac DESIGN FLOW: 480 L.T.A.R.: 0.3

Septic Tank 1000 (gal) STB Infiltrator Date Jm-1060
Pump Tank (gal) PT Date
Pump Make Model Serial #
Nitrification Fields 1 # Lines 7 Linear Ft: 400
Trench Width 36" Max. Trench Bottom Depth 31" Gravel Depth N/A

[X] New System [ ] Repair [ ] Expansion System Type: I II [III] IV V VI
System Description: 25% Reduction
Repair System Description: 50% Reduction
Maintenance Agreement Required: [ ] YES [X] NO
[X] GRAVITY [ ] PRESSURE

[X] Residence No. Bedrooms 4
[ ] Business No. Persons 8
[ ] Other No. Employees
[ ] Slab [X] Crawl Space
[ ] Basement w/plumbing [ ] Basement w/o plumbing

Water Supply: [ ] Private [X] Public [ ] Community

Comments / Conditions: Install per plan by Jacobs onsite development. Trench depth must be 31" on high side.

INITIAL SITE SKETCH

See plan by Jacobs On-site Development, Inc

AS BUILT SKETCH

- Red Poly-tex filter installed
- Quick 4 Chambers installed
- Installed as drawn

Permit can be suspended or revoked if any false information is supplied toward securing the permit / any unauthorized changes are made to the site / any unauthorized changes are made in the installation of the system. **CONTACT A LOCATOR SERVICE PRIOR TO ANY EXCAVATION**

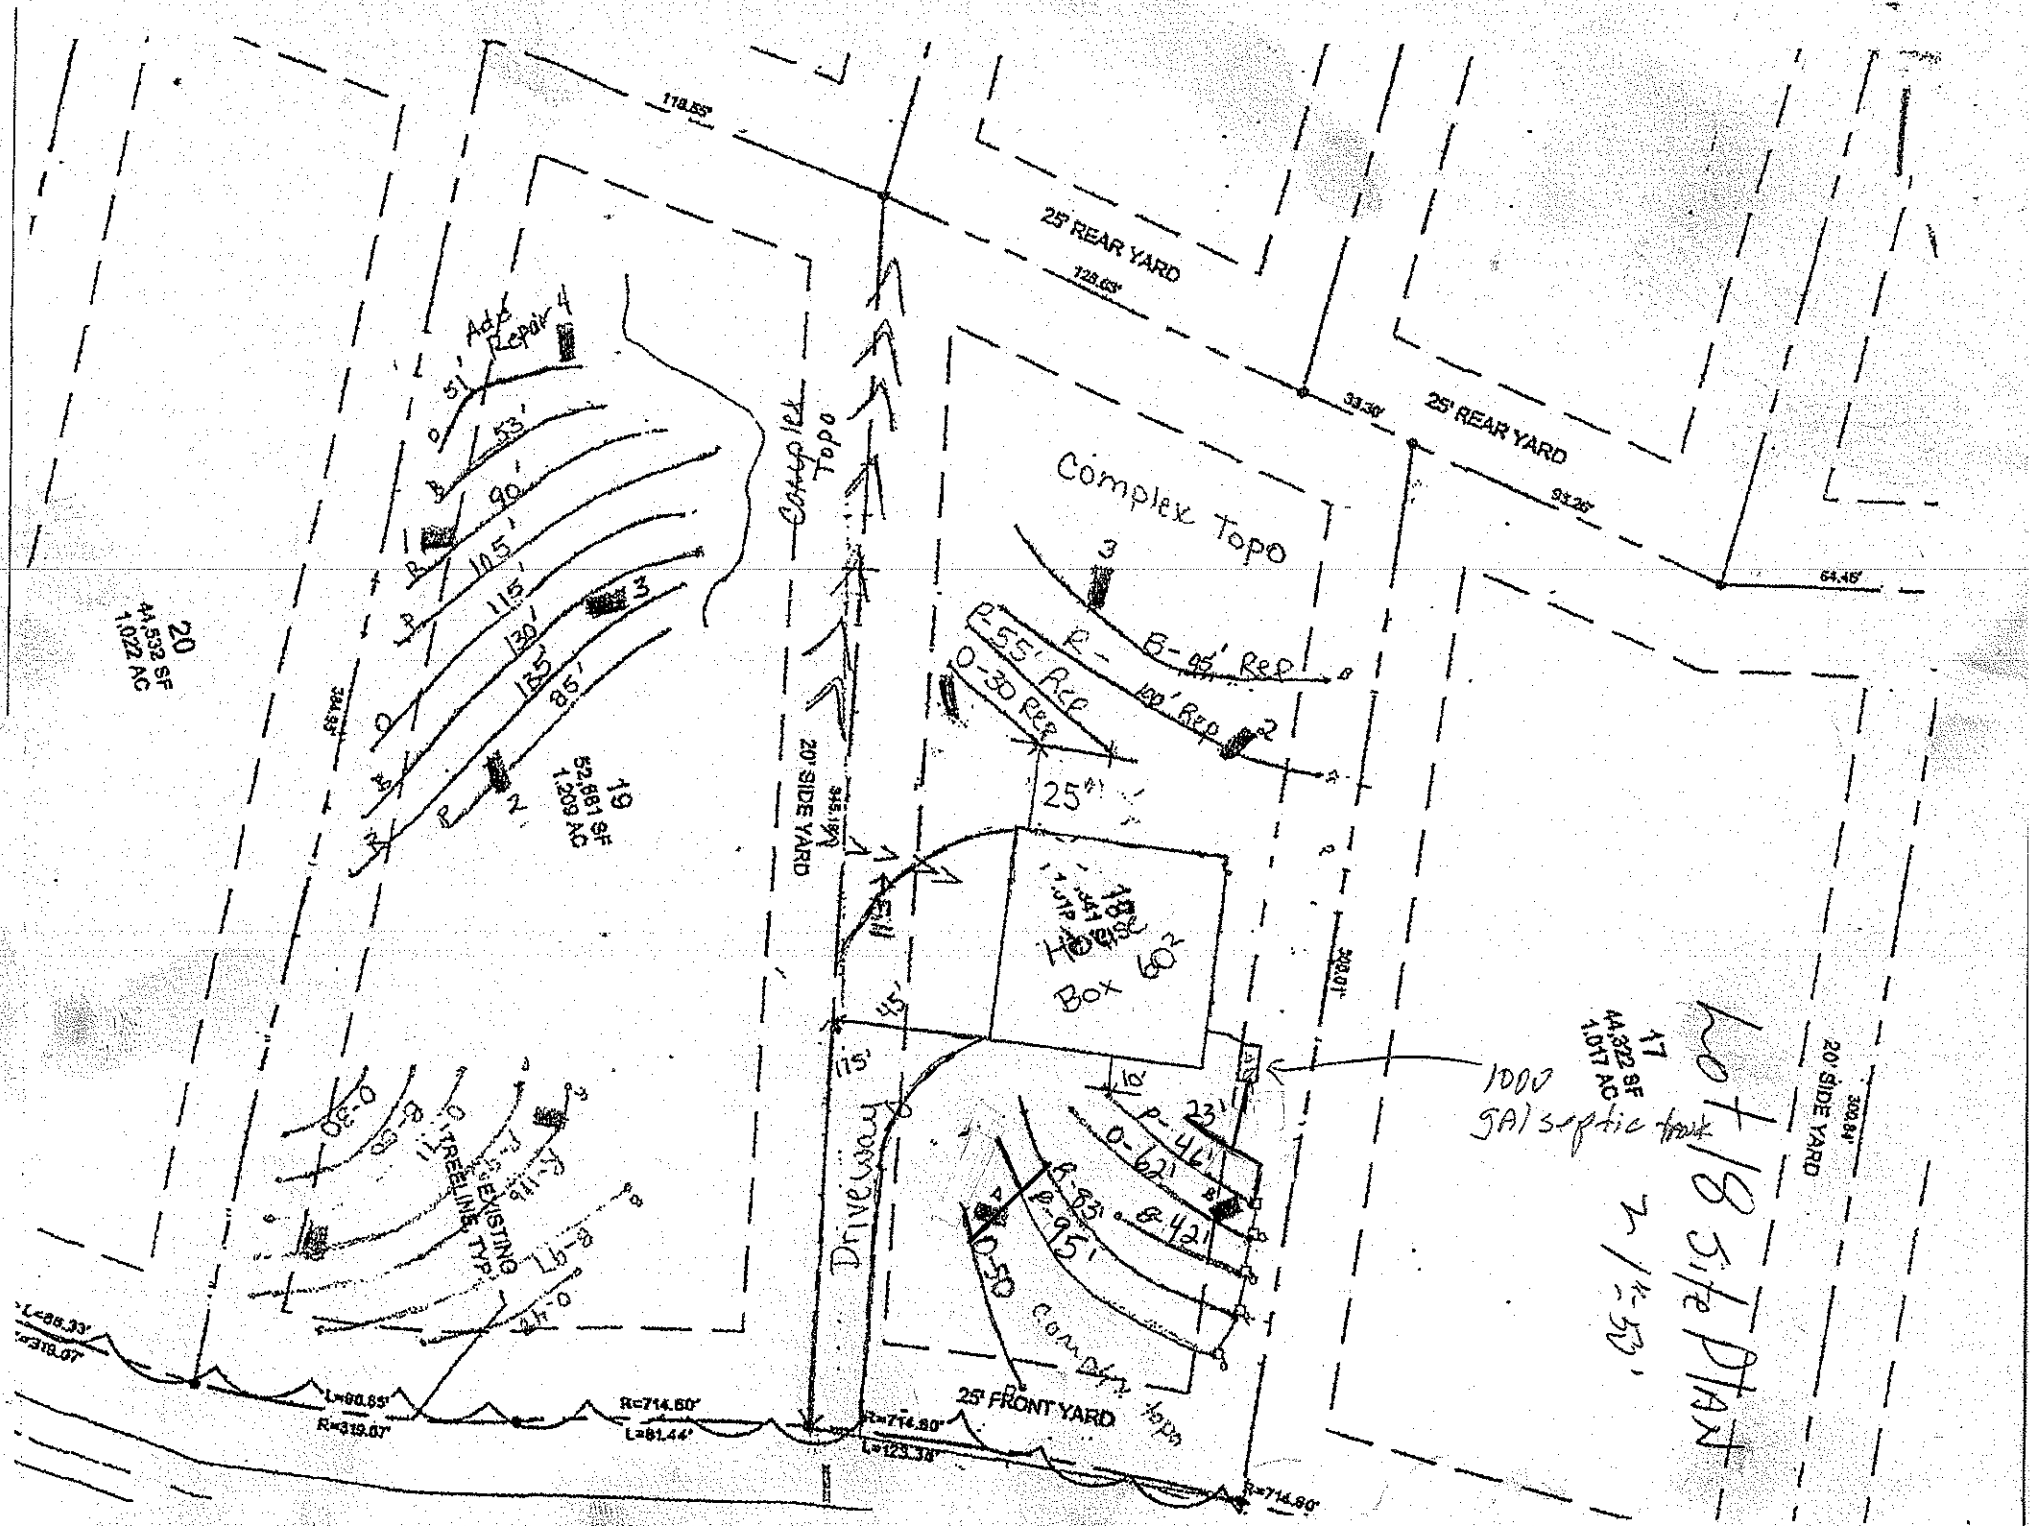
[ ] **IMPROVEMENT PERMIT** *with plat valid without expiration.* [X] **IMPROVEMENT PERMIT** *with site plan valid for 60 mos.* [X] **AUTHORIZATION TO CONSTRUCT** *valid for period equal to IMPROVEMENT PERMIT--not to exceed 60 mo.*

Owner / Applicant Signature: Date: 8-5-15 Installed by: Wesson Septic Tank Service

IMPROVEMENT PERMIT by: Date: 08/05/15 OPERATION PERMIT by: Date: 2-11-16

AUTHORIZATION TO CONSTRUCT by: Date: 08/05/15 Existing System Inspected by: Date:

Health Dept. Copy - WHITE Applicant (Final Approval) - YELLOW Applicant (Conditional Approval) - PINK


118.55'
25' REAR YARD
128.65'
33.30'
25' REAR YARD
93.26'
64.46'
Complex Topo
20' SIDE YARD
355.19'
20
44,532 SF
1.022 AC
19
52,681 SF
1.209 AC
Add Repair
3
2
1
4
5'
53'
90'
105'
115'
130'
135'
85'
R-55' Rep
R-100' Rep
0-30 Rep
25'
Fill
18
1 STP
Box
45'
15'
Driveway
EXISTING TREELINE TYP.
0-30
0-50
Lb-8
2h-0
L=88.33'
R=319.07'
L=88.55'
R=714.60'
L=81.44'
R=714.60'
L=123.38'
R=714.60'
25' FRONT YARD
Complex Topo
17
44,322 SF
1.017 AC
1000 GAL septic tank
20' SIDE YARD
398.84'
P-44'
0-62'
E-93'
P-95'
E-42'
0-50
Complex Topo
23'
1" = 50'