James Strantz

IREDELL COUNTY HEALTH DEPARTMENT

STATESVILLE 704-878-5305 MOORESVILLE 704-664-5281

IMPROVEMENT PERMIT / CERTIFICATE OF COMPLETION / OPERATION PERMIT / EXISTING SYSTEM INSPECTION

PROPERTY DESCRIPTION NO. 24846 DATE 9-27-96 TAX MAP NO. 3C-2-A-75C Pt Watershed: ☐ Yes ☐ No

OWNER OR CONTRACTOR Crescent Resources PHONE: Business 525-6024 Home 4629-85-9812

ADDRESS PO Box 1003 Charlotte N.C.

LOCATION Perth Rd TR State PK TL Morrison Fm TL Stillwater 1st on Rt after Aspen Ln

SUBDIVISION Lake Norman BLOCK / SECTION 17 LOT 880 LOT AREA 1.15 acres SITE CLASS PS DESIGN FLOW 360 L.T.A.R.

Septic Tank: 1000 Gallons; STB 1017 Date 10-8-96

Pump Tank: 1000 Gallons; PT 27 Date 12-23-96

Pump Make: Hydromatic Model SHEF 50A Serial No. 5187-008-9

Nitrification Field: No Fields 1 Square Feet 400 Linear Feet 200

No Lines 2 Trench Width 24" Max Trench Bottom Depth 36" Gravel Depth N/A

☑ New System ☐ Repair System Type: I, II, III, IV, V, VI

System Description: Pump to LPP Distribution Panels

Repair System Description: " "

Maintenance Agreement Required: ☑ Yes ☐ No

☑ House/Mod. Home No. Bedrooms 3

☐ Mobile Home No. Bathrooms 3

☐ Business No. Employees

☐ Other


☐ Slab ☐ Crawl Space ☑ Basement w/plumbing ☐ Basement wo/plumbing

Water Supply: ☑ Individual ☐ Community ☐ Public


Comments: A signed contract with a certified sub Surface operator must be on File with Iredell Co. Health Dept before operations Permit can be issued See attached sheets for Pressure Dist. Network + Pump Tank setup They are part of this Permit

Comments: Replaces Permit issued 9-10-96 Adding basement plumbing

INITIAL SITE SKETCH

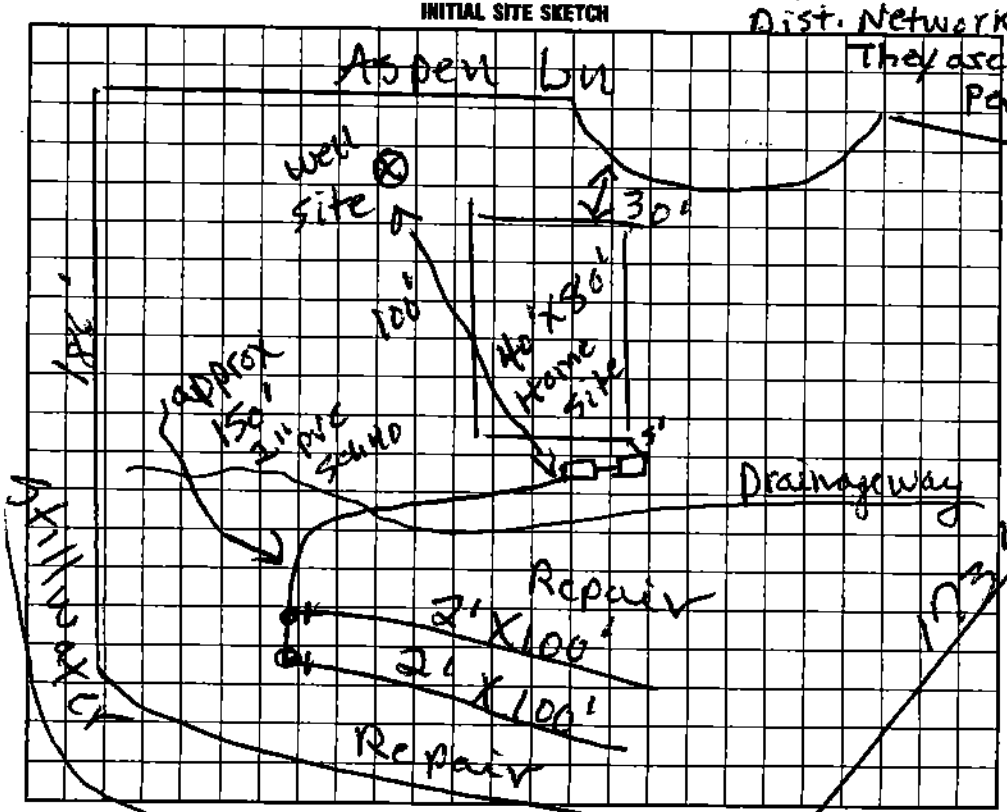

AS BUILT SKETCH

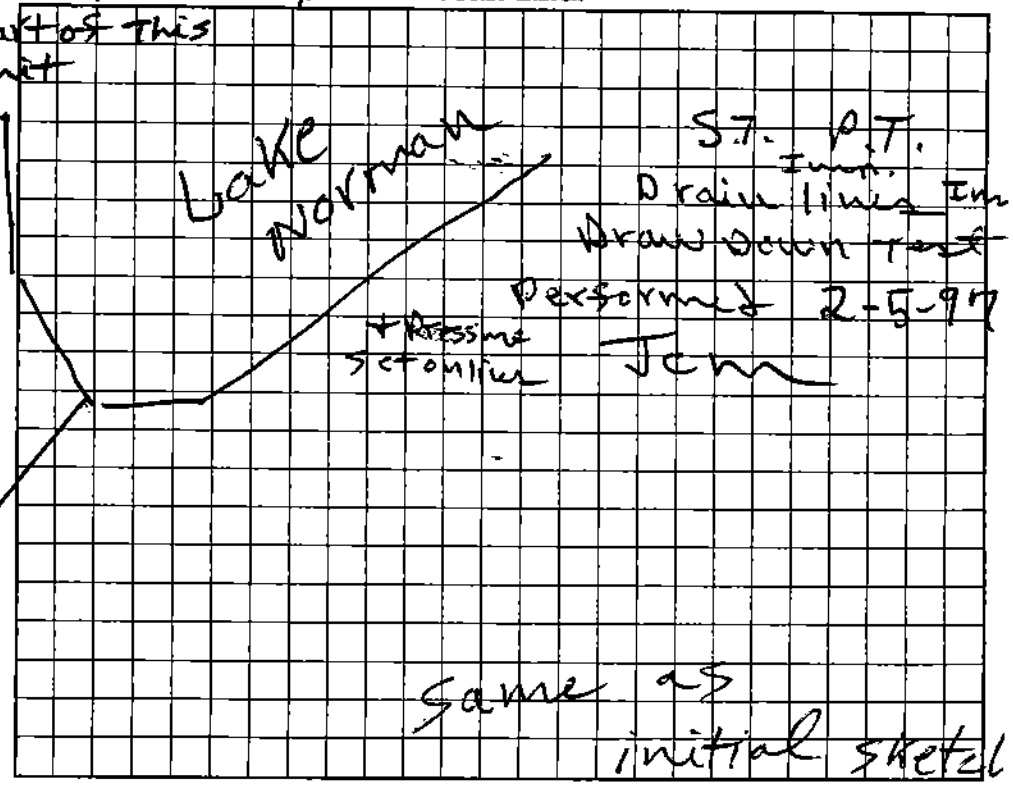

I understand that this permit can be suspended or revoked if any false information is supplied toward securing the permit/any unauthorized changes are made to the site/any unauthorized changes are made in the installation of the system.

Signed: Tony Gaskins CPSS (B) 10-2-96

Improvement Permit by: R.C. moore date 9-27-96

System Inspected by: R.C. moore date 9-27-96

Installed by: Tommy Cothren

Certificate of Completion by: date

Operation Permit by: R-C. moore date 2-20-97