THIS PERMIT REPLACES PREVIOUSLY ISSUED / EXPIRED PERMIT PH140-000201 01

IREDELL COUNTY HEALTH DEPARTMENT

STATESVILLE 704-878-5305 CI MOORESVILLE 704-664-5281

IMPROVEMENT PERMIT / AUTHORIZATION TO CONSTRUCT / OPERATION PERMIT / EXISTING SYSTEM INSPECTION

PERMIT# 100717 PIN# 462986 9263 DATE 6-11-01

OWNER OR CONTRACTOR DAVID STONE PHONE: Business 336-775-5005 Home 336-676-4406 ?

ADDRESS 1975 MEADOW GLEN LN WINSTON SALEM, NC 27127

LOCATION HWY 21 S, (E) PERTH, (R) STATE PARK, (L) MORRISON FARM, (L) DAYVAULT CUT, (R) STILLWATER, IMMED ON LEFT

SUBDIVISION CLOT BLOCK / SECTION LOT 882 LOT AREA 1.67 SITE CLASS PS DESIGN FLOW 360 L.T.A.R. .3

Septic Tank: 1000 Gallons: STB 354 Date 4-6-01
Pump Tank: 1000 Gallons: PT 313 Date 02-26-00
Pump Make: ZOELLER Model N140B Serial No M10-0002-0104
Nitrification Field: No Fields 1 Square Feet EQ=1200 Linear Feet 200'
No Lines 4 Trench Width 24" Max Trench Bottom Depth 36"

X New System ☐ Repair System Type: I, II, III, IV, V, VI
System Description: PUMP PANEL
Repair System Description: LP PANEL
Maintenance Agreement Required: ☐ Yes X No

X House/Mod. Home No. Bedrooms 3
☐ Mobile Home No. Bathrooms 2
☐ Business No. Employees
☐ Other


Gravel Depth N/A ☐ Slab ☐ Crawl Space X Basement w/plumbing ☐ Basement wo/plumbing

Water Supply: X Individual ☐ Public ☐ Community WELL


Comments/Conditions: ① INSTALL LINES ON CONTOUR ② USE Pressure Manifold. ③ MAINTAIN SET BACKS & KEEP TANKS out of washout starting 27' off house foundation

Comments/Conditions: POLYLOK FILTER WITH MARKER & CHECKED FIRST TWO LINES (LC) & TANKS NEEDS PRESSURE, LAST 2 LINES, & ELECTRICAL CHECKED LAST LINES CHECKED & PRESSURE SET LC 7-11-01 NEEDS ELECTRICAL

INITIAL SITE SKETCH "NOT TO SCALE"

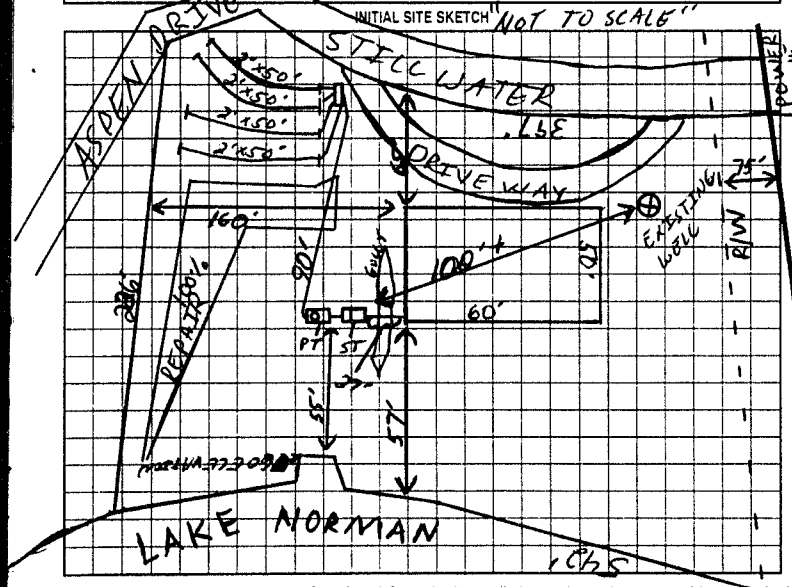

AS BUILT SKETCH

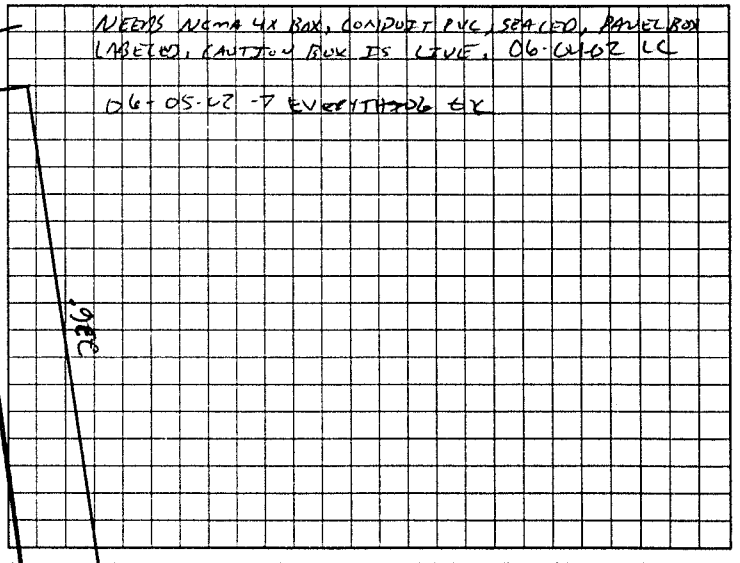

Permit can be suspended or revoked if any false information is supplied toward securing the permit/any unauthorized changes are made to the site/any unauthorized changes are made in the installation of the system. Improvement Permit with plat valid without expiration. Improvement Permit with site plan valid for sixty months. Authorization to Construct is valid for a period equal to that of Improvement Permit – not to exceed sixty months.

Signed: Mary Stone date 6-12-01 Installed by: G & M ENTERPRISES

Improvement Permit by: Jim Cook RSI date 6-11-01 Operation Permit by: Jim Cook RS date 06-05-02

Authorization to Construct by: Jim Cook RSI date 6-11-01 Existing System Inspection by: date

HEALTH DEPT. COPY WHITE OWNER COPY (FINAL) YELLOW OWNER COPY (INITIAL) PINK