THIS PERMIT VOIDS PERMIT ISSUED 8-13-12

IREDELL COUNTY HEALTH DEPARTMENT - *ENVIRONMENTAL HEALTH* ☐ STATESVILLE OFFICE 704-878-5305 ☐ MOORESVILLE OFFICE 704-664-5281

IMPROVEMENT PERMIT / AUTHORIZATION TO CONSTRUCT / OPERATION PERMIT / EXISTING SYSTEM INSPECTION

PERMIT # 175550 PIN # 4629880833 DATE 11-5-12

OWNER Edwin & Elizabeth Harris APPLICANT: PHONE: Home/Cell # 704-591-6584 Business #

SITE ADDRESS 146 Medford Ln. OWNER / APPLICANT ADDRESS

SITE DIRECTIONS Hwy 215 to (R) on Perth, (R) on State Park, (L) on Morrison Farm (R). on Medford, on R

SUBDIVISION CL & T BLOCK / SECTION 18 LOT # 102 LOT AREA .705 DESIGN FLOW 240 L.T.A.R. .4

Septic Tank 1000 Gallons: STB 760 Date 9-15-12 ☒ New System ☐ Repair ☐ Expansion System Type I II (III) IV V VI

Pump Tank Gallons: P T Date System Description: 50% Reduction Gravity

Pump Make Model Serial # Repair System Description: 25% Reduction Gravity

No. Nitrification Fields: 1 No. Lines 3 Linear Feet 100' Maintenance Agreement Required ☐ YES ☒ NO


Trench Width 24" Max. Trench Bottom Depth 36" Gravel Depth n/a ☒ GRAVITY ☐ PRESSURE

☒ Residence No. Bedrooms 2 ☐ Business No. Persons ☐ Other No. Employees ☐ Slab ☒ Crawl Space ☐ Basement w/plumbing ☐ Basement w/o plumbing

Water Supply: ☒ Private ☐ Public ☐ Community

Comments / Conditions Repair will require new tank to be set in area of system due to saprolite rules

INITIAL SITE SKETCH

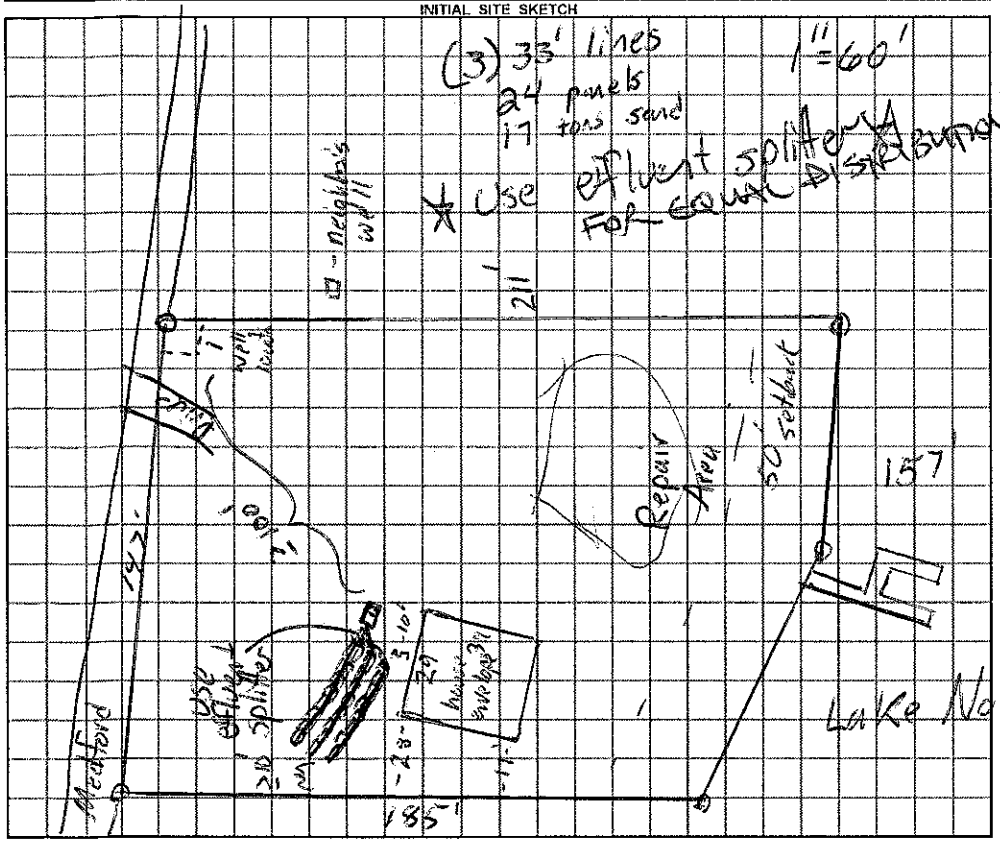

AS BUILT SKETCH

Permit can be suspended or revoked if any false information is supplied toward securing the permit / any unauthorized changes are made to the site / any unauthorized changes are made in the installation of the system.

☐ ***IMPROVEMENT PERMIT*** *with plat valid without expiration.* ☒ ***IMPROVEMENT PERMIT*** *with plat ~~valid without expiration~~ site plan valid 60 mo.* ☒ ***AUTHORIZATION TO CONSTRUCT*** valid for period equal to IMPROVEMENT PERMIT--not to exceed 60 mo.

Owner / Applicant Signature: Date 11-5-12 Installed by: A-1 Backhoe

IMPROVEMENT PERMIT by: REHS Date 11-5-12 OPERATION PERMIT by: REHS Date 1-23-13

AUTHORIZATION TO CONSTRUCT by: REHS Date 11-5-12 Existing System Inspected by: REHS Date

YOU SHOULD CONTACT A LOCATOR SERVICE PRIOR TO ANY EXCAVATION

White Copy -- Environmental Health YELLOW COPY (Final) Owner / Applicant PINK COPY (Initial) Owner / Applicant