IREDELL COUNTY HEALTH DEPARTMENT

STATESVILLE 704-878-5305 MOORESVILLE 704-664-5281

IMPROVEMENT PERMIT / AUTHORIZATION TO CONSTRUCT / OPERATION PERMIT / EXISTING SYSTEM INSPECTION

PERMIT# 94624 PIN# DATE 2/8/01

OWNER OR CONTRACTOR LILES SUDDRETH PHONE, Business Home (704) 875-8922

ADDRESS 14814 MIDDLETHORPE LANE, HUNTERSVILLE, NC 28078

LOCATION PERTH CH. RD. (E) STATE PARK (W) MORRISON FARM RD. (L) BUTTERNUT TO END

SUBDIVISION BLOCK / SECTION LOT LOT AREA .69Ac SITE CLASS PS DESIGN FLOW 430 L.T.A.R. .35

Septic Tank: 1000 Gallons. STB 1007 Date 3-01-01

Pump Tank: Gallons; PT Date

Pump Make: Model Serial No.

Nitrification Field: No Fields 1 Square Feet 430 Linear Feet 240'

No Lines 3' Trench Width 24" Max Trench Bottom Depth 36" Gravel Depth N/A

☑ New System ☐ Repair System Type: I, II, (III), IV, V, VI

System Description: GRAVITY PROPS

Repair System Description: PUMP PROPS

Maintenance Agreement Required: ☐ Yes ☑ No

☐ House/Mod. Home No. Bedrooms 4

☐ Mobile Home No. Bathrooms 3½

☐ Business No. Employees


☐ Other

☐ Slab ☐ Crawl Space ☑ Basement w/plumbing ☐ Basement wo/plumbing

Water Supply: ☑ Individual ☐ Public ☐ Community

Comments/Conditions: ① NO CUTTING OR FILLING OVER DRAINFIELD/REPAIR AREAS ② KEEP ALL DRAINS AWAY FROM DRAINFIELD/REPAIR AREAS ③ MAINTAIN SETBACKS ④ INSTALL DRAINTILES UNIFORM AND ON CONTOUR

INITIAL SITE SKETCH

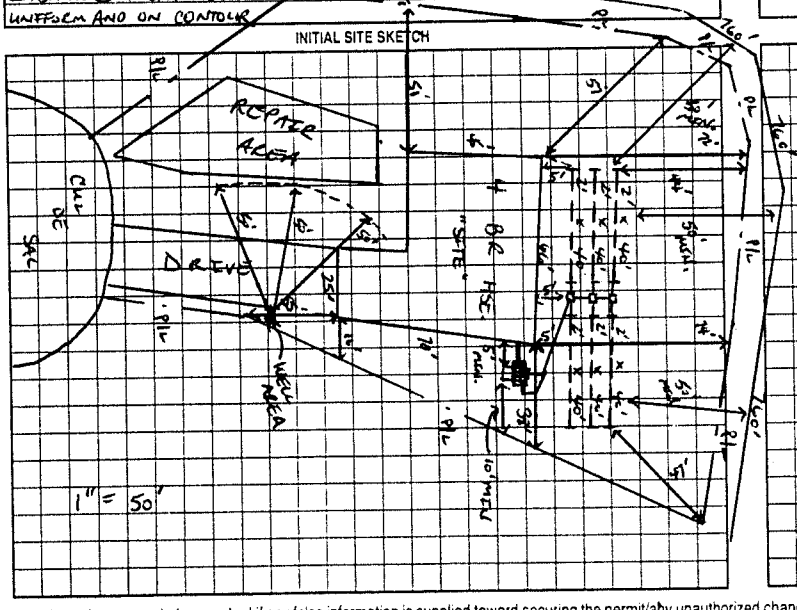

Comments/Conditions: ① SEPTIC TANK WITH RISERS INSTALLED USING "POLYLOK" FILTER ② SYSTEM INSTALLED DURING PERIOD OF WET WEATHER

AS BUILT SKETCH

SYSTEM INSTALLED ACCORDING TO INITAL SITE SKETCH (DEEP DUE TO STUBOUT)

Permit can be suspended or revoked if any false information is supplied toward securing the permit/any unauthorized changes are made to the site/any unauthorized changes are made in the installation of the system. Improvement Permit with plat valid without expiration. Improvement Permit with site plan valid for sixty months. Authorization to Construct is valid for a period equal to that of Improvement Permit – not to exceed sixty months.

Signed: date

Improvement Permit by: date 2/8/01

Authorization to Construct by: date 2/8/01

Installed by: JAMES HUBLER

Operation Permit by: STEVE HERRICK date 7-16-01

Existing System Inspection by: date

HEALTH DEPT. COPY: WHITE OWNER COPY (FINAL): YELLOW OWNER COPY (INITIAL): PINK