ICHD - ENVIRONMENTAL HEALTH DIVISION

Statesville Office (704) 878-5305 Mooresville Office (704) 660-3625 PERMIT # AP 2022-9835

SEPTIC: IMPROVEMENT PERMIT / AUTHORIZATION TO CONSTRUCT / OPERATION PERMIT / EXISTING SYSTEM

PIN # 4629 -- 94 -- 0407

APPLICANT/OWNER: Joseph Brawder APPLICANT ADDRESS: 507 Stillwater Rd, Troutman

SITE ADDRESS: 507 Stillwater Rd, Troutman 28166 PHONE: 704-430-0044 ALT. PHONE –

SITE DIRECTIONS: State Farm - Morrison Farm - Daywalt Cut - Stillwater SAP CONTROLLED: ☐ YES ☐ NO


SUBDIVISION: CL&T SECTION: 17 LOT # 61 LOT AREA: 0.83 acres DESIGN FLOW: EX L.T.A.R.: EX

Septic Tank	1000 (gal)	STB 760	Date 10-11-22	☐ New System	☒ Repair	☐ Expansion	System Type: I (II) III IV V VI	☒ Residence	No. Bedrooms EX
Pump Tank	(gal)	PT	Date	System Description:	Tank Replacement			☐ Business	No. Persons EX
Pump Make	Model		Serial #	Repair System Description:	EXISTING			☐ Other	No. Employees
# Nitrification Fields	EX # Lines EX		Linear Ft EX	Maintenance Agreement Required:	☐ YES	☒ NO		☒ Slab	☐ Crawl Space
Trench Width	EX Trench Bottom Depth(Low side) EX		Gravel Depth EX	☒ GRAVITY	☐ PRESSURE			☐ Basement w/ plumbing	☐ Basement w/o plumbing

Water Supply: ☐ Private ☒ Public ☐ Community


Comments / Conditions: Pump, crush, & fill old septic tank. Replace D-box if necessary.

INITIAL SITE SKETCH

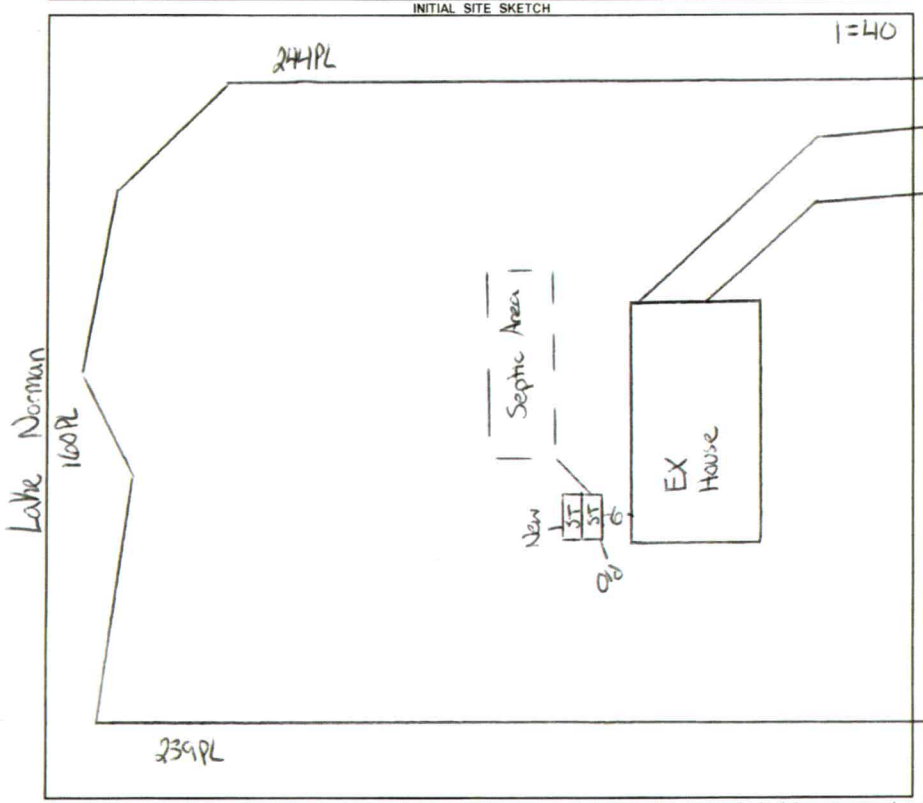

AS BUILT SKETCH

FOR SEPTIC FINAL INSPECTION CALL: 704-664-3703 between 8am-9am the day the inspection is needed. Be sure to speak with an inspector to confirm your time.

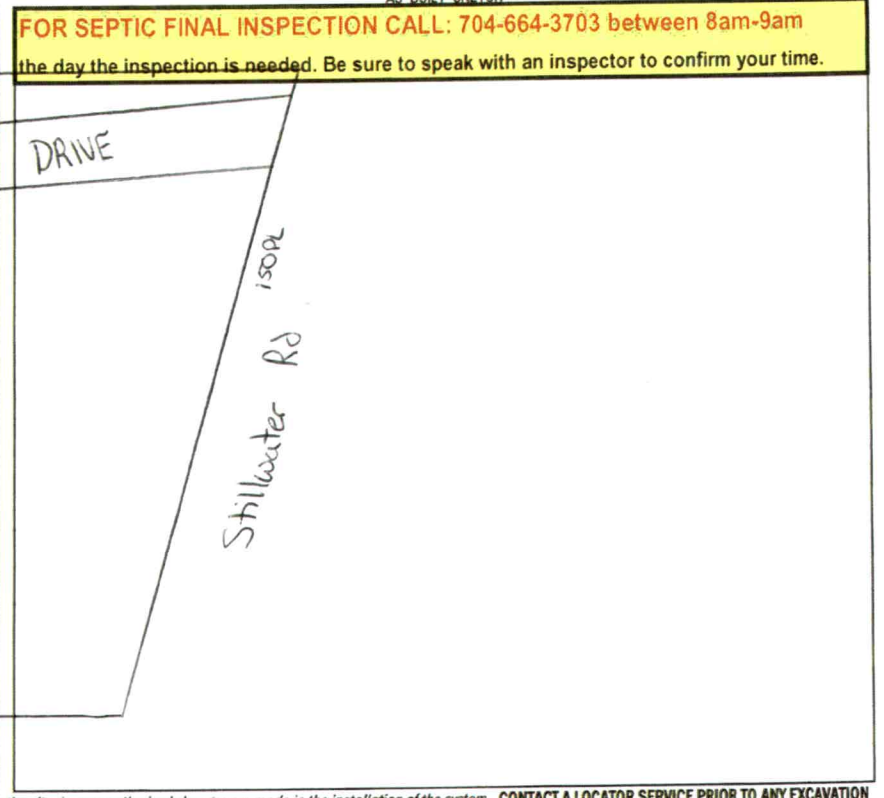

Permit can be suspended or revoked if any false information is supplied toward securing the permit / any unauthorized changes are made to the site / any unauthorized changes are made in the installation of the system. **CONTACT A LOCATOR SERVICE PRIOR TO ANY EXCAVATION**

☐ **IMPROVEMENT PERMIT** ***with plat*** *valid without expiration.* ☒ **IMPROVEMENT PERMIT** ***with site plan*** *valid for 60 mos.* ☒ **AUTHORIZATION TO CONSTRUCT** *valid for period equal to IMPROVEMENT PERMIT--not to exceed 60 mo.*

Owner / Applicant Signature: Date: Installed by: Lentz Wastewater

IMPROVEMENT PERMIT by: Cary Whit Date: 12/1/22 OPERATION PERMIT by: Matt Wi Date: 12/12/22

AUTHORIZATION TO CONSTRUCT by: Cary Whit Date: 12/1/22 Existing System Inspected by: Date:

FOR SEPTIC FINAL INSPECTION: CALL 704-664-3703 between 8am-9am the day the inspection is needed.

Item	Date	Initials
Drain Lines Checked		
Tanks Checked		
Pressure Manifold or Valve Box Checked		
Pressure Head Set		
Electrical Checked		
Floats Set		
Alarm Checked		
Maintenance Contract Needed? Y / N		
Comments:		

Repairs Only	
	State Code
Failing System Code	
Type of Distribution	G or P
Type of Failure/Malfunction	
Primary Cause of Failure/Malfunction	
Age of System? _____	
Initial or Repair? _____	