IREDELL COUNTY HEALTH DEPARTMENT

Statesville Office (704) 878-5305 Mooresville Office (704) 660-3625 PERMIT # 204611

IMPROVEMENT PERMIT / AUTHORIZATION TO CONSTRUCT / OPERATION PERMIT / EXISTING SYSTEM

PIN # 4629940845

APPLICANT: Live Well Homes APPLICANT ADDRESS: 310 Springcrest Dr. Fort Mill

SITE ADDRESS: 512 Stillwater Rd. PHONE: 704-662-9845 ALT. PHONE: N/A

SITE DIRECTIONS: Perth Rd. to State Park Rd TL Morrison Farm Rd TL Stillwater Rd.

SUBDIVISION: Falls Park SECTION: 2 LOT # 16 LOT AREA: 1.01 acres DESIGN FLOW: 600 gpd L.T.A.R.: 0.275

Septic Tank 1500 (gal) STB 1628-1590 Date 8-12-14

Pump Tank 1500 (gal) PT 485 Date 4-11-15

Pump Make Myers Model MF-150 Serial # 4006589

Nitrification Fields 1 # Lines 5 Linear Ft: 545

Trench Width 36" Max. Trench Bottom Depth 24" on low side Gravel Depth N/A

☑ New System ☐ Repair ☐ Expansion System Type: I II (III) IV V VI

System Description: 25% Reduction

Repair System Description: 50% Reduction

Maintenance Agreement Required: ☐ YES ☑ NO ☐ GRAVITY ☑ PRESSURE

☑ Residence ☐ Business ☐ Other ☐ Slab ☐ Basement w/plumbing

No. Bedrooms 5 No. Persons 10 No. Employees ____ ☑ Crawl Space ☐ Basement w/o plumbing

Water Supply: ☐ Private ☑ Public ☐ Community

Comments / Conditions:

INITIAL SITE SKETCH

See attached Plan by:
Toney Jacobs, LSS +
Kathleen Saunders, LSS

AS BUILT SKETCH

- Yellow Tuf-Nite filter installed
- Quick 4 chambers installed
- Installed as drawn

	Date	Initials
Drain Lines Checked	6-24-15	JH
Tanks Checked	6-24-15	JH
Pressure Manifold or Valve Box Checked	6-24-15	JH
Pressure Head Set	7-14-15	JH
Electrical Checked	7-14-15	JH
Floats Set	7-14-15	JH
Alarm Checked	7-14-15	JH
Maintenance Contract Y / N	N/A	

✓ 1st 4 lines 6-18-15 JH

Permit can be suspended or revoked if any false information is supplied toward securing the permit / any unauthorized changes are made to the site / any unauthorized changes are made in the installation or the system. **CONTACT A LOCATOR SERVICE PRIOR TO ANY EXCAVATION**

☐ **IMPROVEMENT PERMIT** *with plat valid without expiration.* ☐ **IMPROVEMENT PERMIT** *with site plan valid for 60 mos.* ☐ **AUTHORIZATION TO CONSTRUCT** *valid for period equal to IMPROVEMENT PERMIT--not to exceed 60 mo.*

Owner / Applicant Signature: [signature] Date: 6/24/15 Installed by: Steve Jordan

IMPROVEMENT PERMIT by: Justin Henderson Date: 2-26-15 OPERATION PERMIT by: Justin Henderson Date: 7-14-15

AUTHORIZATION TO CONSTRUCT by: Justin Henderson Date: 2-26-15 Existing System Inspected by: ____ Date: ____


Health Dept. Copy - WHITE Applicant (Final Approval) - YELLOW Applicant (Conditional Approval) - PINK

VICINITY MAP
Not To Scale

NOW OR FORMERLY
PORTION OF 4629853541
FUTURE DEVELOPMENT
PHASE I
DB 22657-411

LINE TABLE		
LINE	LENGTH	BEARING
L1	26.10	N58°24'03"W

CURVE TABLE				
CURVE	BEARING	CHORD	LENGTH	RADIUS
C1	N56°46'38"W	115.96	115.97	2412.53

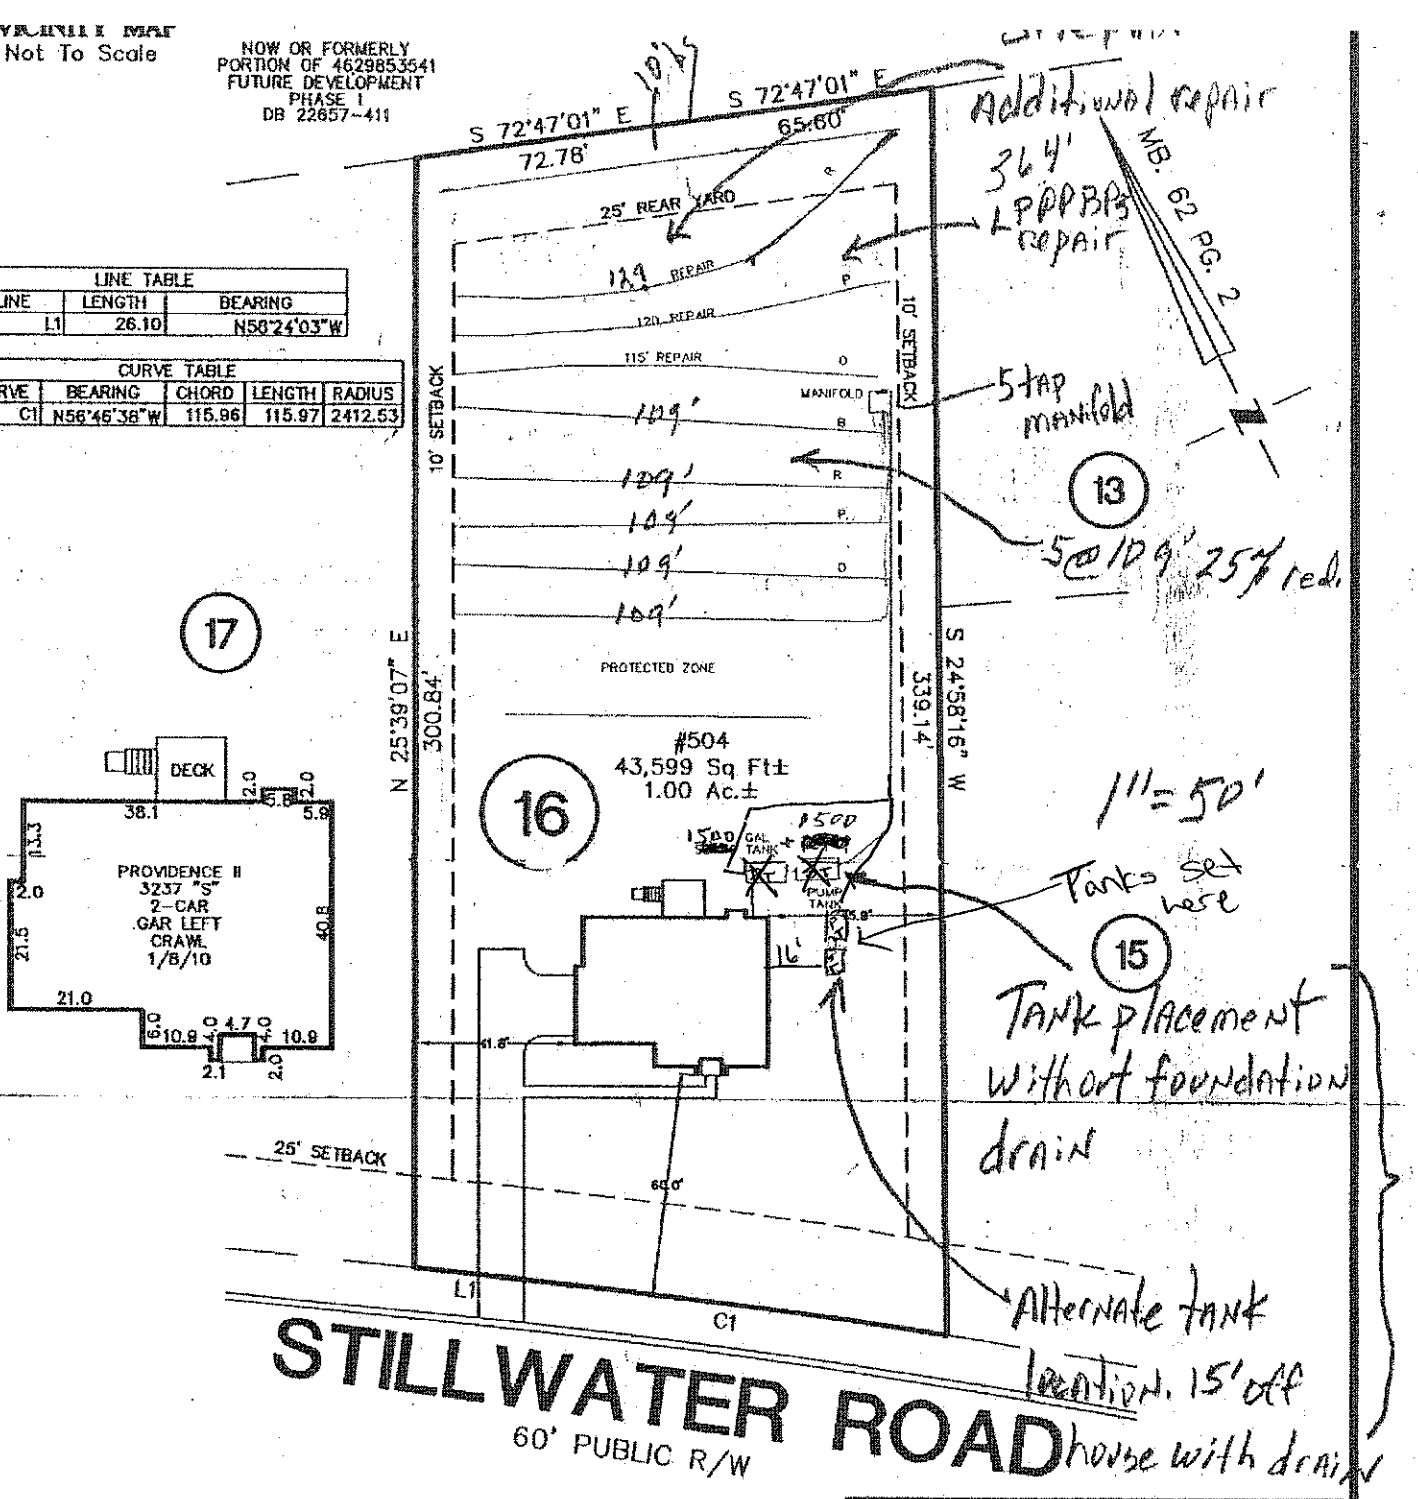

THIS PROPERTY MAY BE SUBJECT TO ANY AND ALL APPLICABLE DEED RESTRICTIONS, EASEMENTS, RIGHT-OF-WAY, UTILITIES AND RESTRICTIVE COVENANTS WHICH MAY BE OF RECORD OR IMPLIED

THIS DRAWING DOES NOT REFLECT AS-BUILT INFORMATION

PRELIMINARY PLAT
NOT FOR RECORDATION, CONVEYANCES, OR SALES

50 0 50
SCALE: 1" = 50'

EASTOVER
LAND SURVEYING COMPANY, P.A.
LAND SURVEYORS - PLANNERS
10430 PARK ROAD, SUITE #300
CHARLOTTE, NORTH CAROLINA 28210
PHONE (704) 927-8080
FAX (704) 889-0105

HOUSE LOCATION PLOT PLAN
FOR

LOT 16, FALL'S PARK SUBDIVISION, PHASE 2
Iredell County, North Carolina

PROPERTY OF: LIVEWELL HOMES
MAP BOOK 62 PAGE 2 DEED REFERENCE

DRAWN BY: ERG | DATE: FEBRUARY 12, 2015